

587000 yds E

953000 yds 2000 ft N

587000 yds 1000 ft E

587000 yds 2000 ft E

588000 yds E

953000 yds 1000 ft N

953000 yds 1000 ft N

953000 yds N



953000 yds. N

587000 yds E

587000 yds 1000 ft E

587000 yds 2000 ft E

588000 yds E

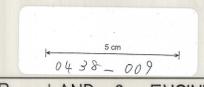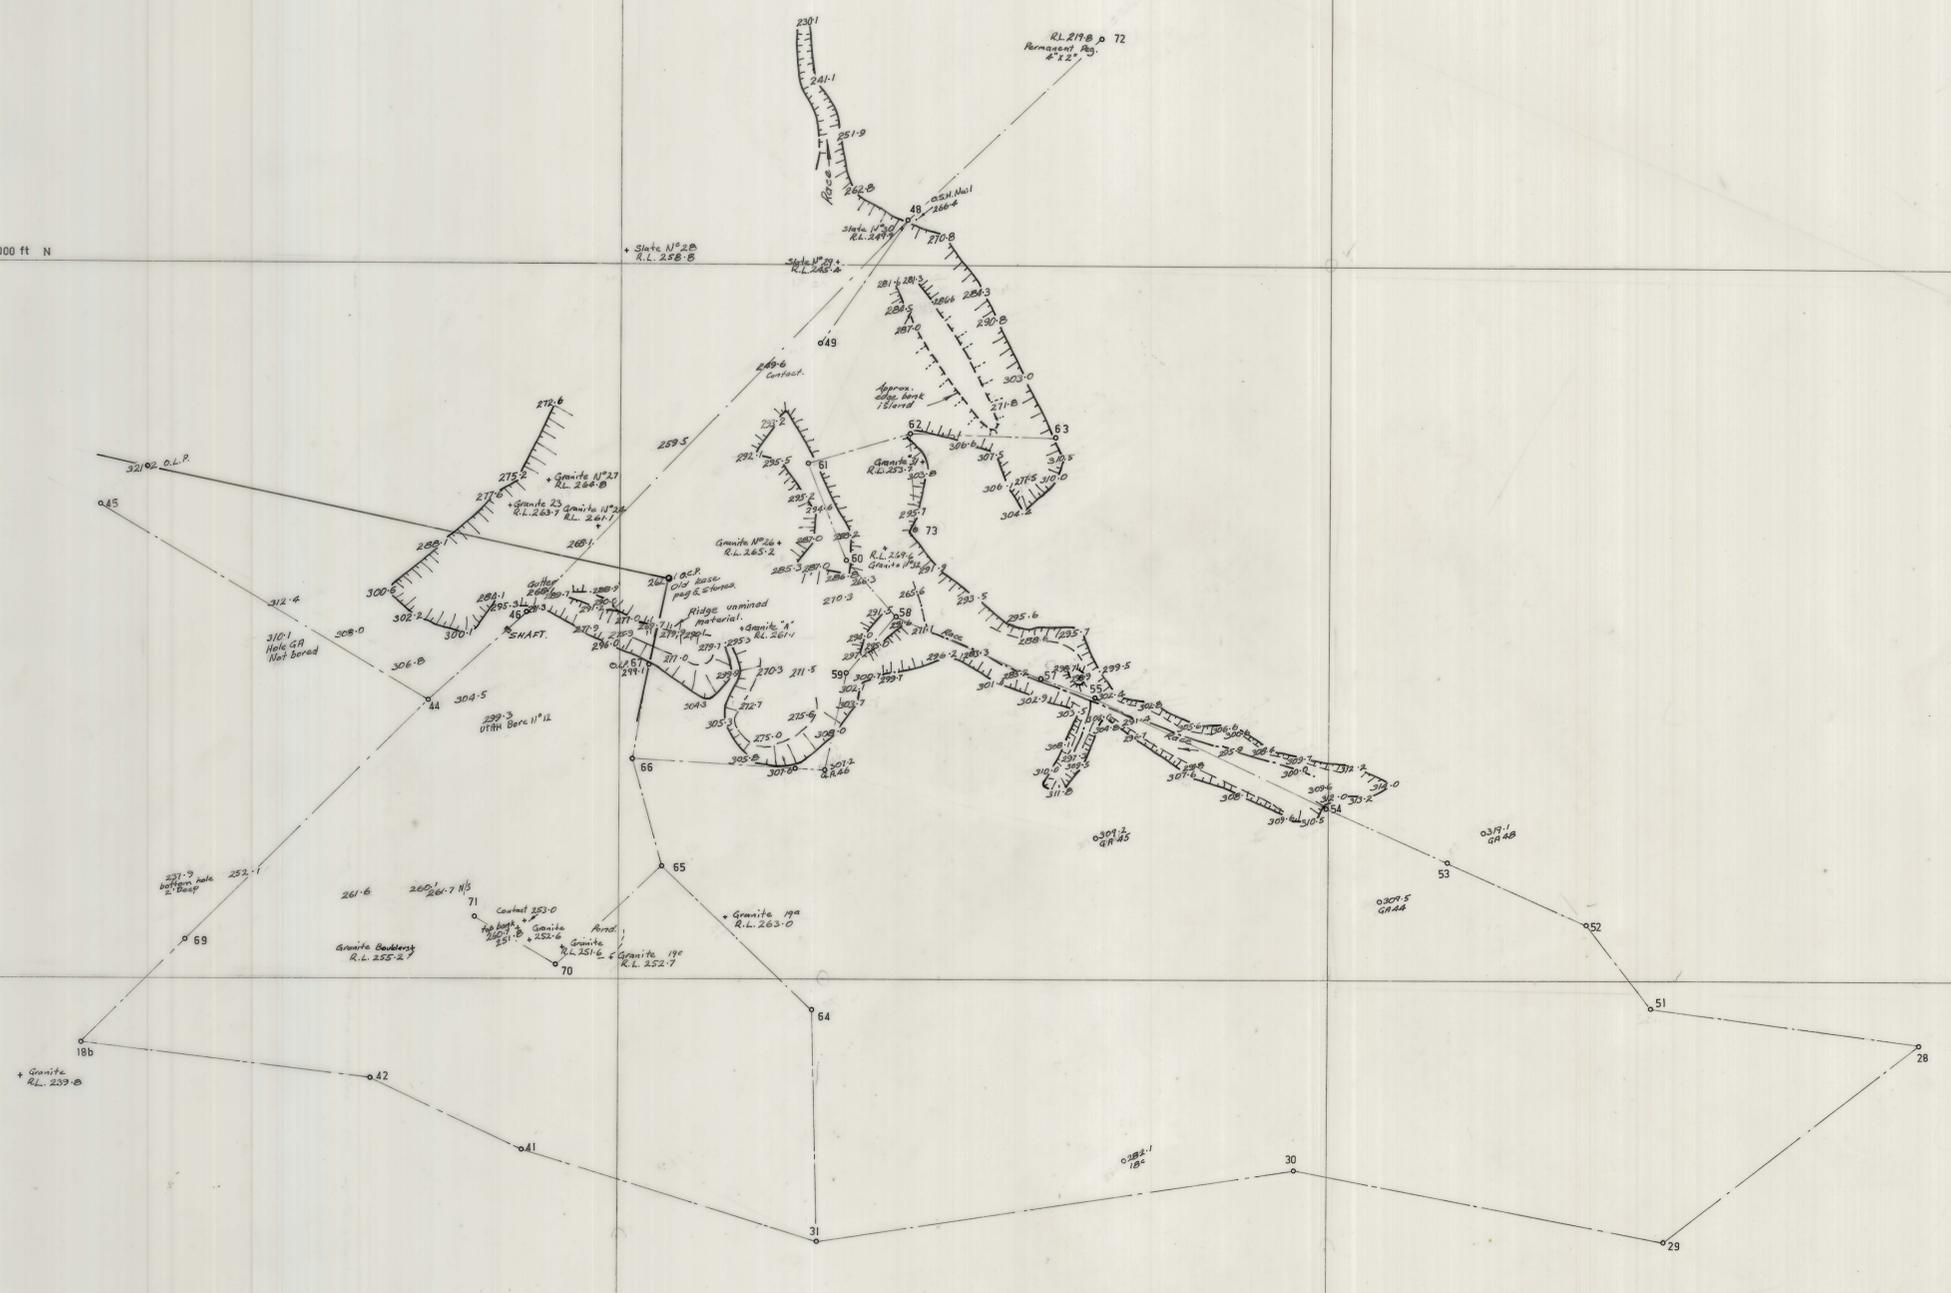

S.B 25 Pgs. 1-14
 18-23
 S.B 20 Pgs. 12-23

G.I. FISHER LAND & ENGINEERING SURVEYOR, LAUNCESTON PHONE 314207			
B.M.I. MINING PTY. LTD. GARFIELD MINE DETAIL PLAN			
 REGISTERED SURVEYOR	SCALE	100 Feet to 1 Inch.	NO. 8/36
	DRAWN	J. A. W.	
	DATE	14-12-1972	

600-8570