


0439-002

AMBER HILL

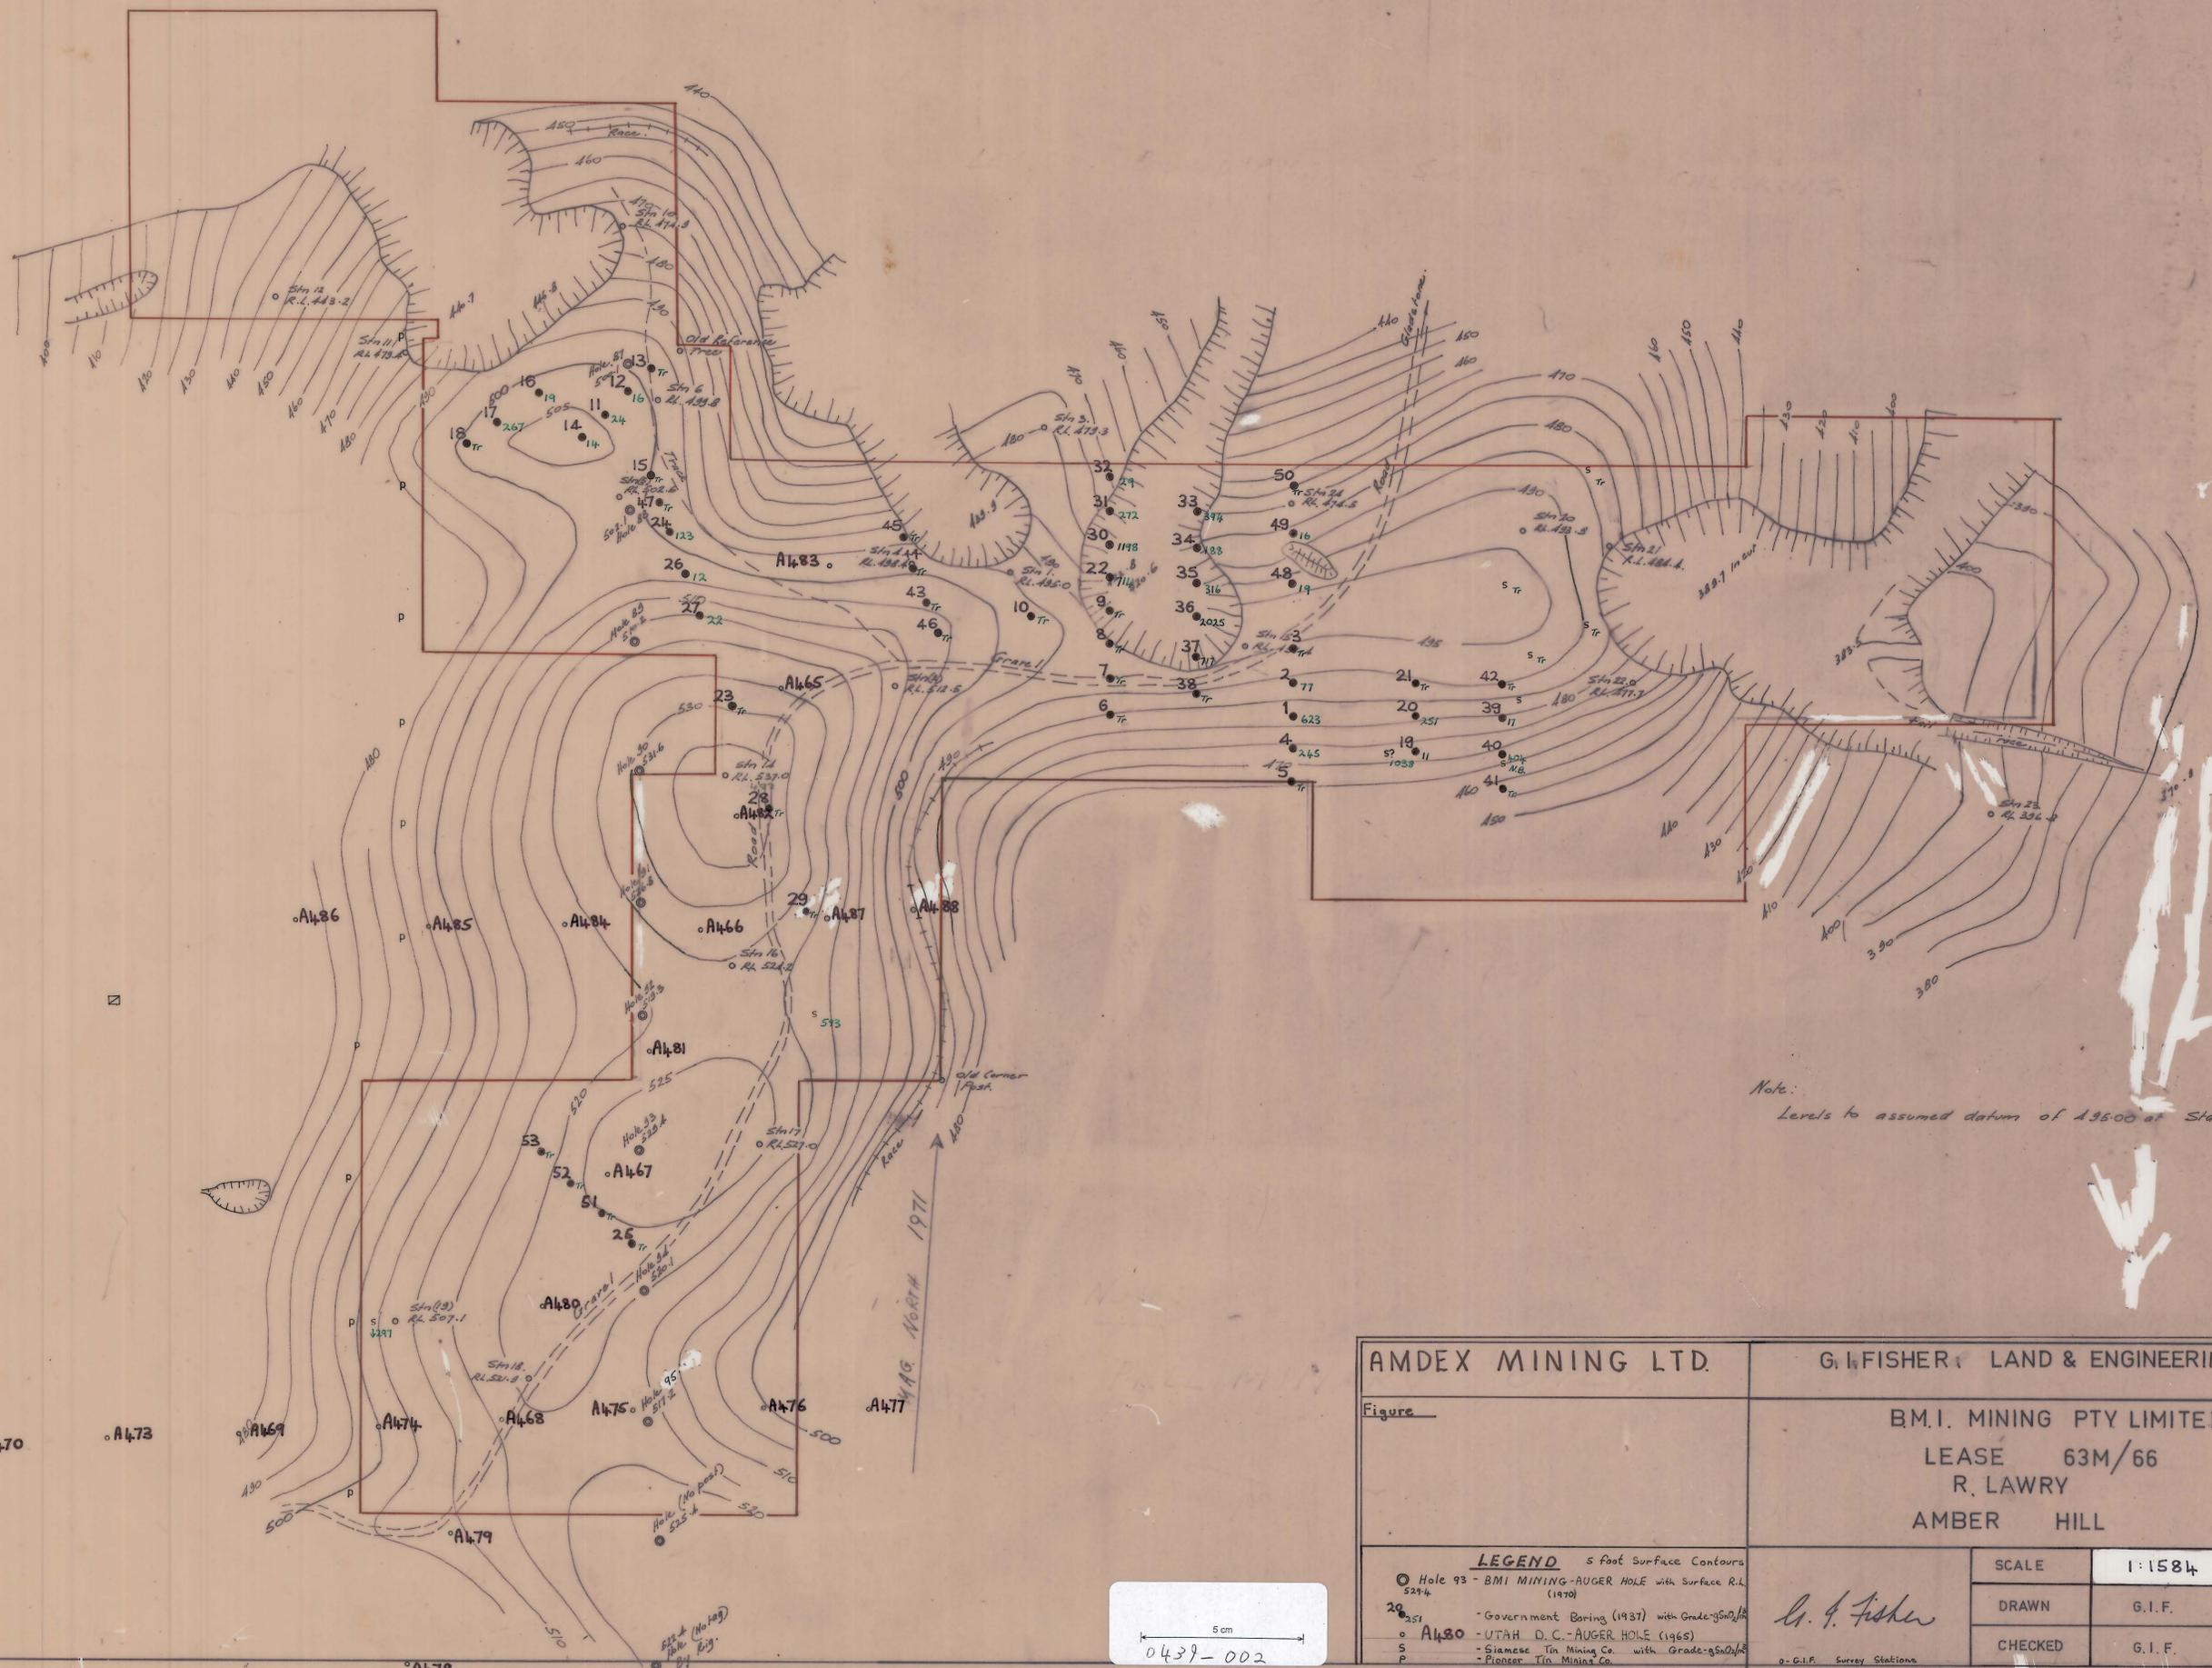

Note: Levels to assumed datum of 19500 at Station 1.

AMDEX MINING LTD.		G. I. FISHER, LAND & ENGINEERING SURVEYOR	
Figure		B.M.I. MINING PTY LIMITED LEASE 63M/66 R. LAWRY AMBER HILL	
<b>LEGEND</b> <ul style="list-style-type: none"> <li>○ Hole 93 - BMI MINING-AUGER HOLE with Surface R.L. 5294 (1970)</li> <li>○ 20 351 - Government Boring (1937) with Grade of 520.12</li> <li>○ A430 - UTAH D.C. - AUGER HOLE (1965)</li> <li>S - Siamese Tin Mining Co. with Grade of 520.12</li> <li>P - Pioneer Tin Mining Co.</li> </ul>		SCALE 1:1584	Additions by R. Munro - July 1980 for Amdex Mining Ltd.
DRAWN <i>G. I. Fisher</i>		G. I. F.	
CHECKED		G. I. F.	

