


0442-004

14/8/1973



0442-004

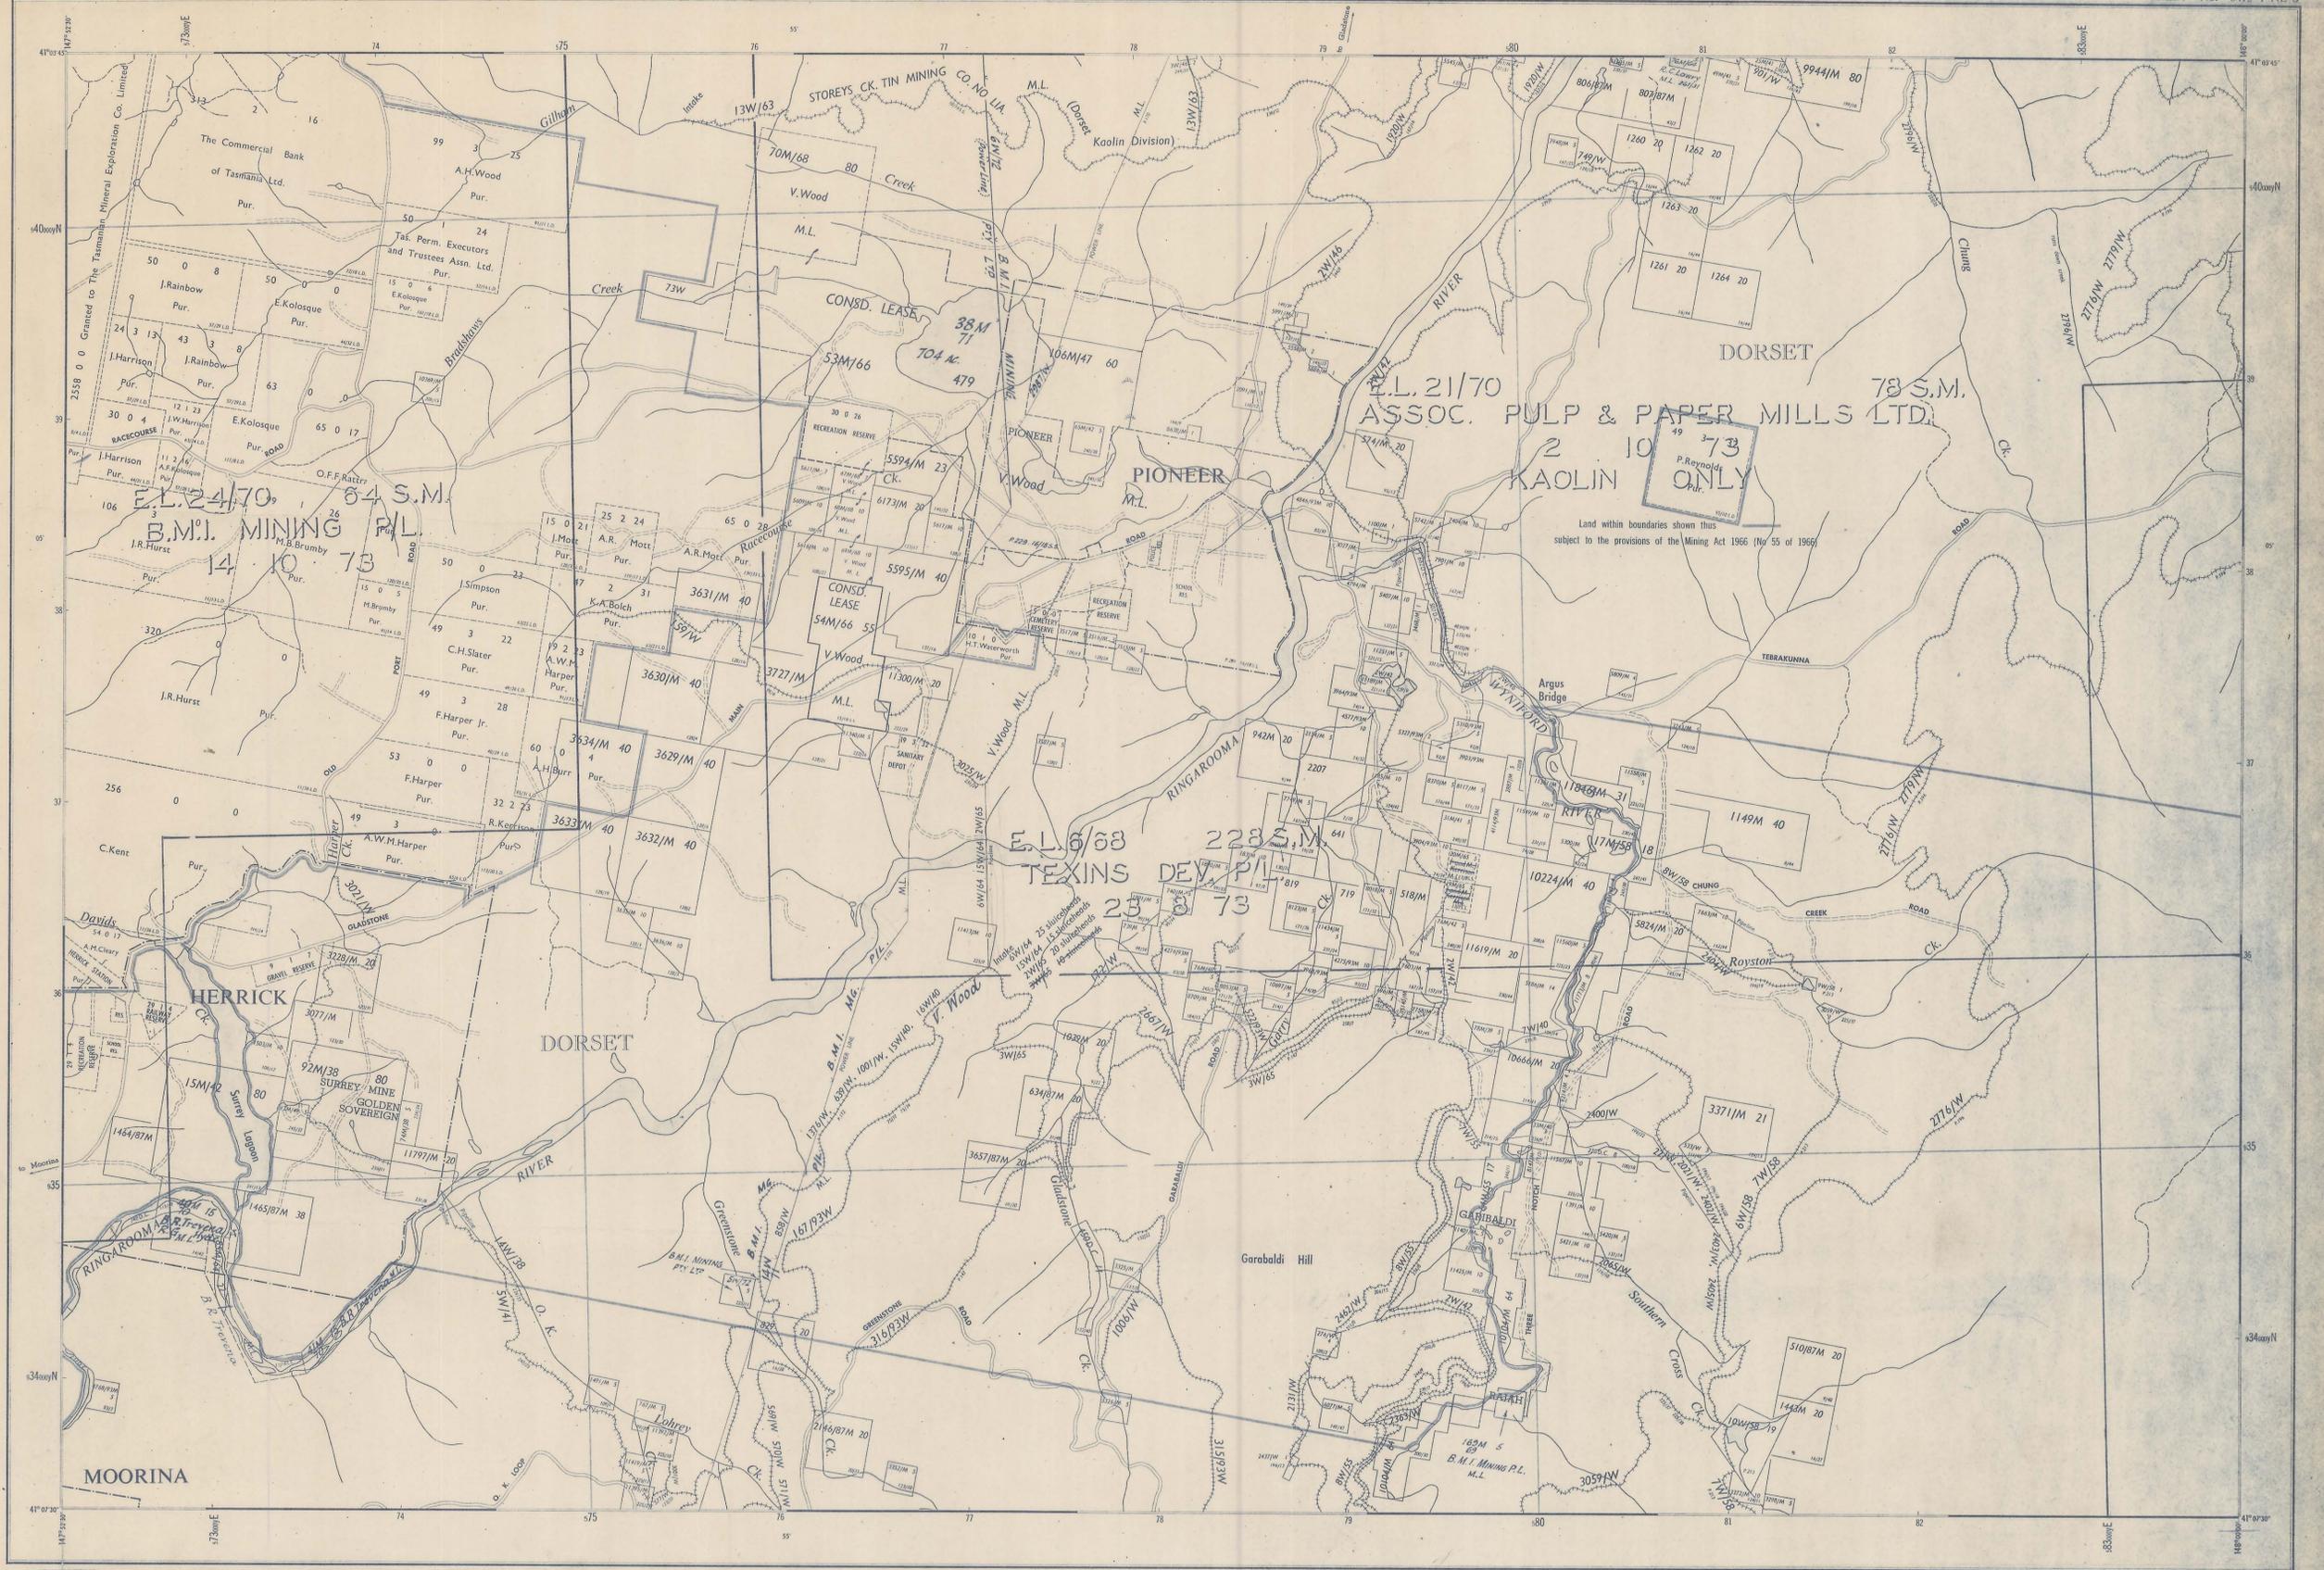

SCALE 20 CHAINS TO 1 INCH



DETAIL - NOMENCLATURE - PROJECTION - LEVEL DATUM - CONTROL -

Aerial Photography, 1965.
Approved by the Nomenclature Board of Tasmania.
Transverse Mercator.
Mean Sea Level at Hobart.
2nd and 3rd order triangulation based on
Lichfield Monument Station.
Lat. 41° 30' 23.88" S. Long. 141° 17' 49.22" E.
Based on datum 1467'00" E.
Origin is 400,000 yards West and 1,800,000 yards
South of the True Origin of Zone 7.

- Road Surface.....
- Vehicular Track.....
- Track.....
- Embankment, Cutting.....
- Railway Single Track.....
- Light Railway or Tram.....
- Waterfall, Rapid.....
- Swamp or Marsh.....
- Town Boundary.....

Mineral Lease Application No. 10619/M
Area in Acres 79
Subject to Survey Line.....
Survey Line.....
Survey Area: Acres, Roads, Perches..... 50 2 34
Survey Diagram Reference..... 86/13
Mine Name..... GRAND PRIZE
Land District Name..... DORSET
Water Race.....

The representation of a boundary or other cadastral information on this map does not constitute evidence of its existence or location.
The representation of a road or track on this map is no evidence of the existence of a right of way.

INDEX TO ADJOINING SHEETS

WINNALEAH	FRASER
IN 2N	IN
WINNALEAH	FRASER
IN 2S	IN
IN 2E	GOULDS COUNTRY IN

SHEET SUBDIVISION OF THE NATIONAL INDEX

N	NW	NE
IV	N	NE
S	SW	SE
III	S	SE

Magnetic Variation from True North for the centre of this sheet is approximately 12°48' E. 1965.
G.N.T.R. M.N.
Annual Change about 48'



Crown Copyright Reserved

14 AUG 1973 BROUGHT UP TO DATE WITH MINING INFORMATION ONLY