


1/7/1971


0442-006

5

MINERAL CHART WINNALEAH 2 SOUTH

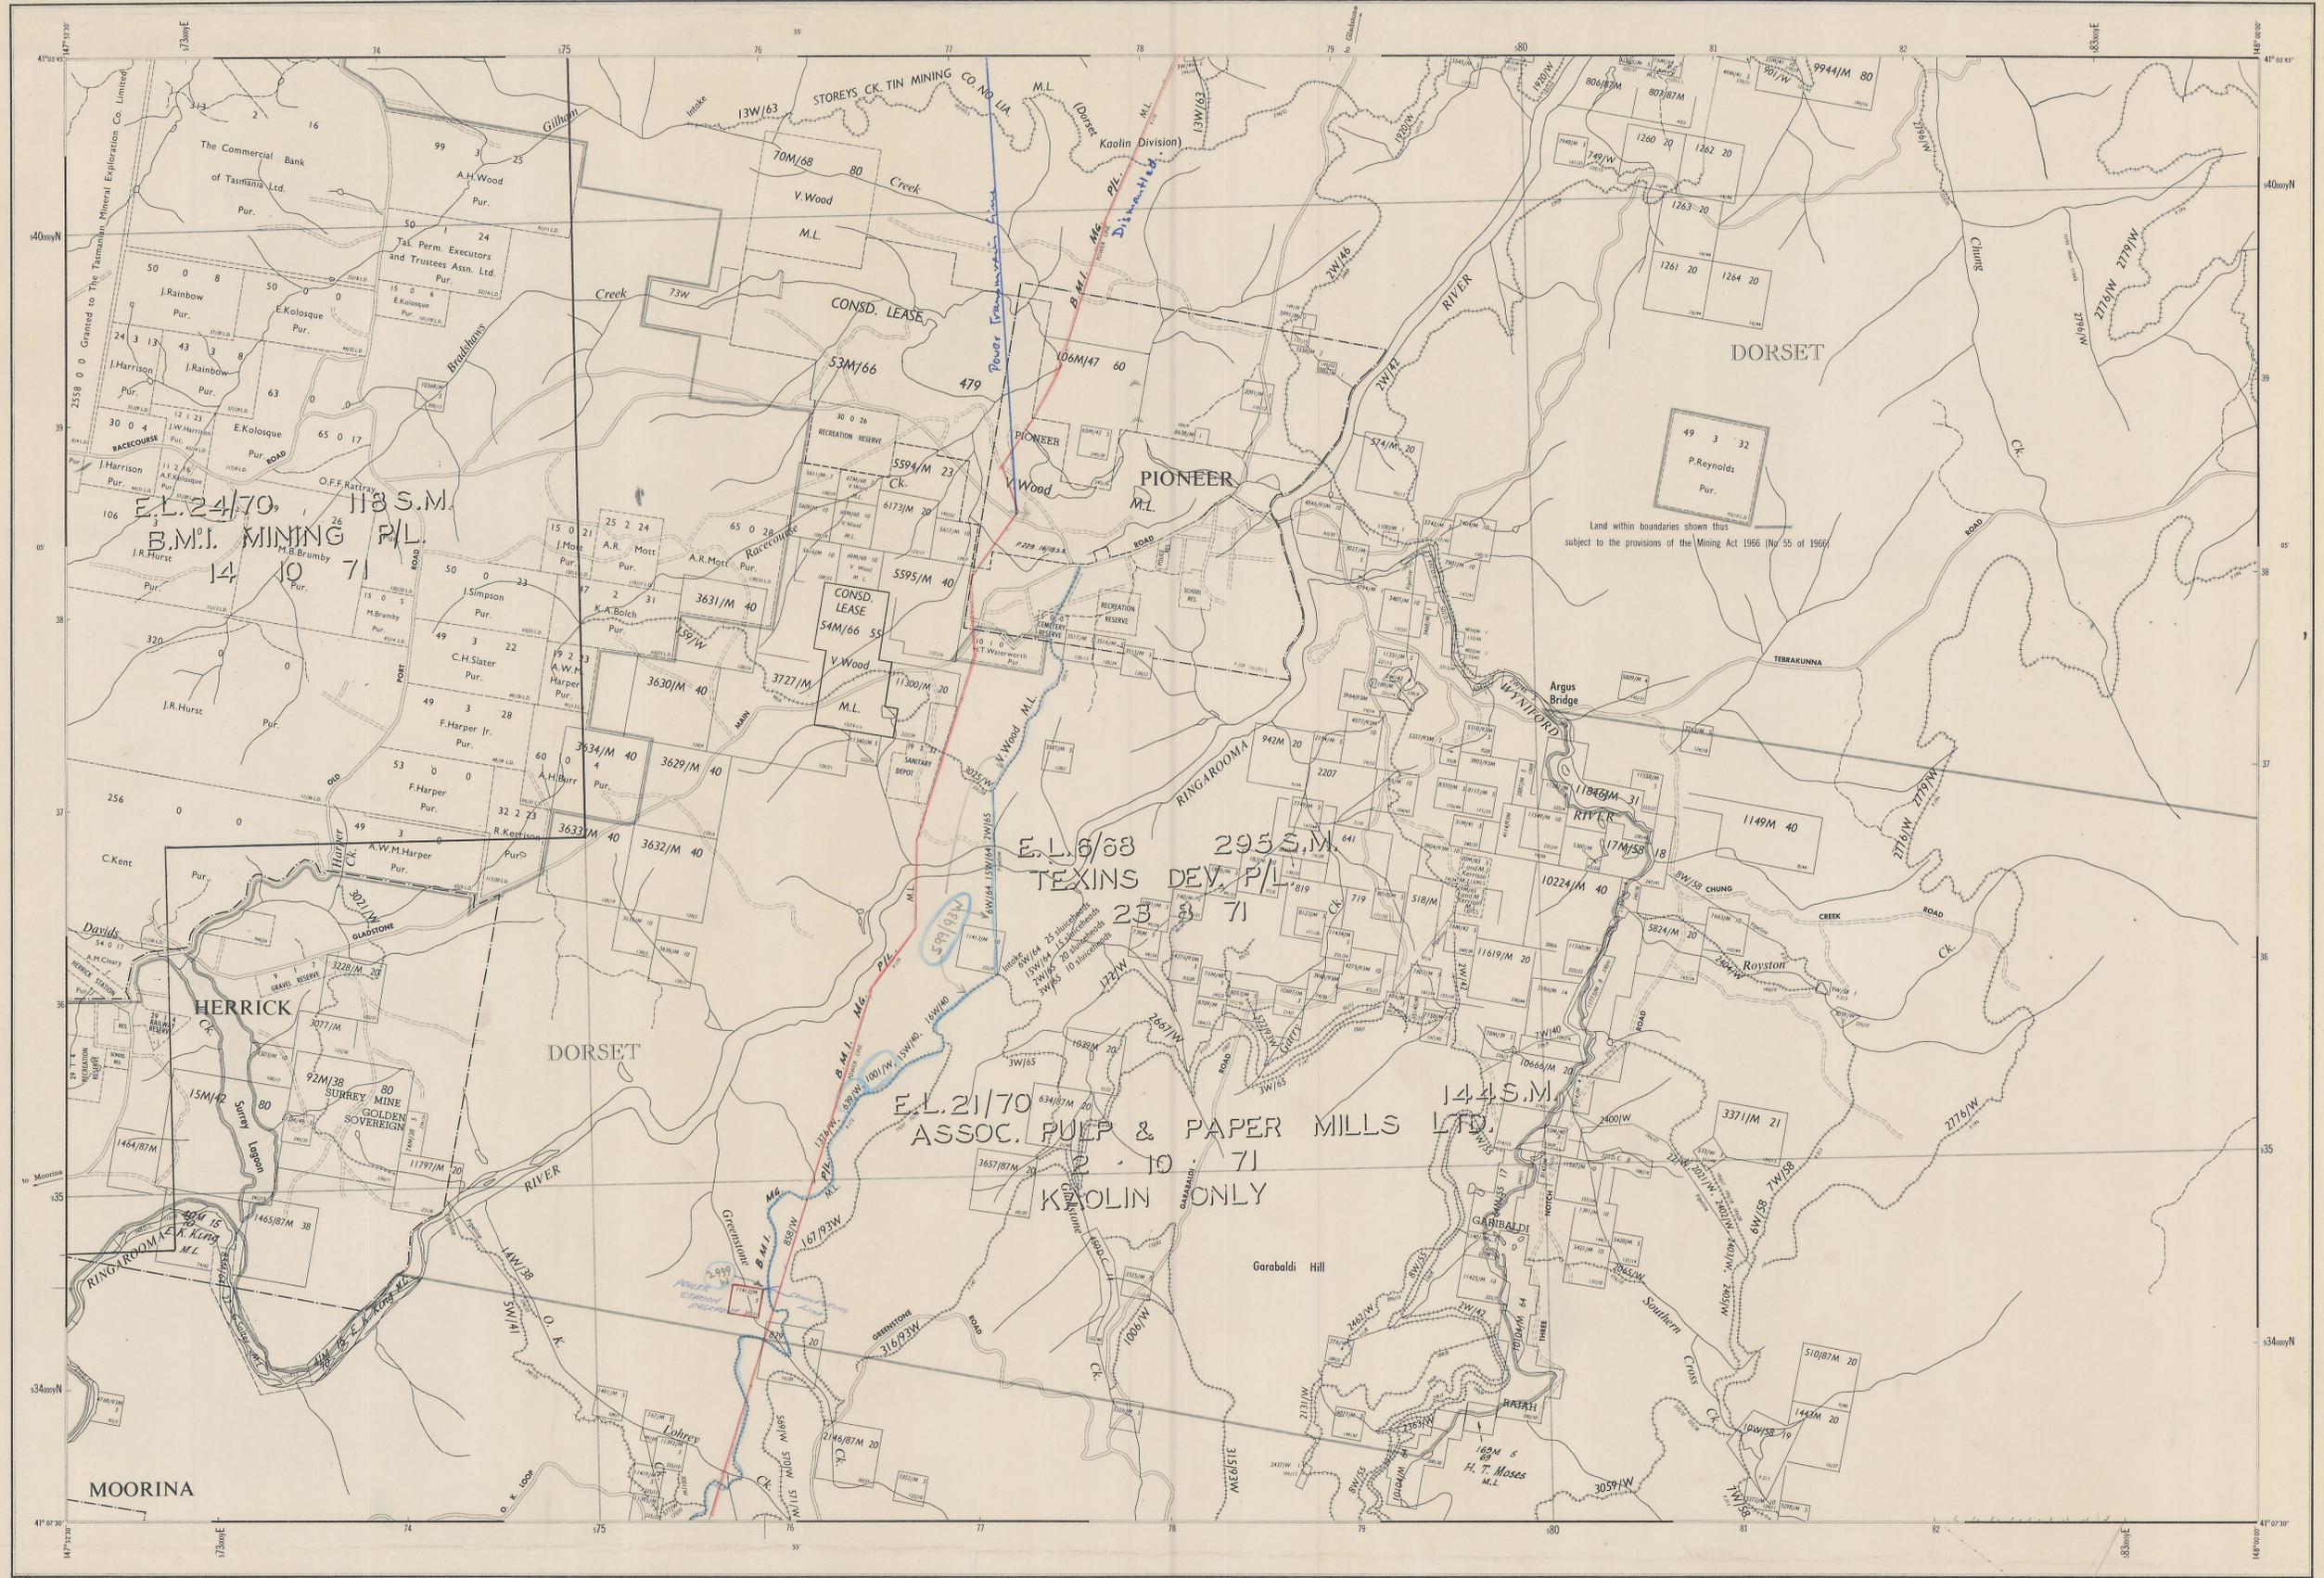

0442-006

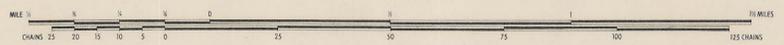

SCALE 20 CHAINS TO 1 INCH



Aerial Photography 1965.
 Approved by the Nomenclature Board of Tasmania.
 Nomenclature - Transverse Mercator
 Projection - Mean Sea Level at Highest
 Level Datum - 2nd and 3rd order Transposition based on
 Control - Lockhart Abolition Station
 Grid Convergence - Based on Long. 146° 00' E
 CO-ORDINATES - Chart is 400,000 yards West and 1,800,000 yards
 South of the True Origin of Zone 7.

- Road Surfaced.....
- Vehicular Track.....
- Track.....
- Embankment, Cutting.....
- Railway Single Track.....
- Light Railway or Tram.....
- Waterfall, Rapid.....
- Swamp or Marsh.....
- Town Boundary.....

Mineral Lease Application No. 10619/M
 Area in Acres 79
 Subject to Survey Line.....
 Survey Areas: Acres: Roads, Perches..... 50 2 34
 Survey Diagram Reference..... 86/13
 Mine Name..... GRAND PRIZE
 Land District Name..... DORSET
 Water Race.....

The representation of a boundary or other cadastral information on this map does not constitute evidence of its existence or location.
 The representation of a road or track on this map is no evidence of the existence of a right of way.

Produced by the LANDS AND SURVEYS DEPARTMENT, Hobart, Tasmania, 1969

INDEX TO ADJOINING SHEETS

WINNALEAH IN 1 2N	FRASER IN
WINNALEAH IS 2S	FRASER IS
DURBY IN 2N	GODDARD IN

SHEET SUBDIVISION OF THE NATIONAL INDEX

N	NW	N
IV	N-NE	I-3
S	SW	SE
III	S-II	S
X	X	X

Magnetic Variation from True North for the centre of this sheet is approximately 12° 48' E. 1965.
 G.M.T.N. M.N.
 Annual Change about -45'



Crown Copyright Reserved - 1 JUL 1971