
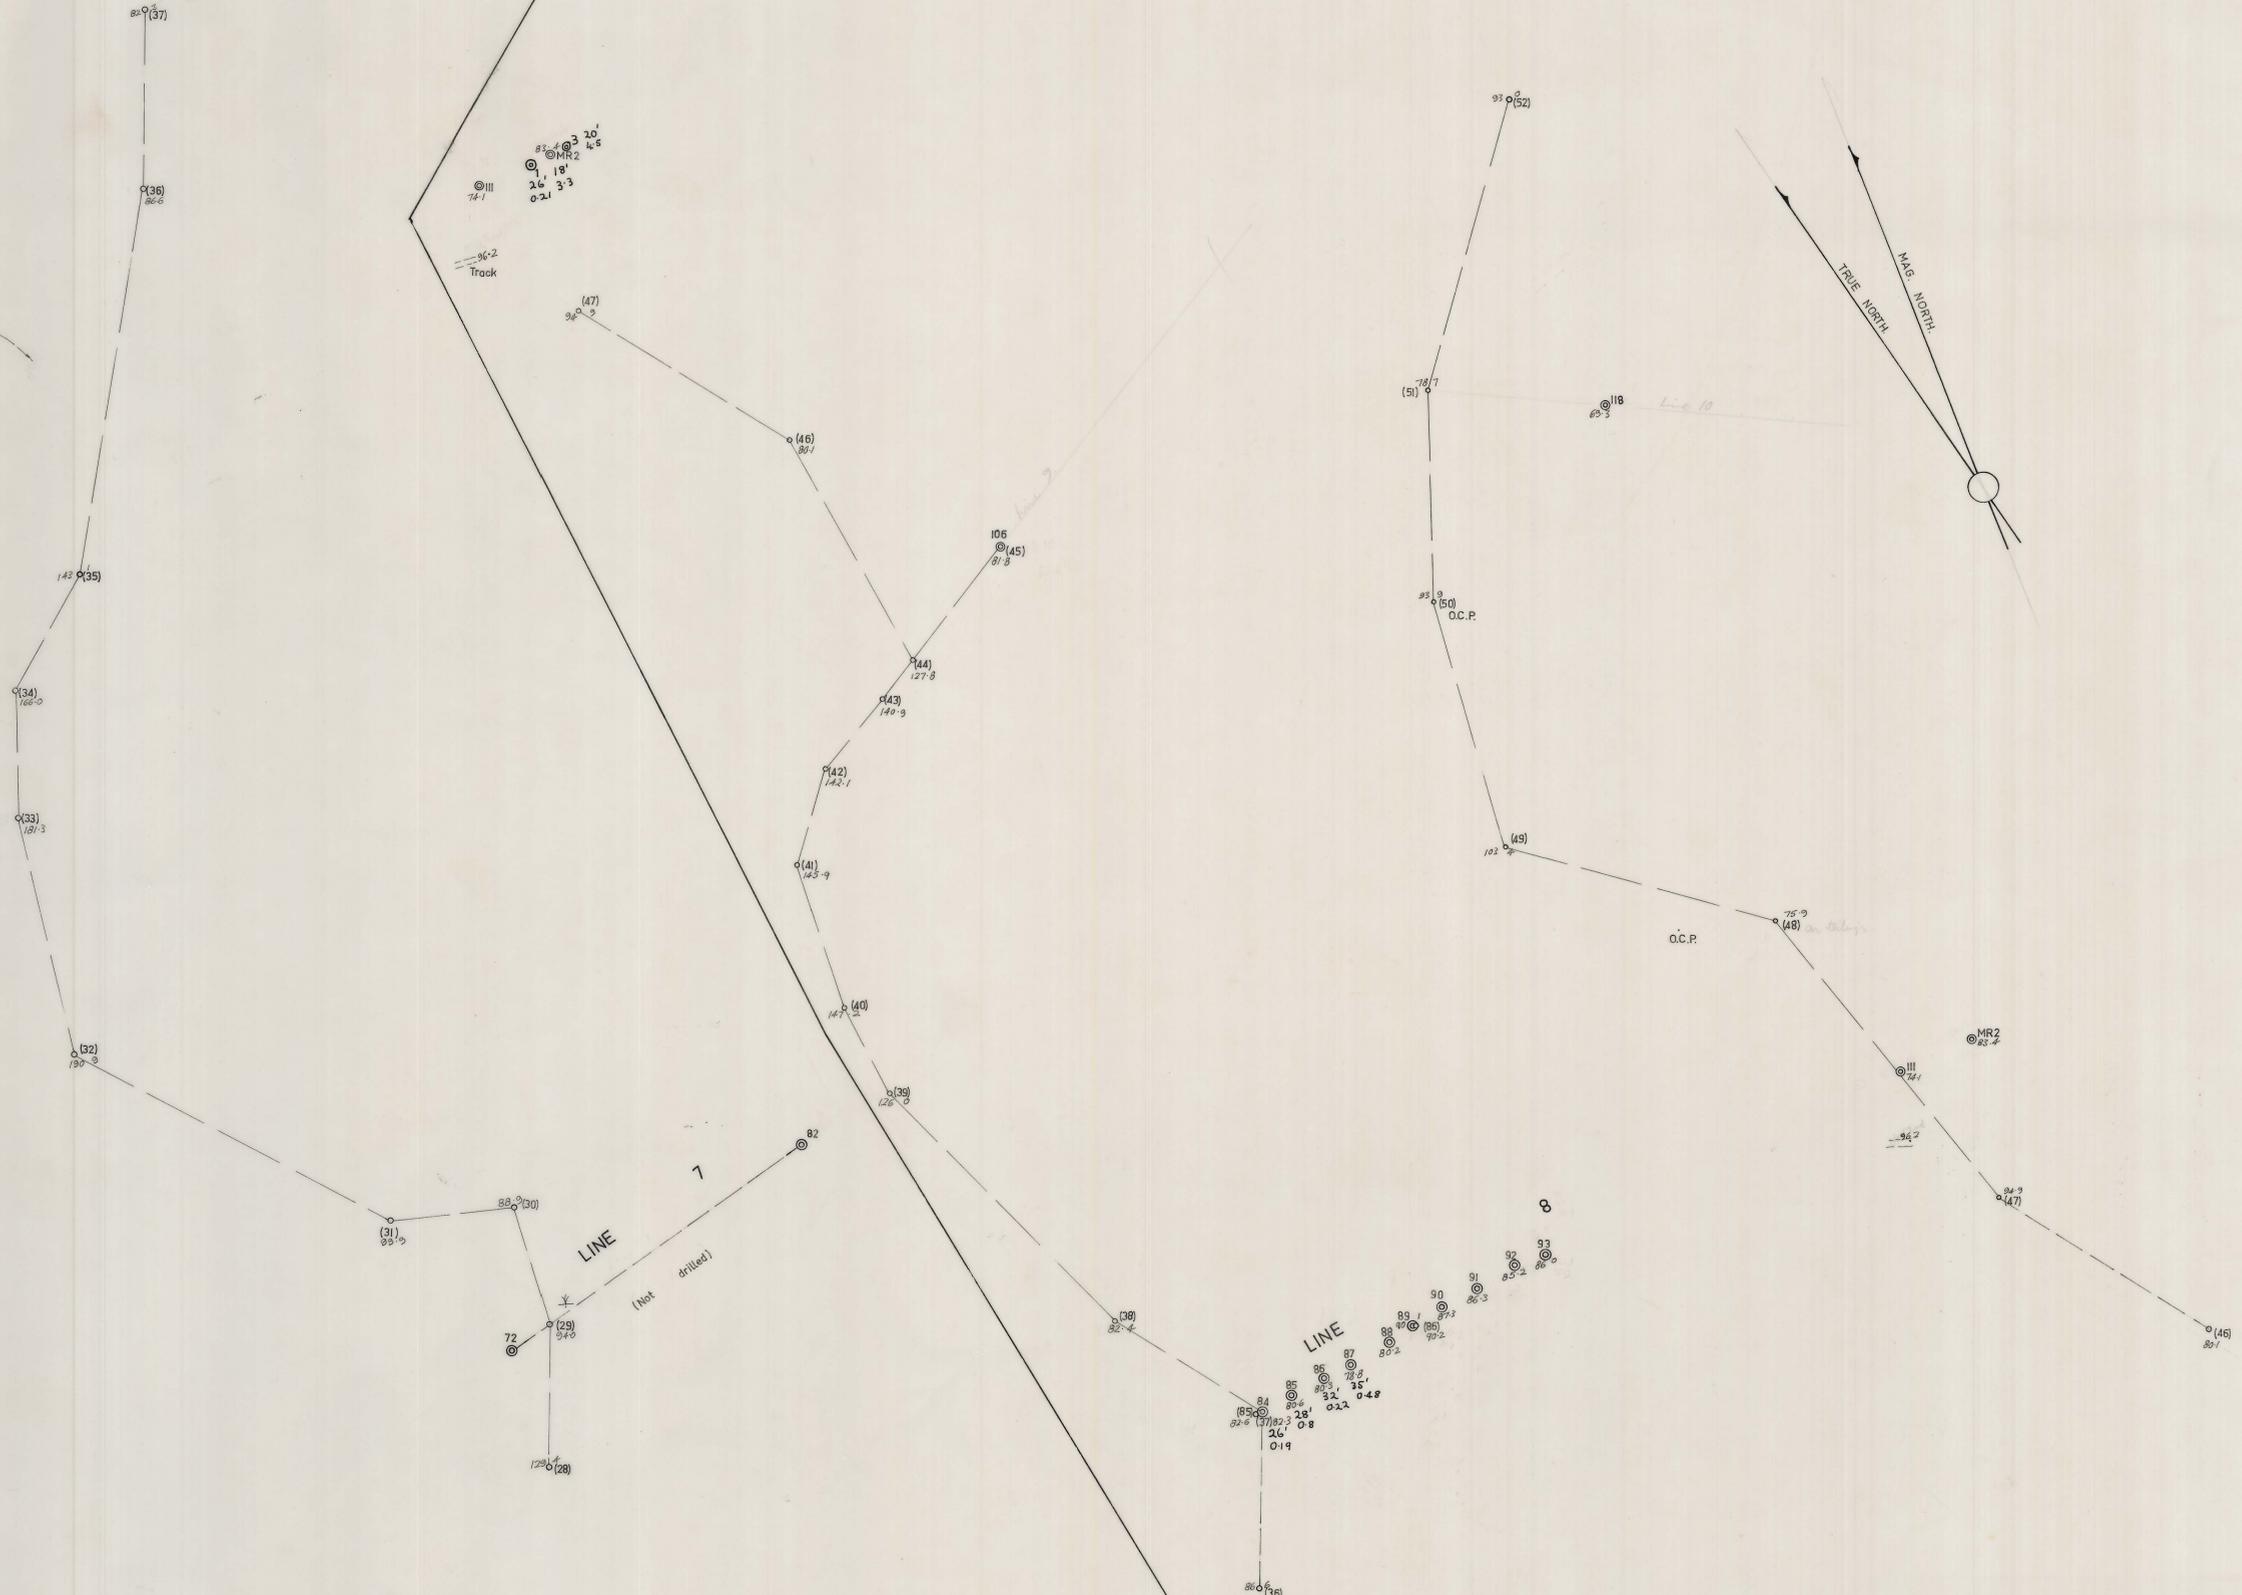


Tailings.

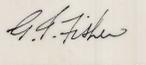

046-007

G.I. FISHER LAND & ENGINEERING SURVEYOR. LAUNCESTON PHONE 31 4207.			
B.M.I. MINING PTY. LTD. MUSSEL ROE BORE HOLES.			
 REGISTERED SURVEYOR. 27.7.71.	SCALE:	200' TO 1".	NO. 8/18
	DRAWN:	R. J. P.	
	CHECKED:	G. I. F.	

5 cm
046-007