


800-9770

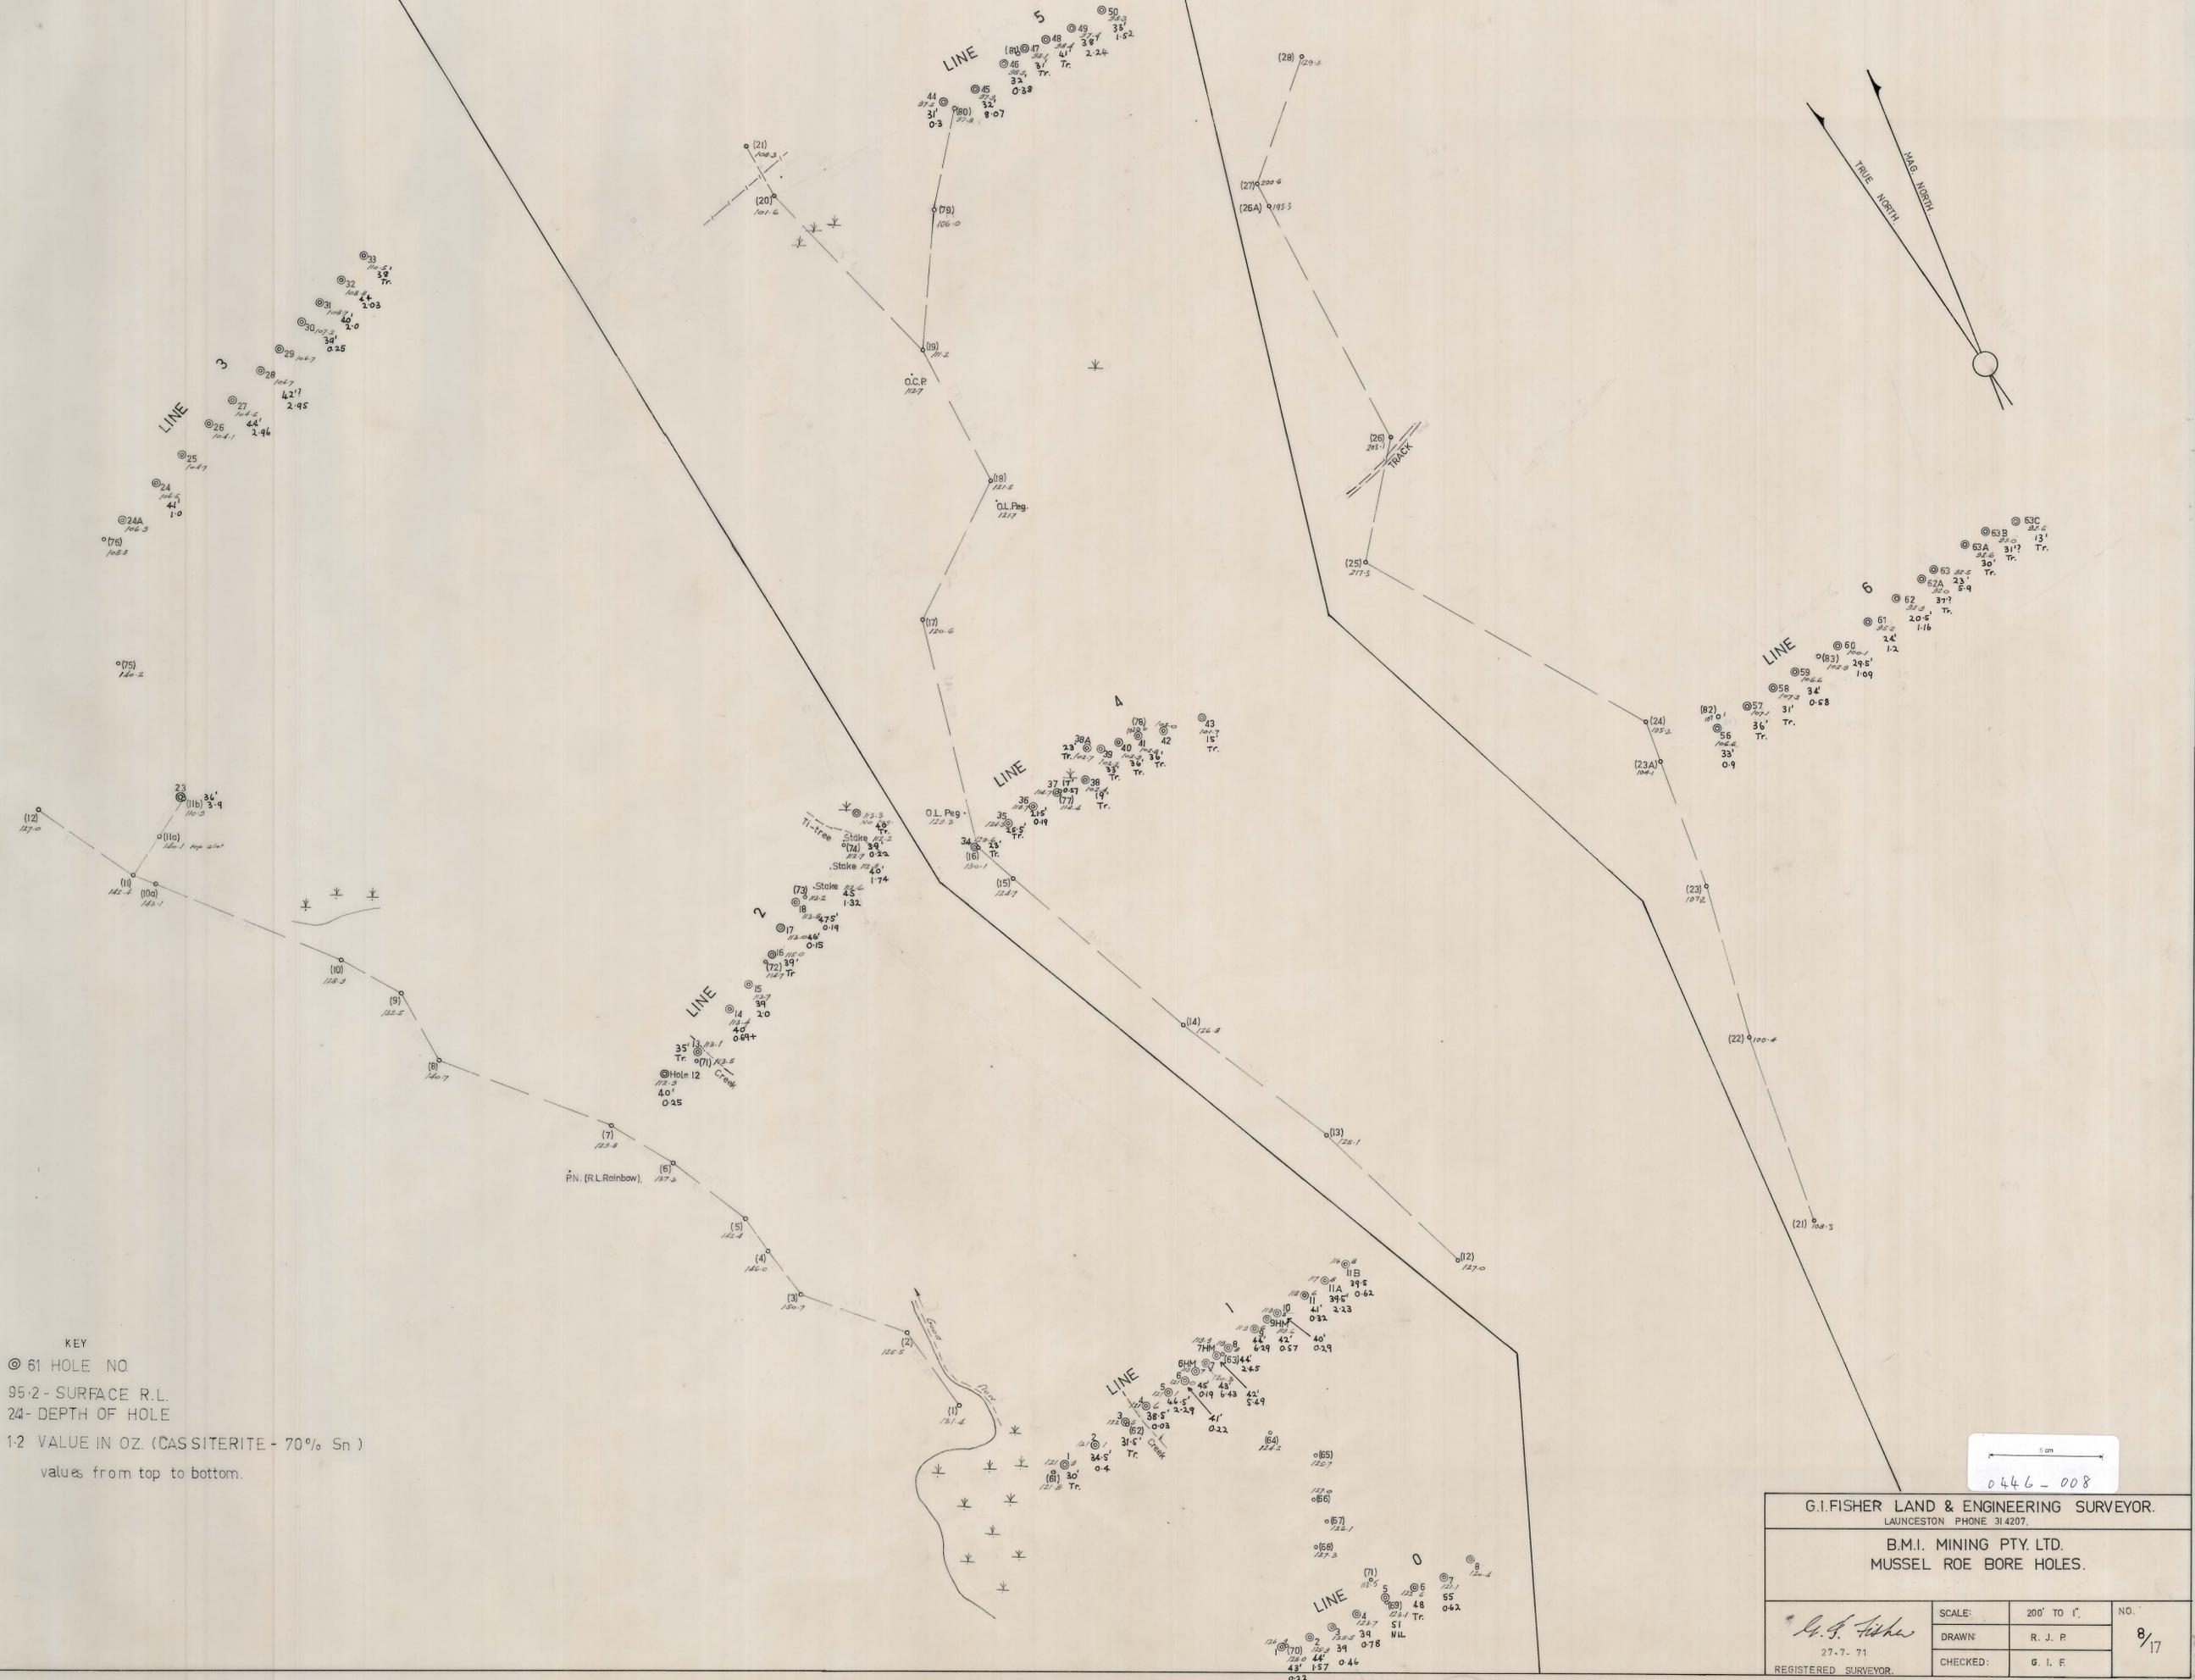

KEY
 © 61 HOLE NO
 95.2 - SURFACE R.L.
 24 - DEPTH OF HOLE
 1:2 VALUE IN OZ. (CASSITERITE - 70% Sn)
 values from top to bottom.

6 cm
 0446-008

G.I. FISHER LAND & ENGINEERING SURVEYOR.
 LAUNCESTON PHONE 314207.

B.M.I. MINING PTY. LTD.
 MUSSEL ROE BORE HOLES.

G.I. Fisher 27-7-71 REGISTERED SURVEYOR.	SCALE:	200' TO 1"	NO. 8/17
	DRAWN:	R. J. P.	
	CHECKED:	G. I. F.	