




DEEP BAY

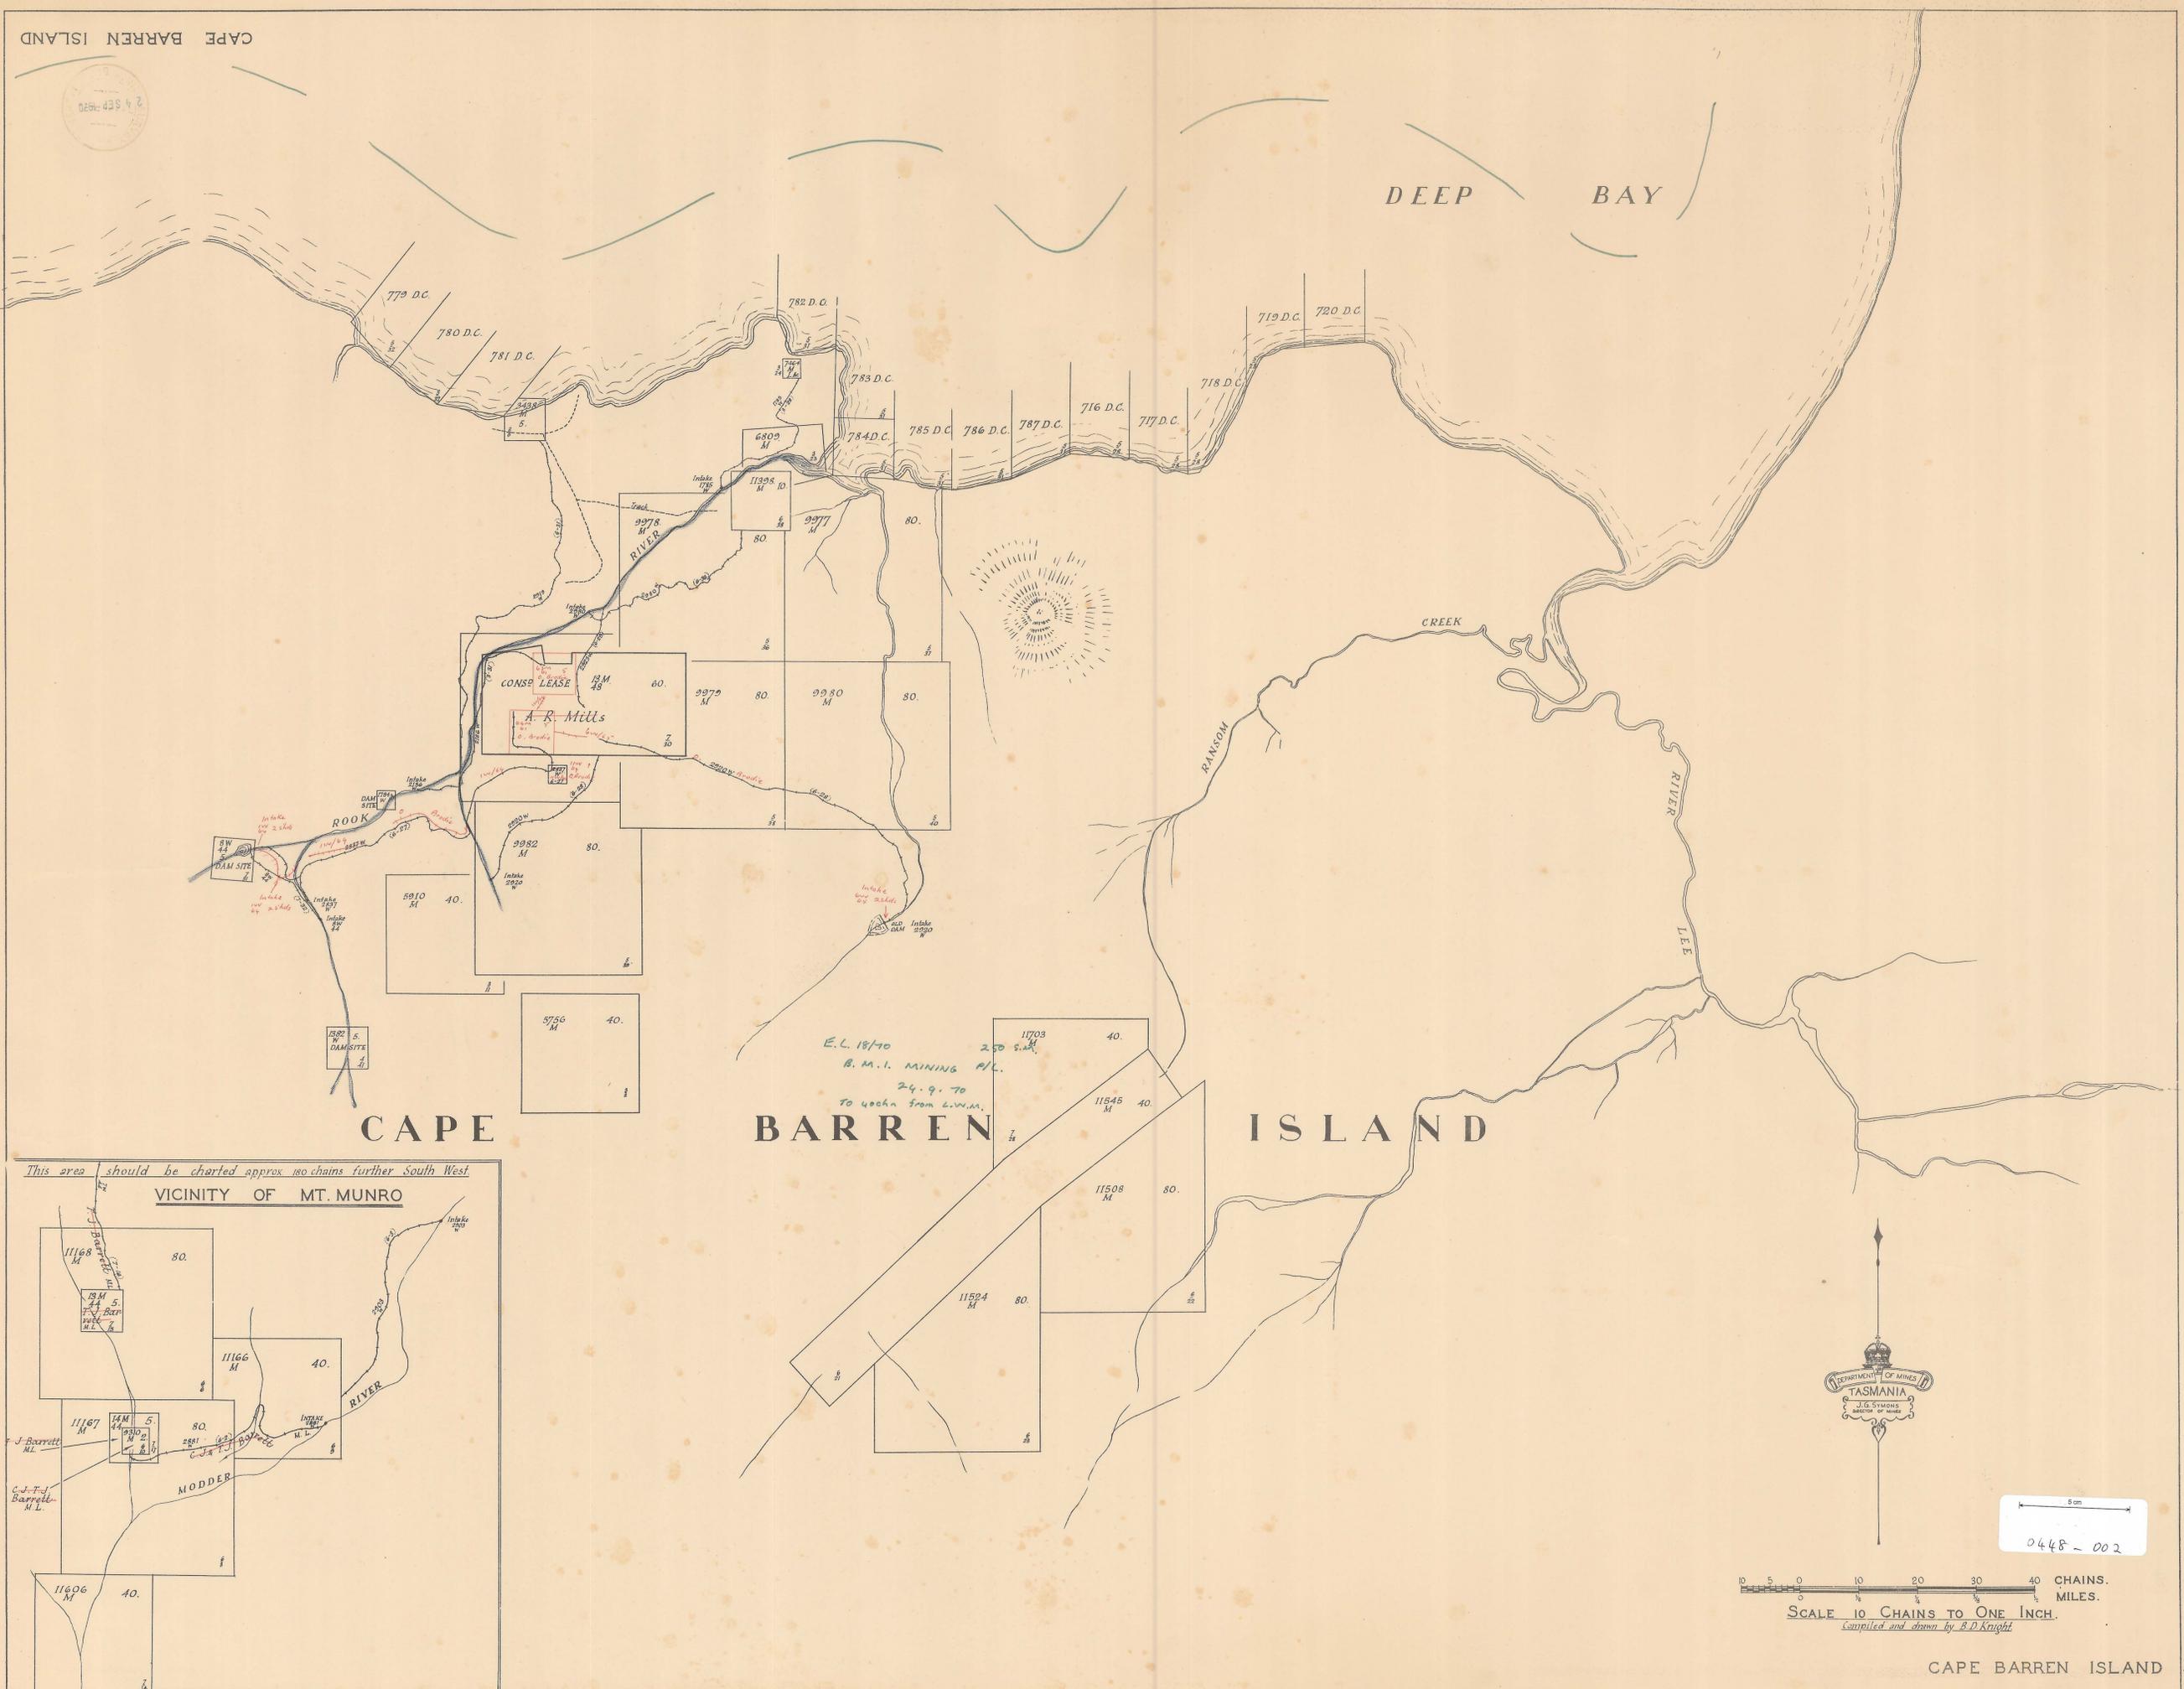


CAPE


BARREN

ISLAND

E.L. 18/70  
B.M.I. MINING P/L.  
24.9.70  
To 40chn from L.W.M.

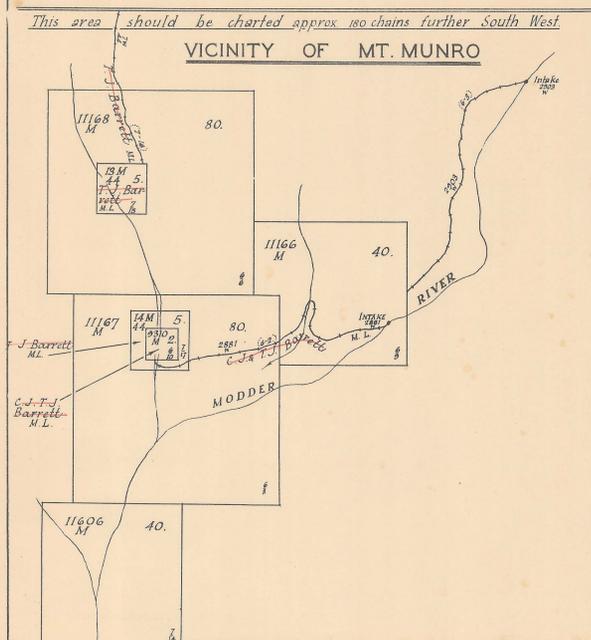

0448-002

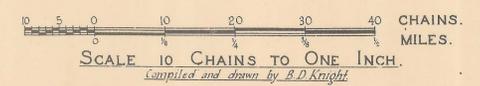

CAPE BARREN ISLAND