


0449-001

5440000m N.


5439000m N.

485000m E.

486000m E.

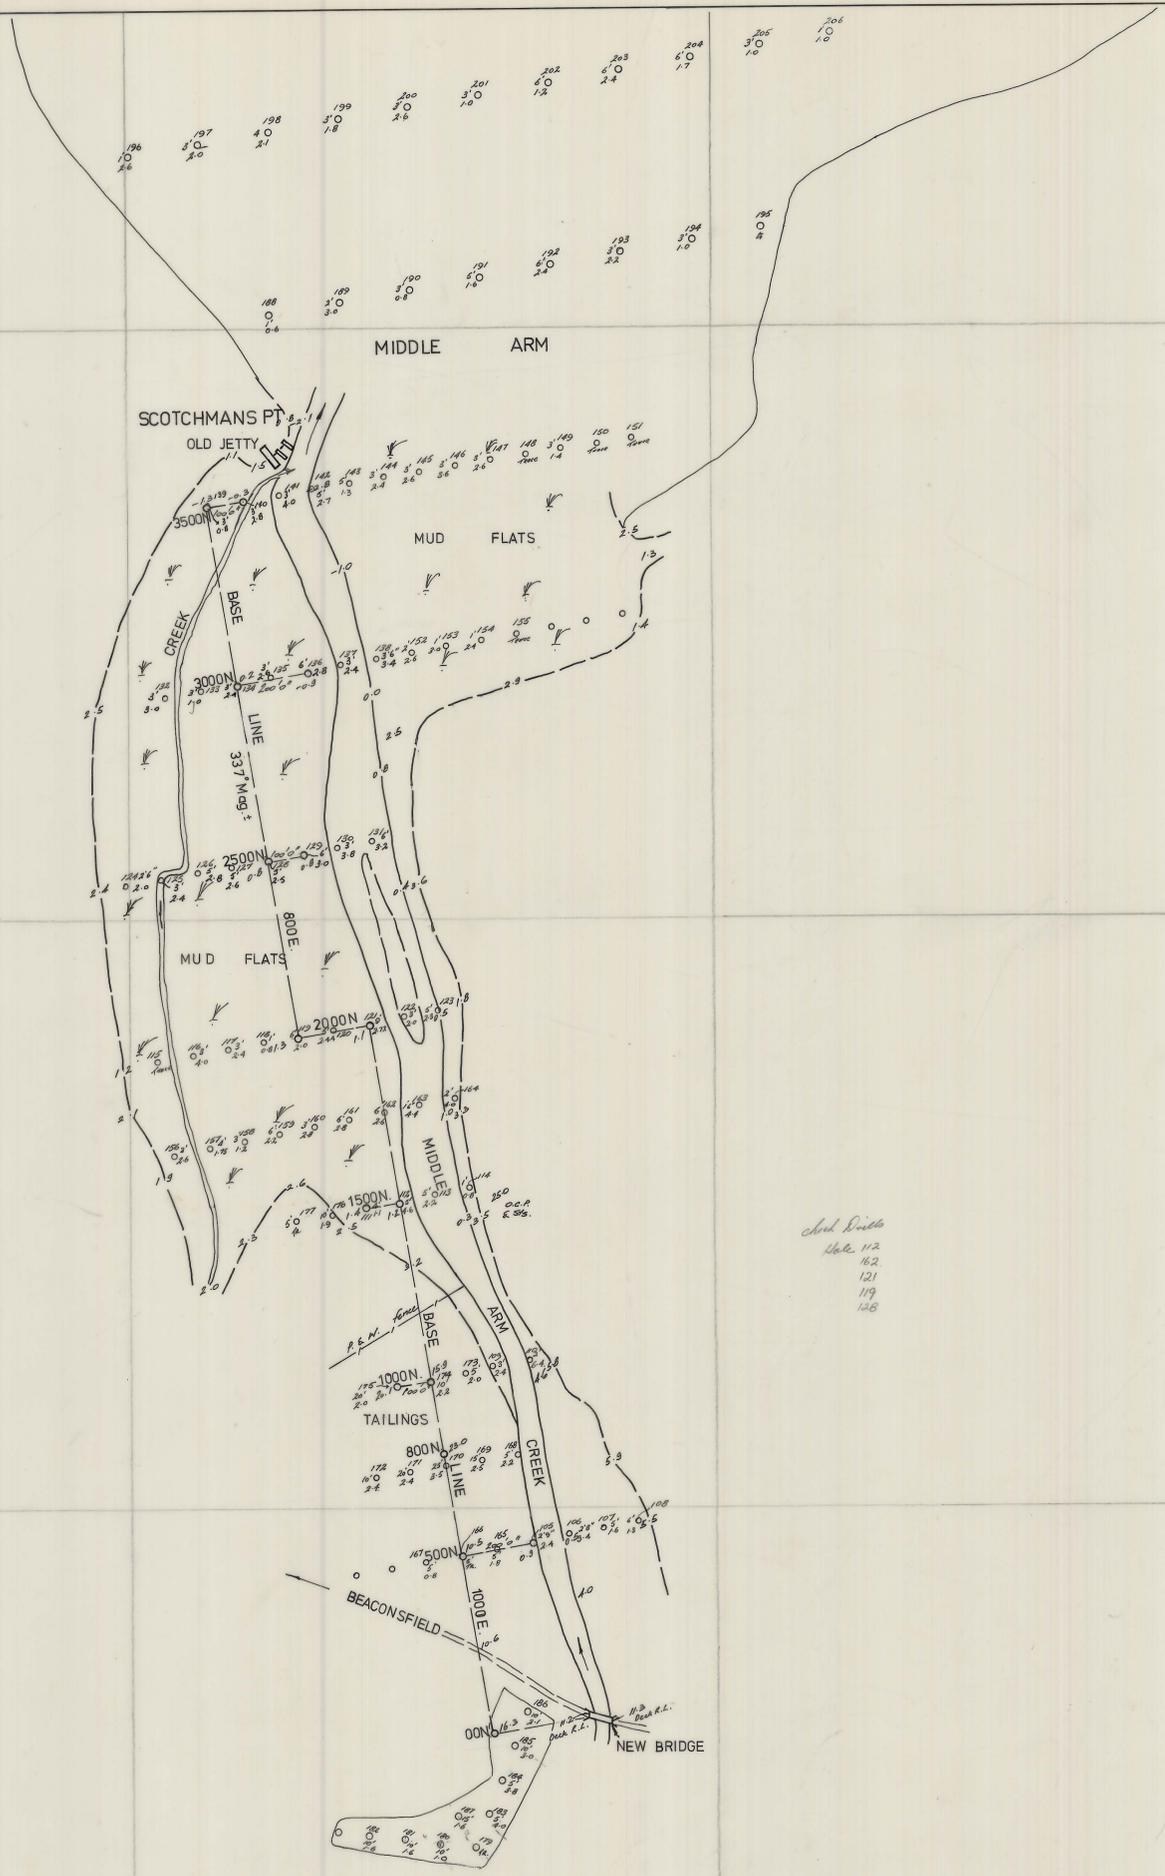

Spot Heights  
 112  
 162  
 121  
 119  
 128

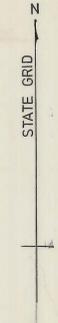

NOTES:

1. GRID IS STATE METRIC
2. LEVELS ARE STATE DATUM (FEET)
3. PEGS SHOWN THUS: 105, 104, 103, 1, 0
4. PEGGED LINES ARE TO AN ASSUMED LOCAL GRID OF FEET

487000m E.

G. I. FISHER LAND & ENGINEERING SURVEYOR LAUNCESTON PHONE 314207			
B.M.I. MINING PTY LTD MIDDLE ARM E.L. 21/72			
<i>G.I. Fisher</i>	SCALE	200' TO 1" OR 1:2400	NO. 8/40
	DRAWN	H. M.	
	DATE	14-6-73	

5cm  
 0449-001