



0455 - 001

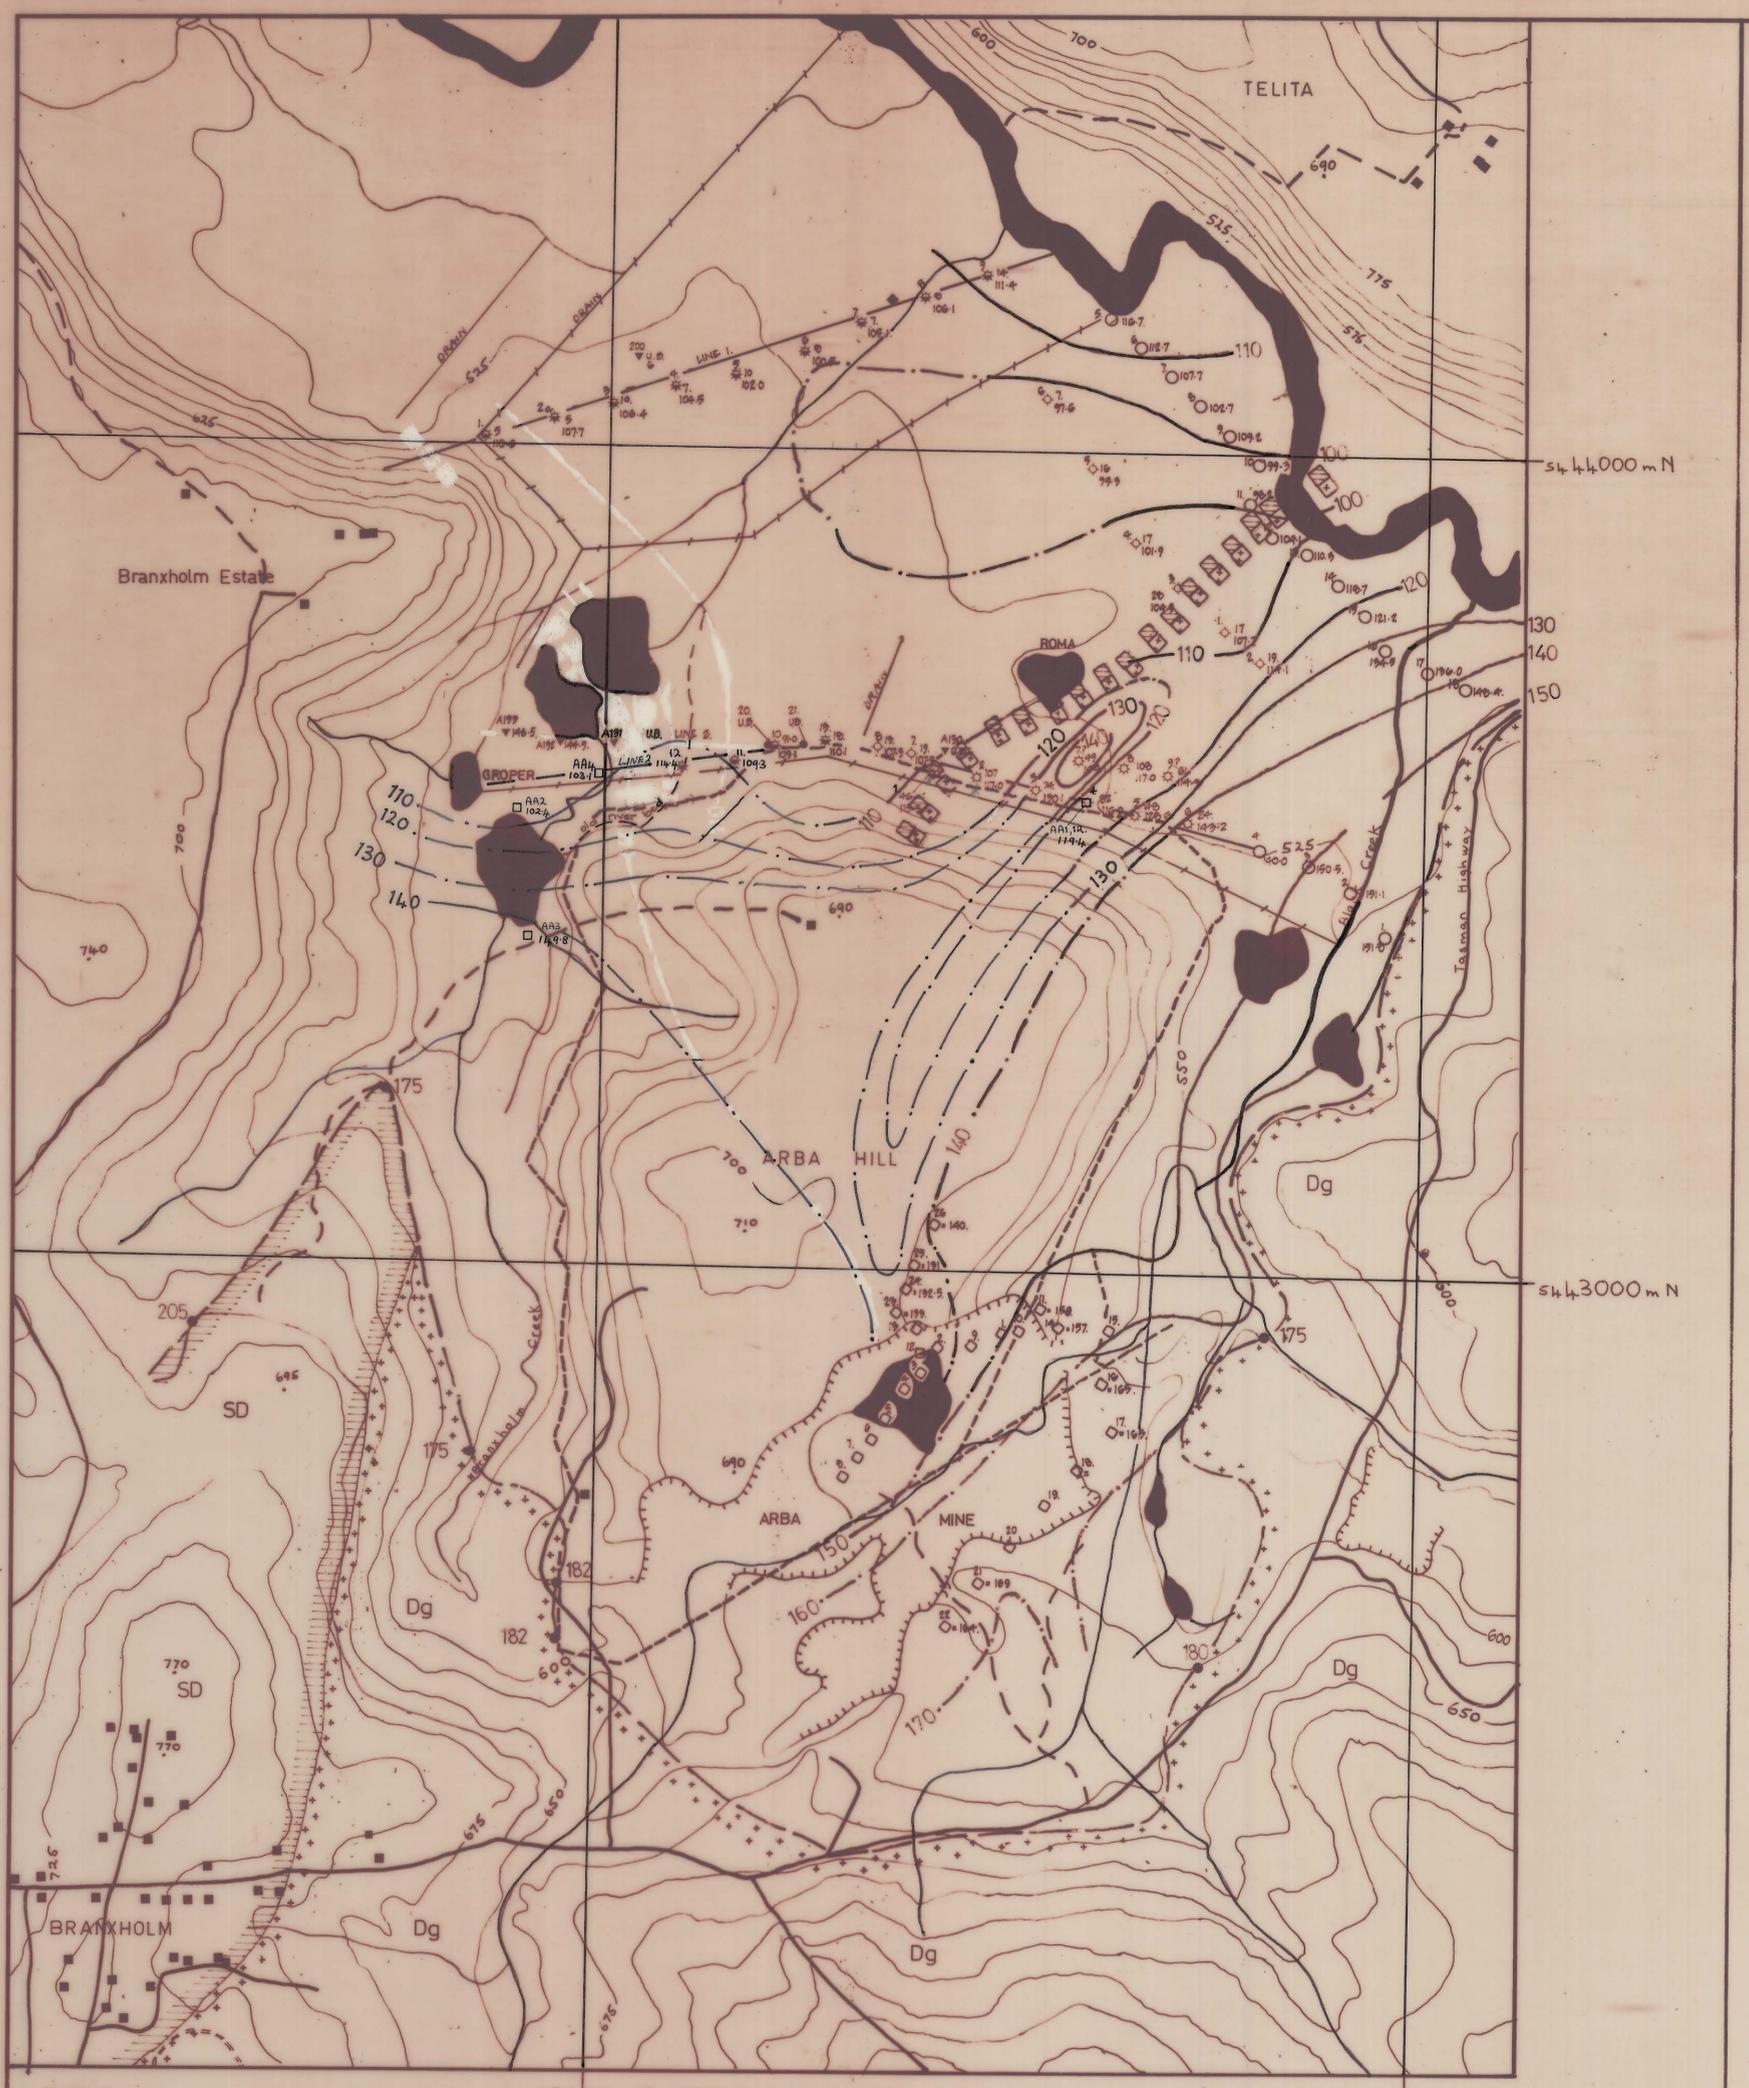

TITLE : 563000 m E MATHINNA GROUP GRANITE ROCKS 564.000 m E

BASEMENT GEOLOGY AND CONTOUR INTERPETATION

- Basement Contours (10m interval) (two levels of confidence)
- Limits of bedrock outcrop
- Spot heights (m)

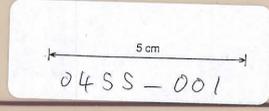


AUSTRALIAN ANGLO AMERICAN LTD. - AMDEX MINING LTD. EXORATION.

DRILL HOLE LOCATION MAP - ALL DRILLING - ARBA AREA - BRANXHOLM N.E. TASMANIA.

Drill Hole Positions Showing : Company, Hole Number, Grade and Basement R. L.

Drilling Company Legend	Drill hole Legend	General Information
<ul style="list-style-type: none"> * □ AUSTRALIAN ANGLO AMERICAN - 1981, 1983 ○ TASMANIAN DEPARTMENT OF MINES - 1976-77 ● UTAH DEV. CO. ROTARY HOLES - 1989 ▼ UTAH DEV. CO. AUGER HOLES - 1989 ▽ UTAH DEV. CO. PERCUSSION HOLES - 1989 ◇ BRITISH CONS. N.L. HAND PLANT - 1990 ☆ TASMANIAN DEPARTMENT OF MINES - 1997 ◇ TASMANIAN DEPARTMENT OF MINES - 1991 	<ul style="list-style-type: none"> 2. ——— DRILL HOLE NUMBER ○ 107 ——— GRADE SURFACE TO BASEMENT, g.b.m./m ○ 170 ——— BASEMENT R.L. (m) 	<ul style="list-style-type: none"> ——— CROSS SECTION (FIGURE 9), ORIENTATION. ——— BOUNDARIES OF MINERAL LEASE 100 P/A - ARBA, TIN PTY. LD. ■ BUILDINGS ——— OLD MINE FACES ——— FENCE LINES (SURVEYED) GRID APPROXIMATE A.M.G.

CONTOUR INTERVALS : 25 FEET.
DATE : 1/2/84
SCALE : 1 : 5,000

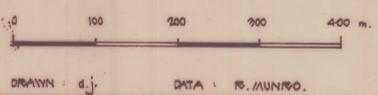

TAS-10-171
FIGURE 2