


ABERF_072

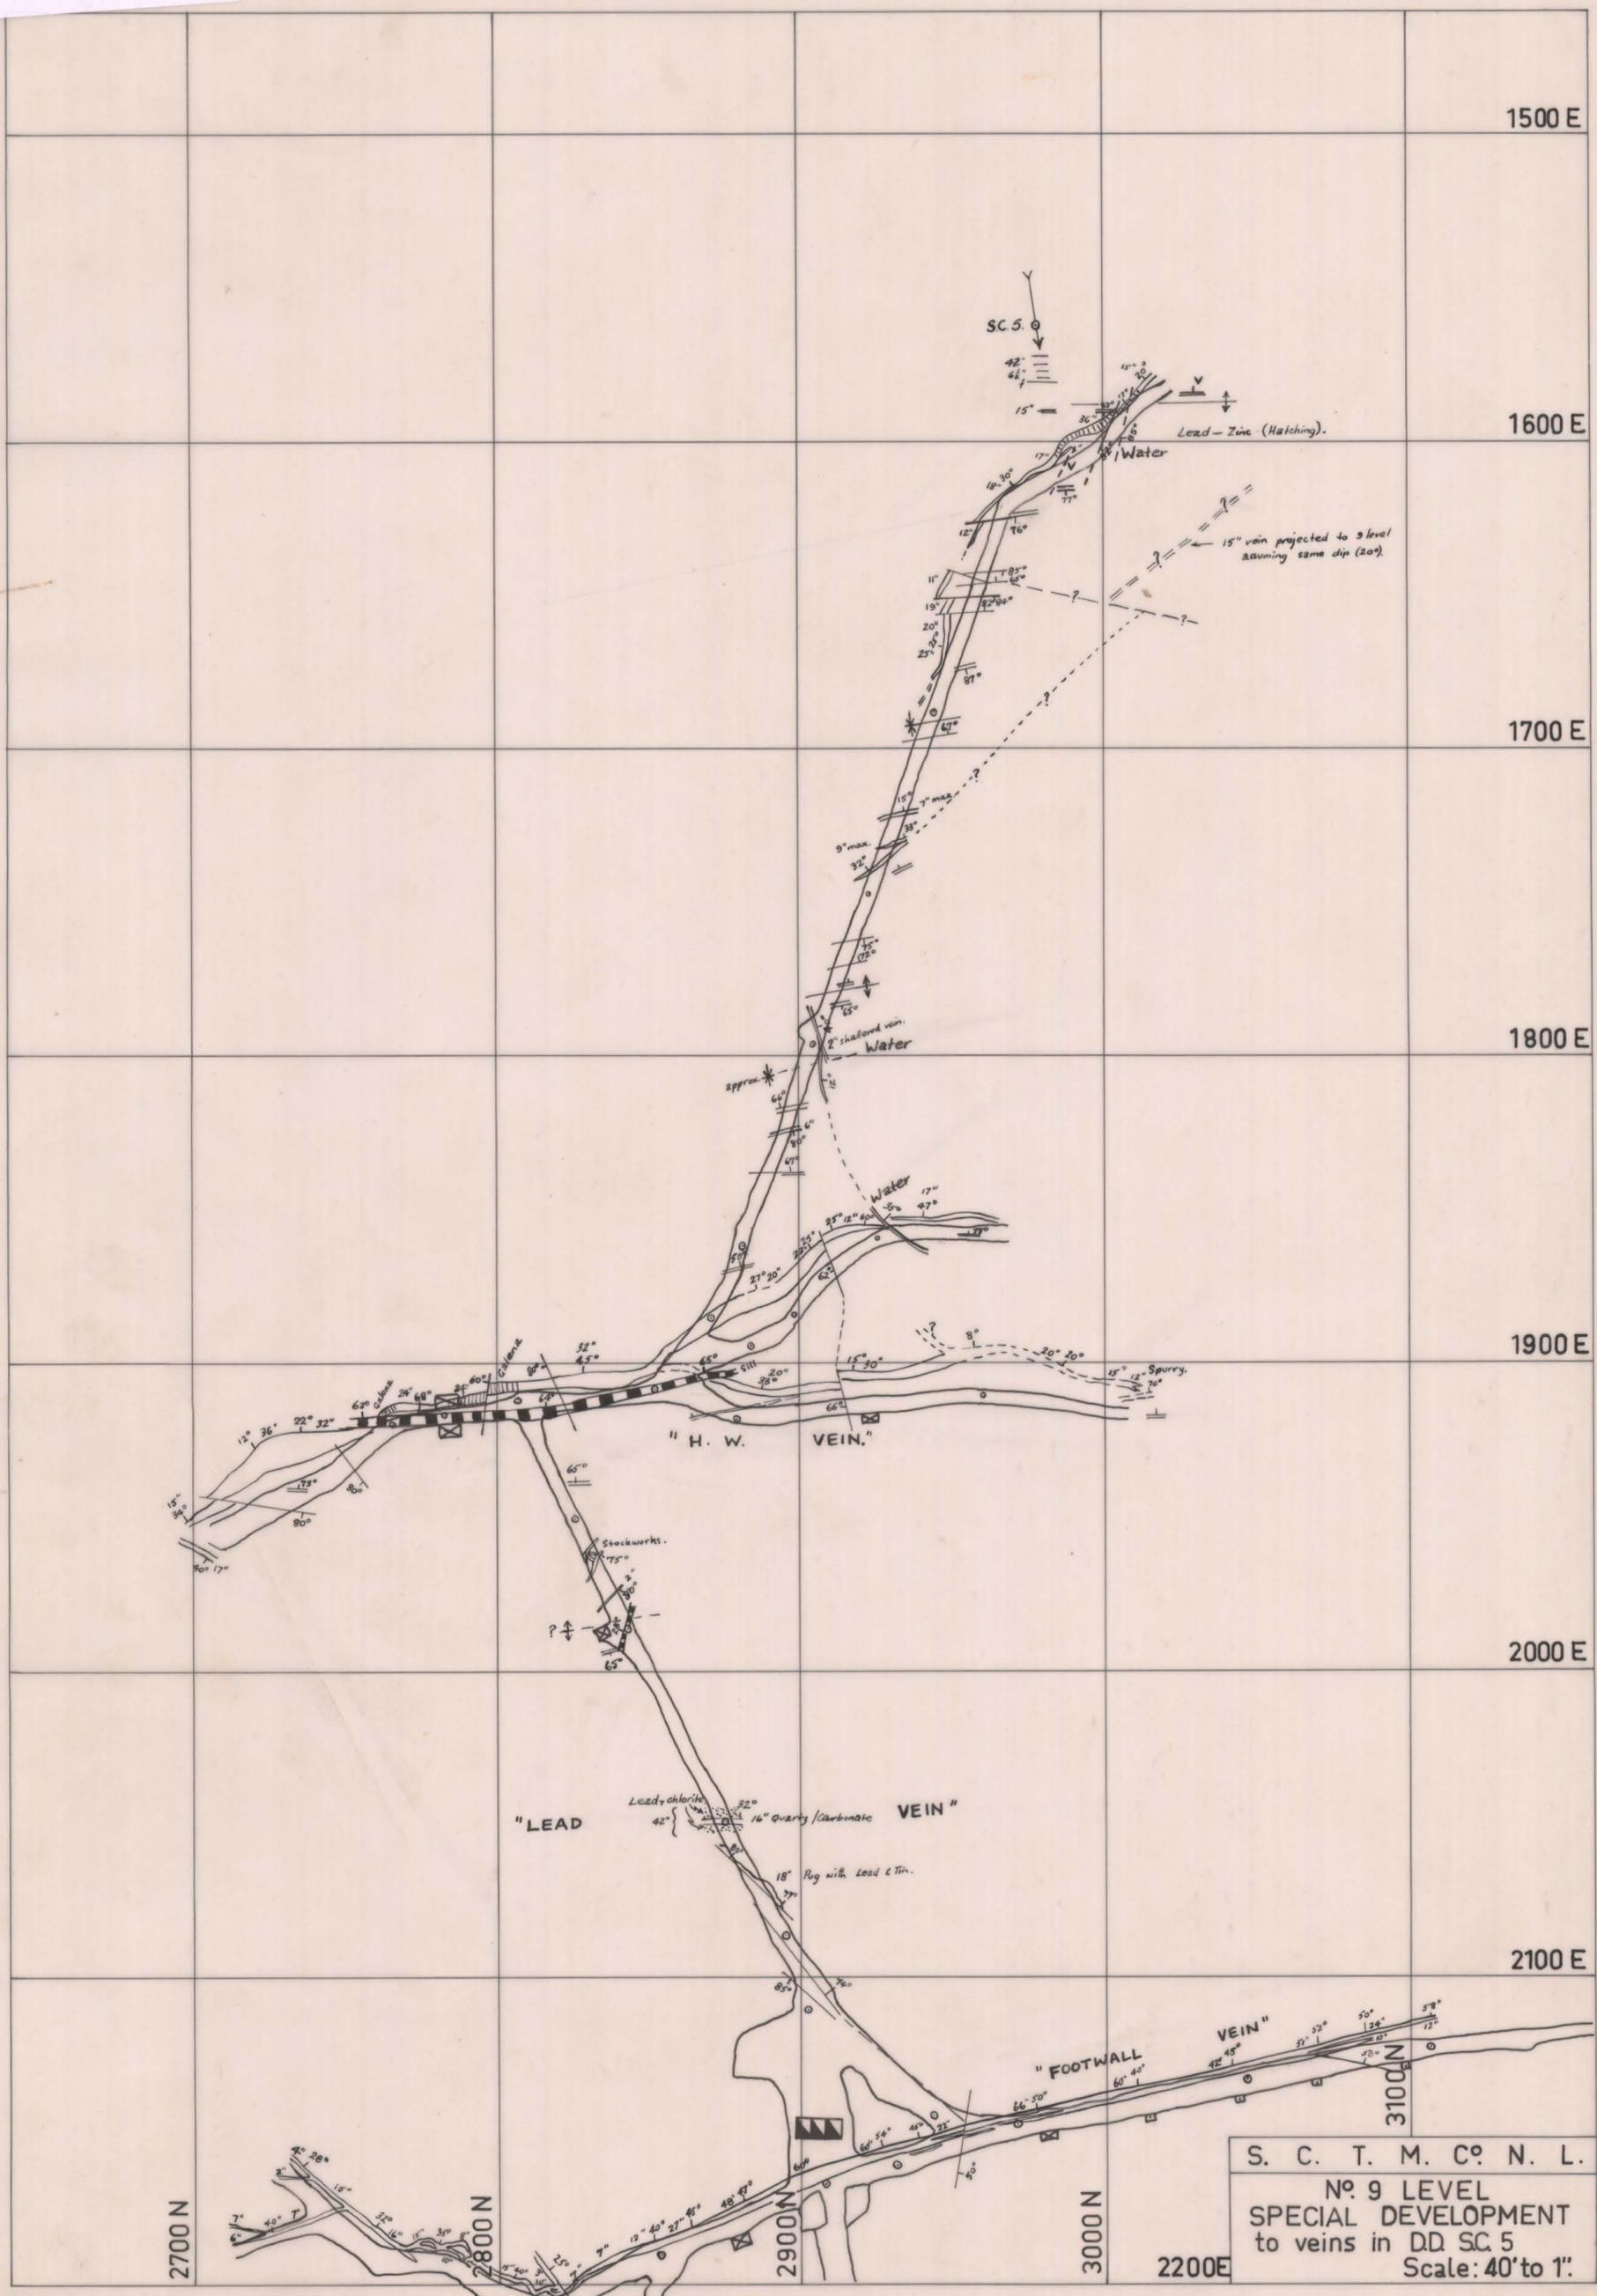

S. C. T. M. C. N. L.
 No. 9 LEVEL
 SPECIAL DEVELOPMENT
 to veins in DD SC. 5
 Scale: 40' to 1'.