

2000 E


2100 E

2200 E

2800 N

2900 N

3000 N

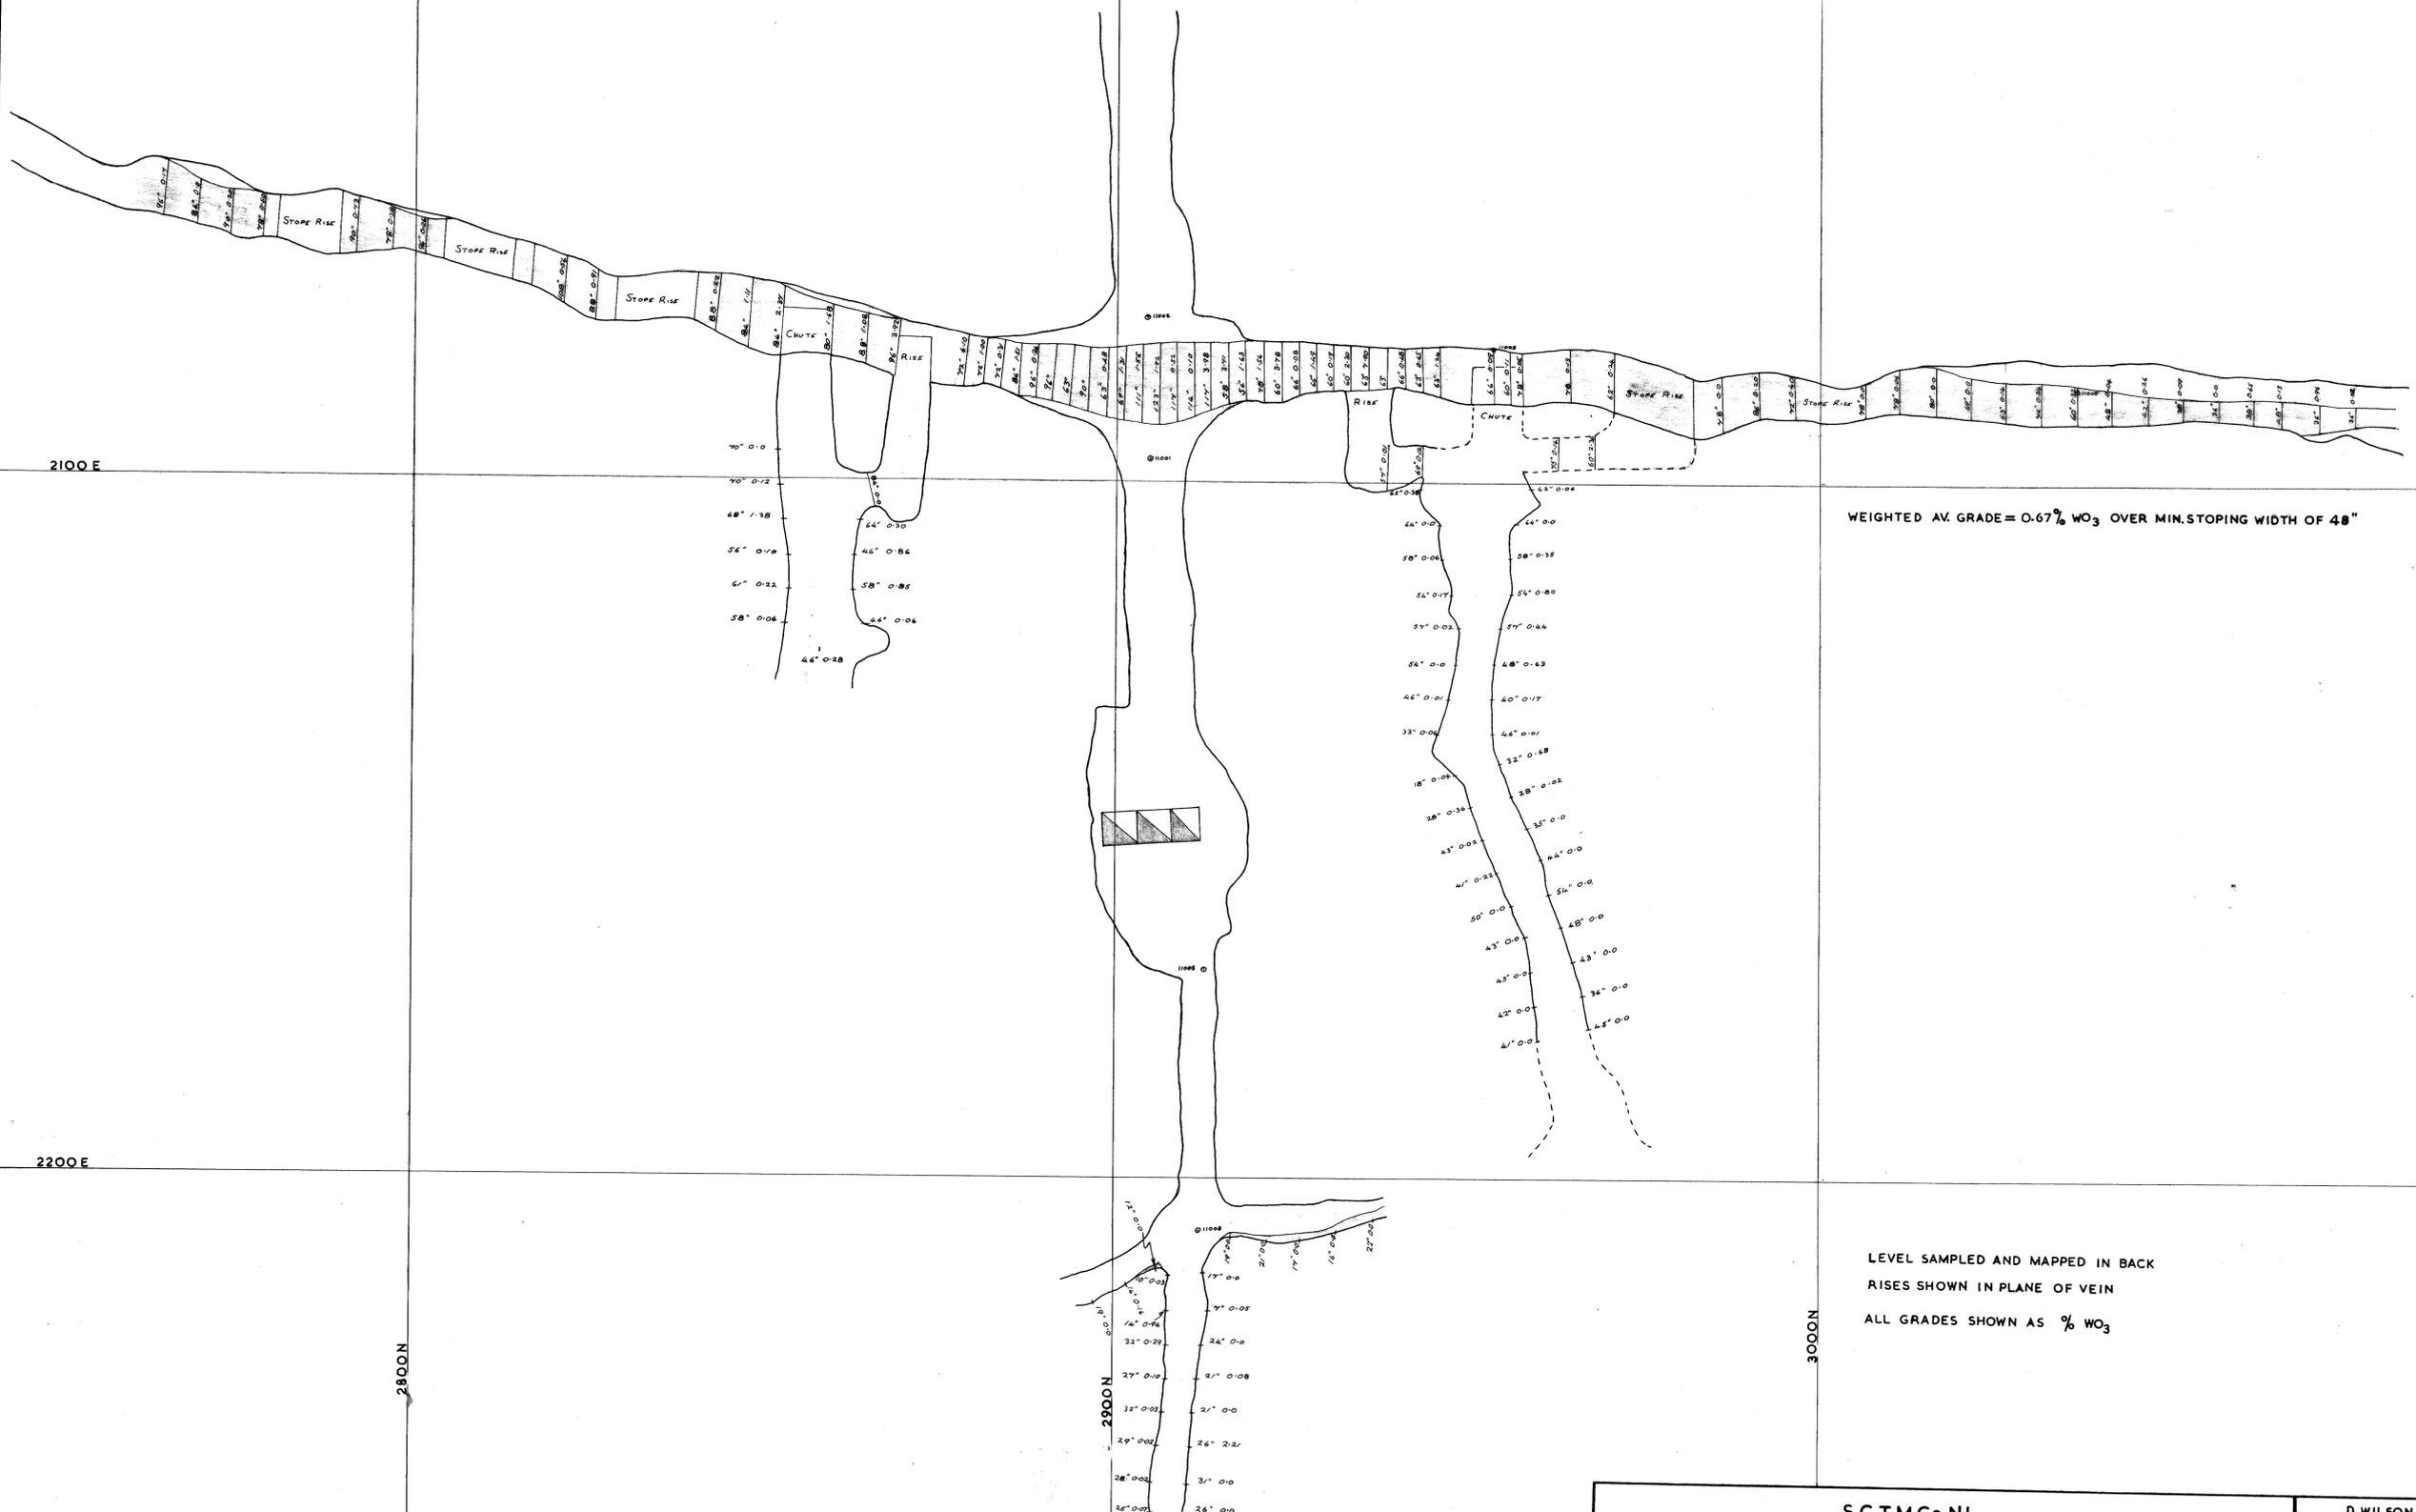

WEIGHTED AV. GRADE = 0.67% WO₃ OVER MIN. STOPING WIDTH OF 48"

LEVEL SAMPLED AND MAPPED IN BACK
RISES SHOWN IN PLANE OF VEIN
ALL GRADES SHOWN AS % WO₃

S.C.T.M.Co.N.L.
ASSAY PLAN

D. WILSON DEC '67
II LEVEL

Scale: 10 Feet to 1 Inch.