


5 cm

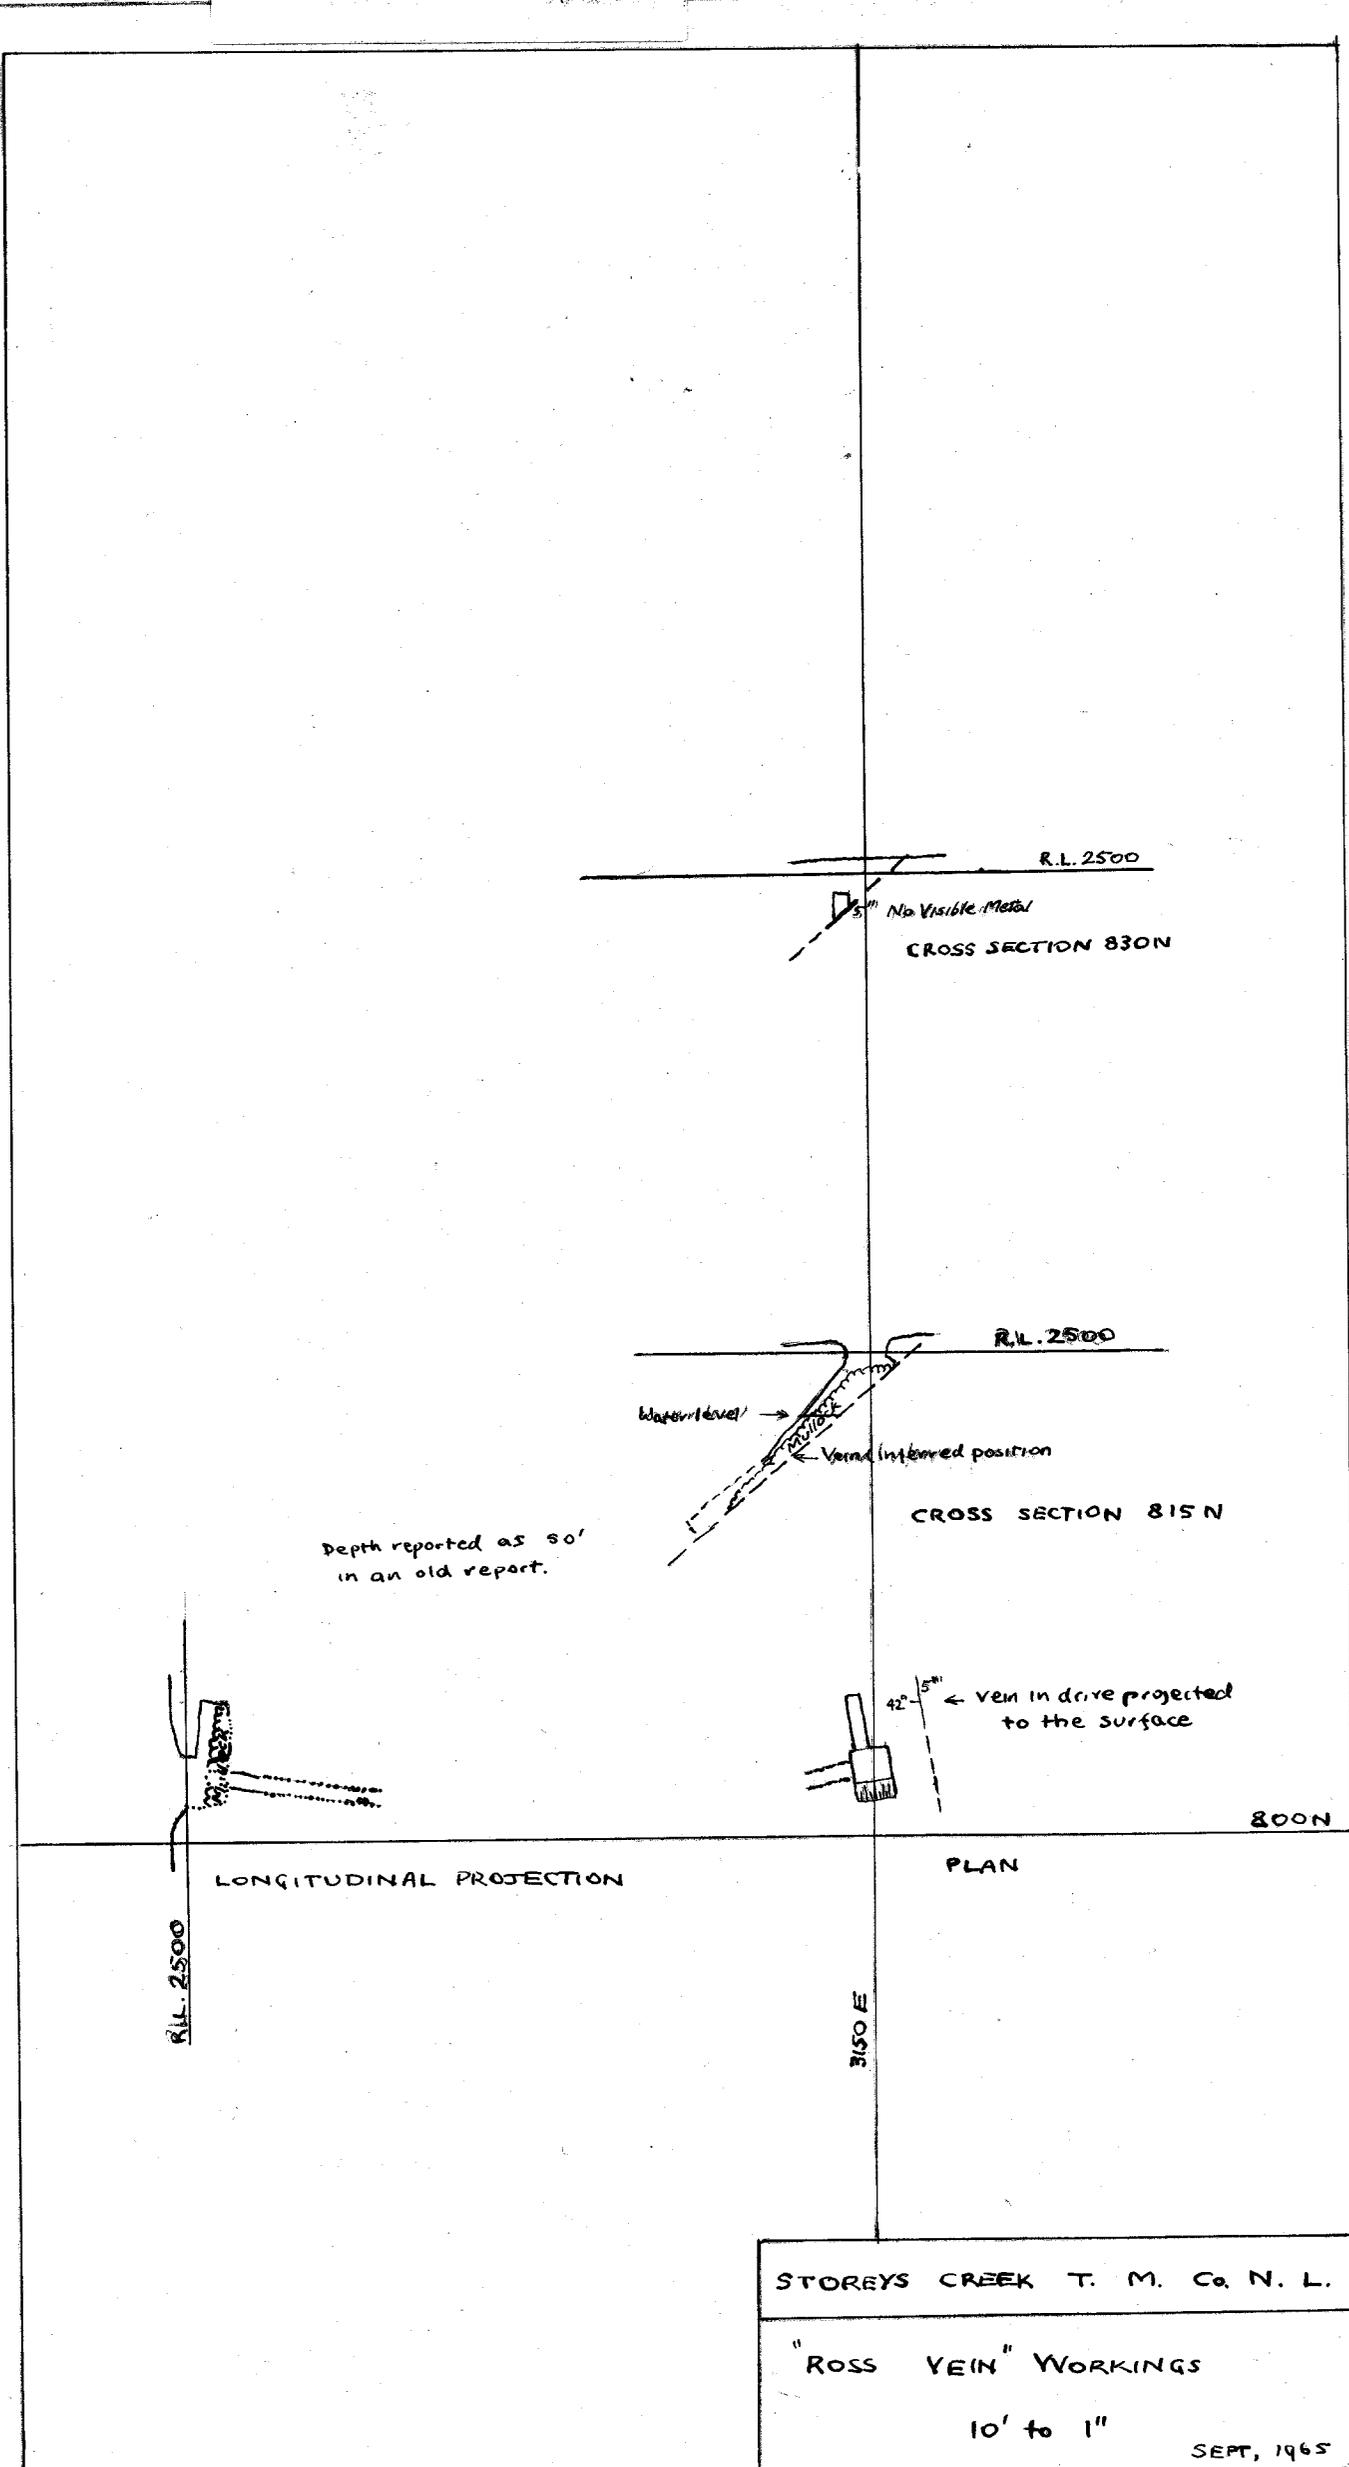

STOREYS CREEK T. M. Co. N. L.

"ROSS VEIN" WORKINGS

10' to 1"

SEPT, 1965