
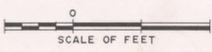


5m

ABERF-
122A

122A

Colour

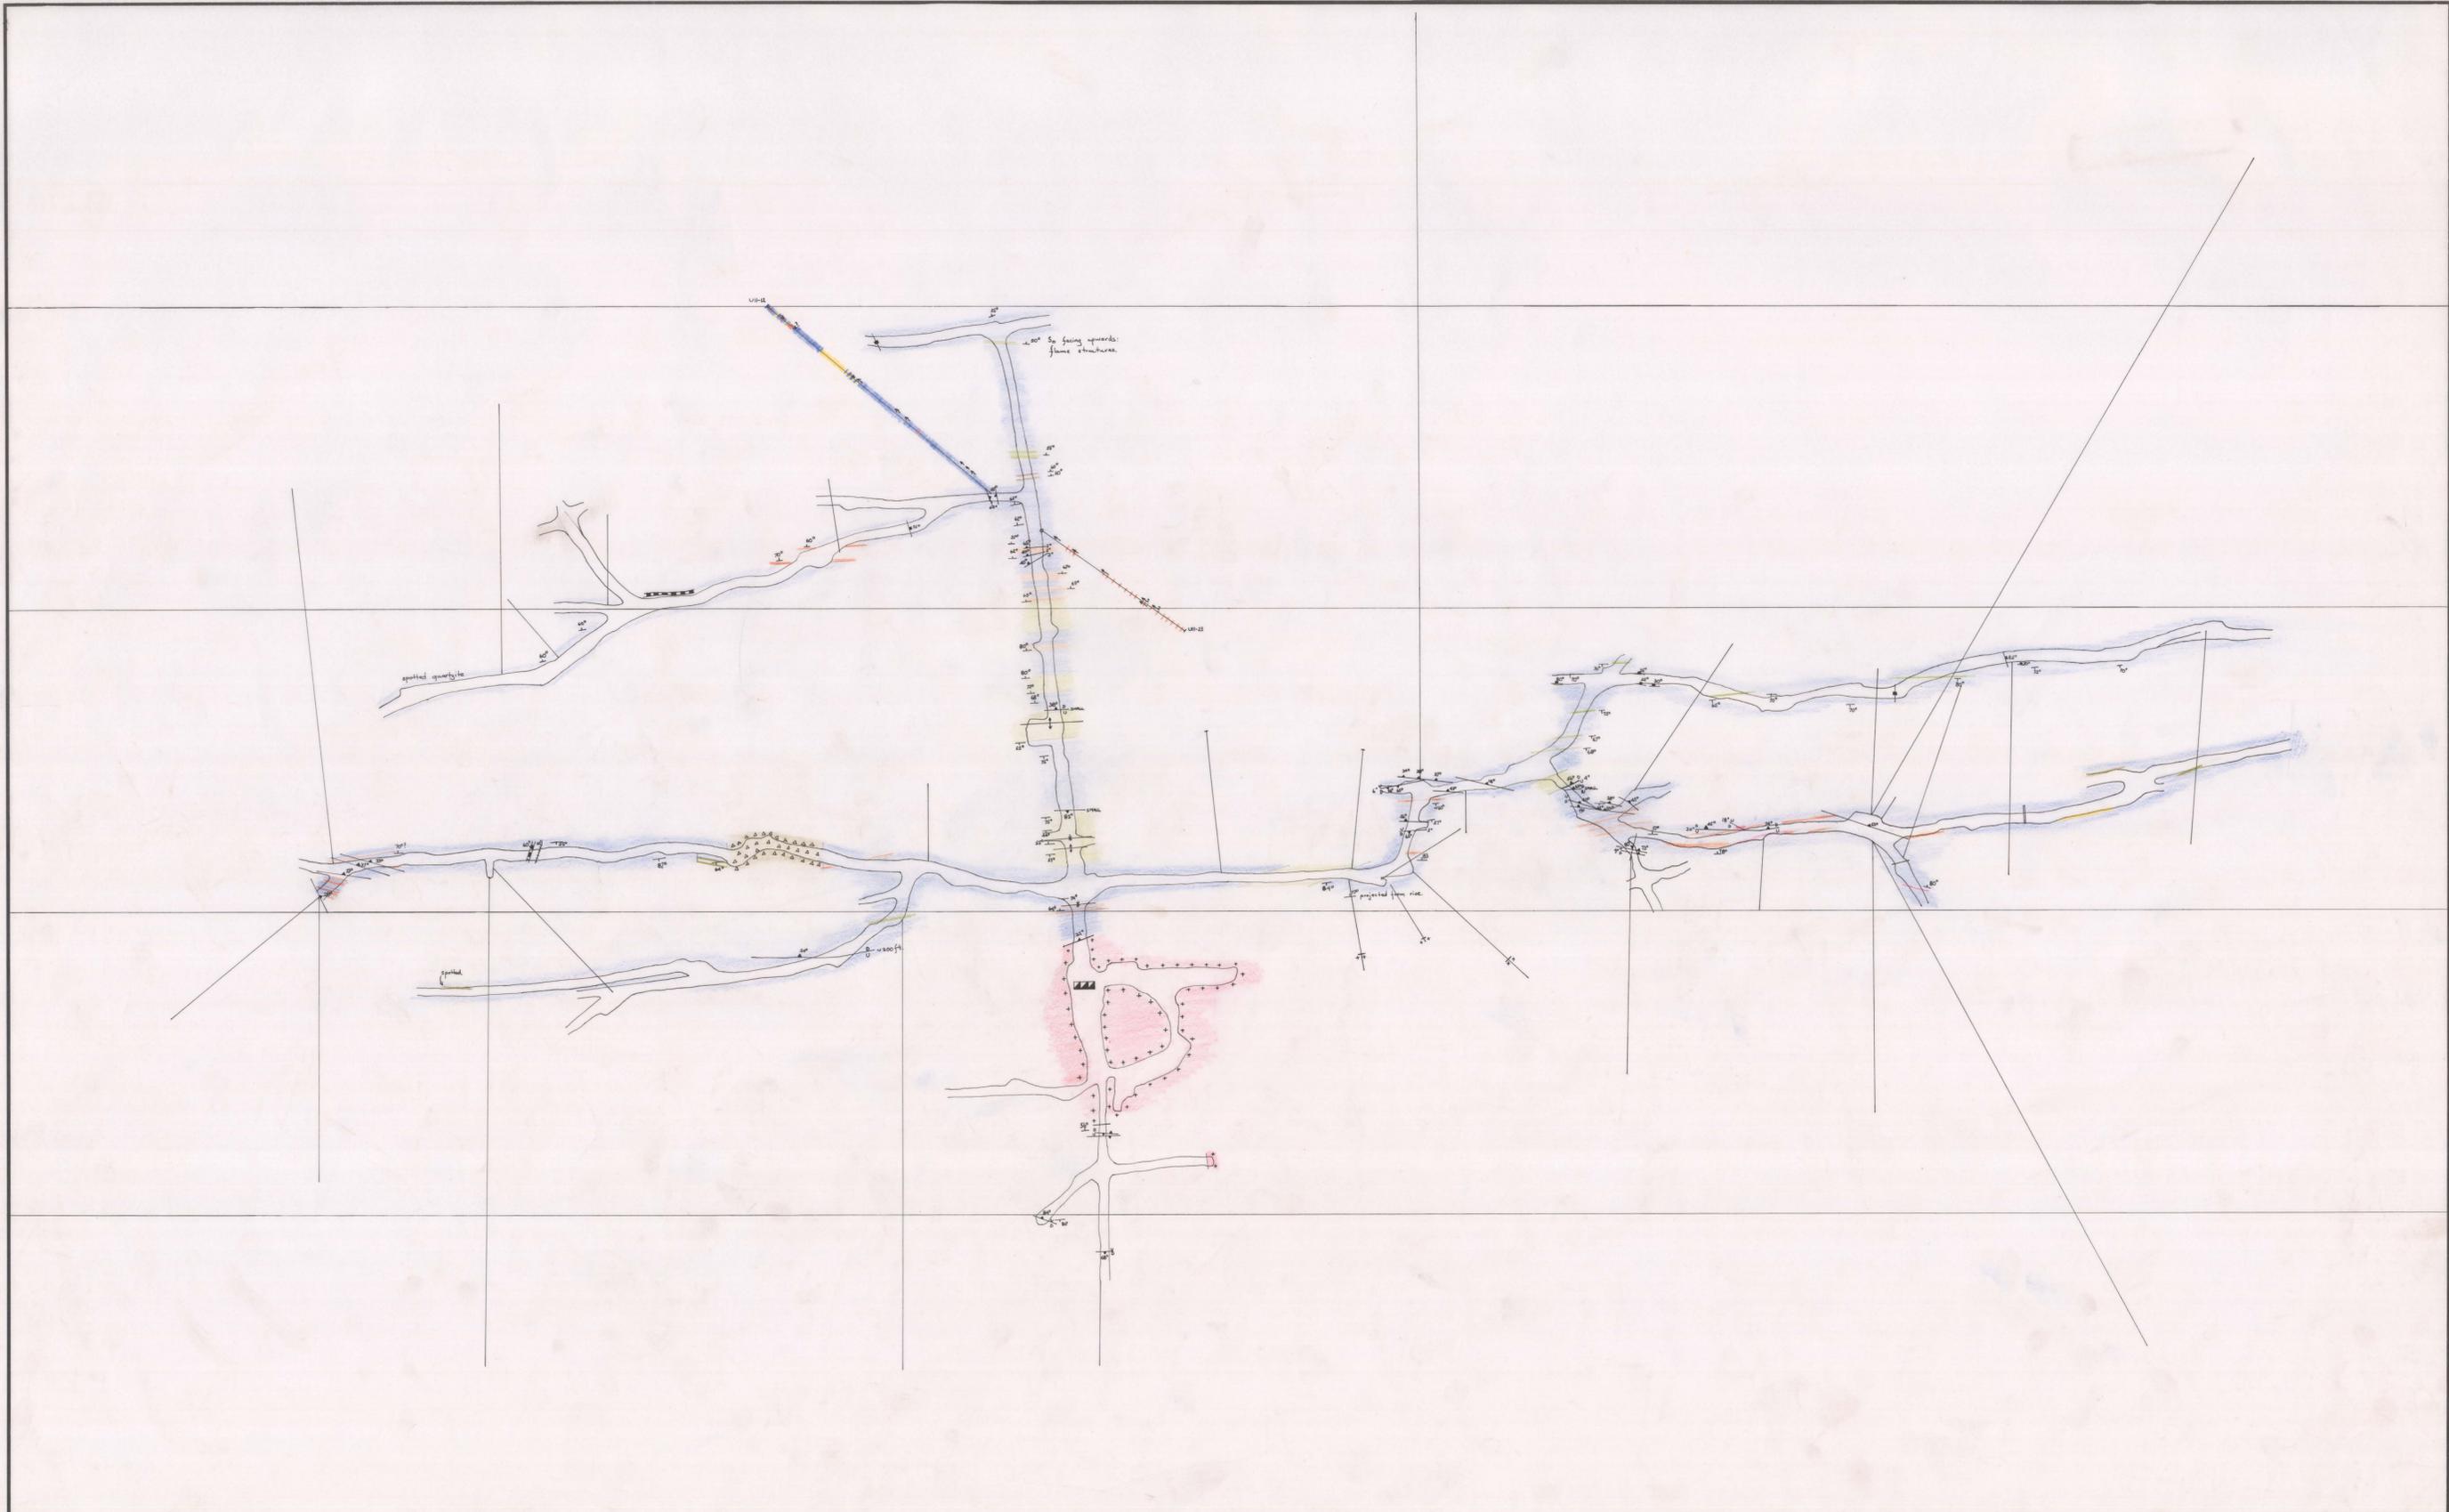

SURVEY - - - / /
 GEOLOGY - - - / /
 ENGINEERING - - - / /
 DRAWN - - - / /
 TRACED - - - / /
 REFERENCE - - - / /
 PRINT No. - - - / /
DRAWING No. -

DRAWER: