
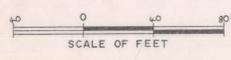


ABERF_123

123

04/04/12

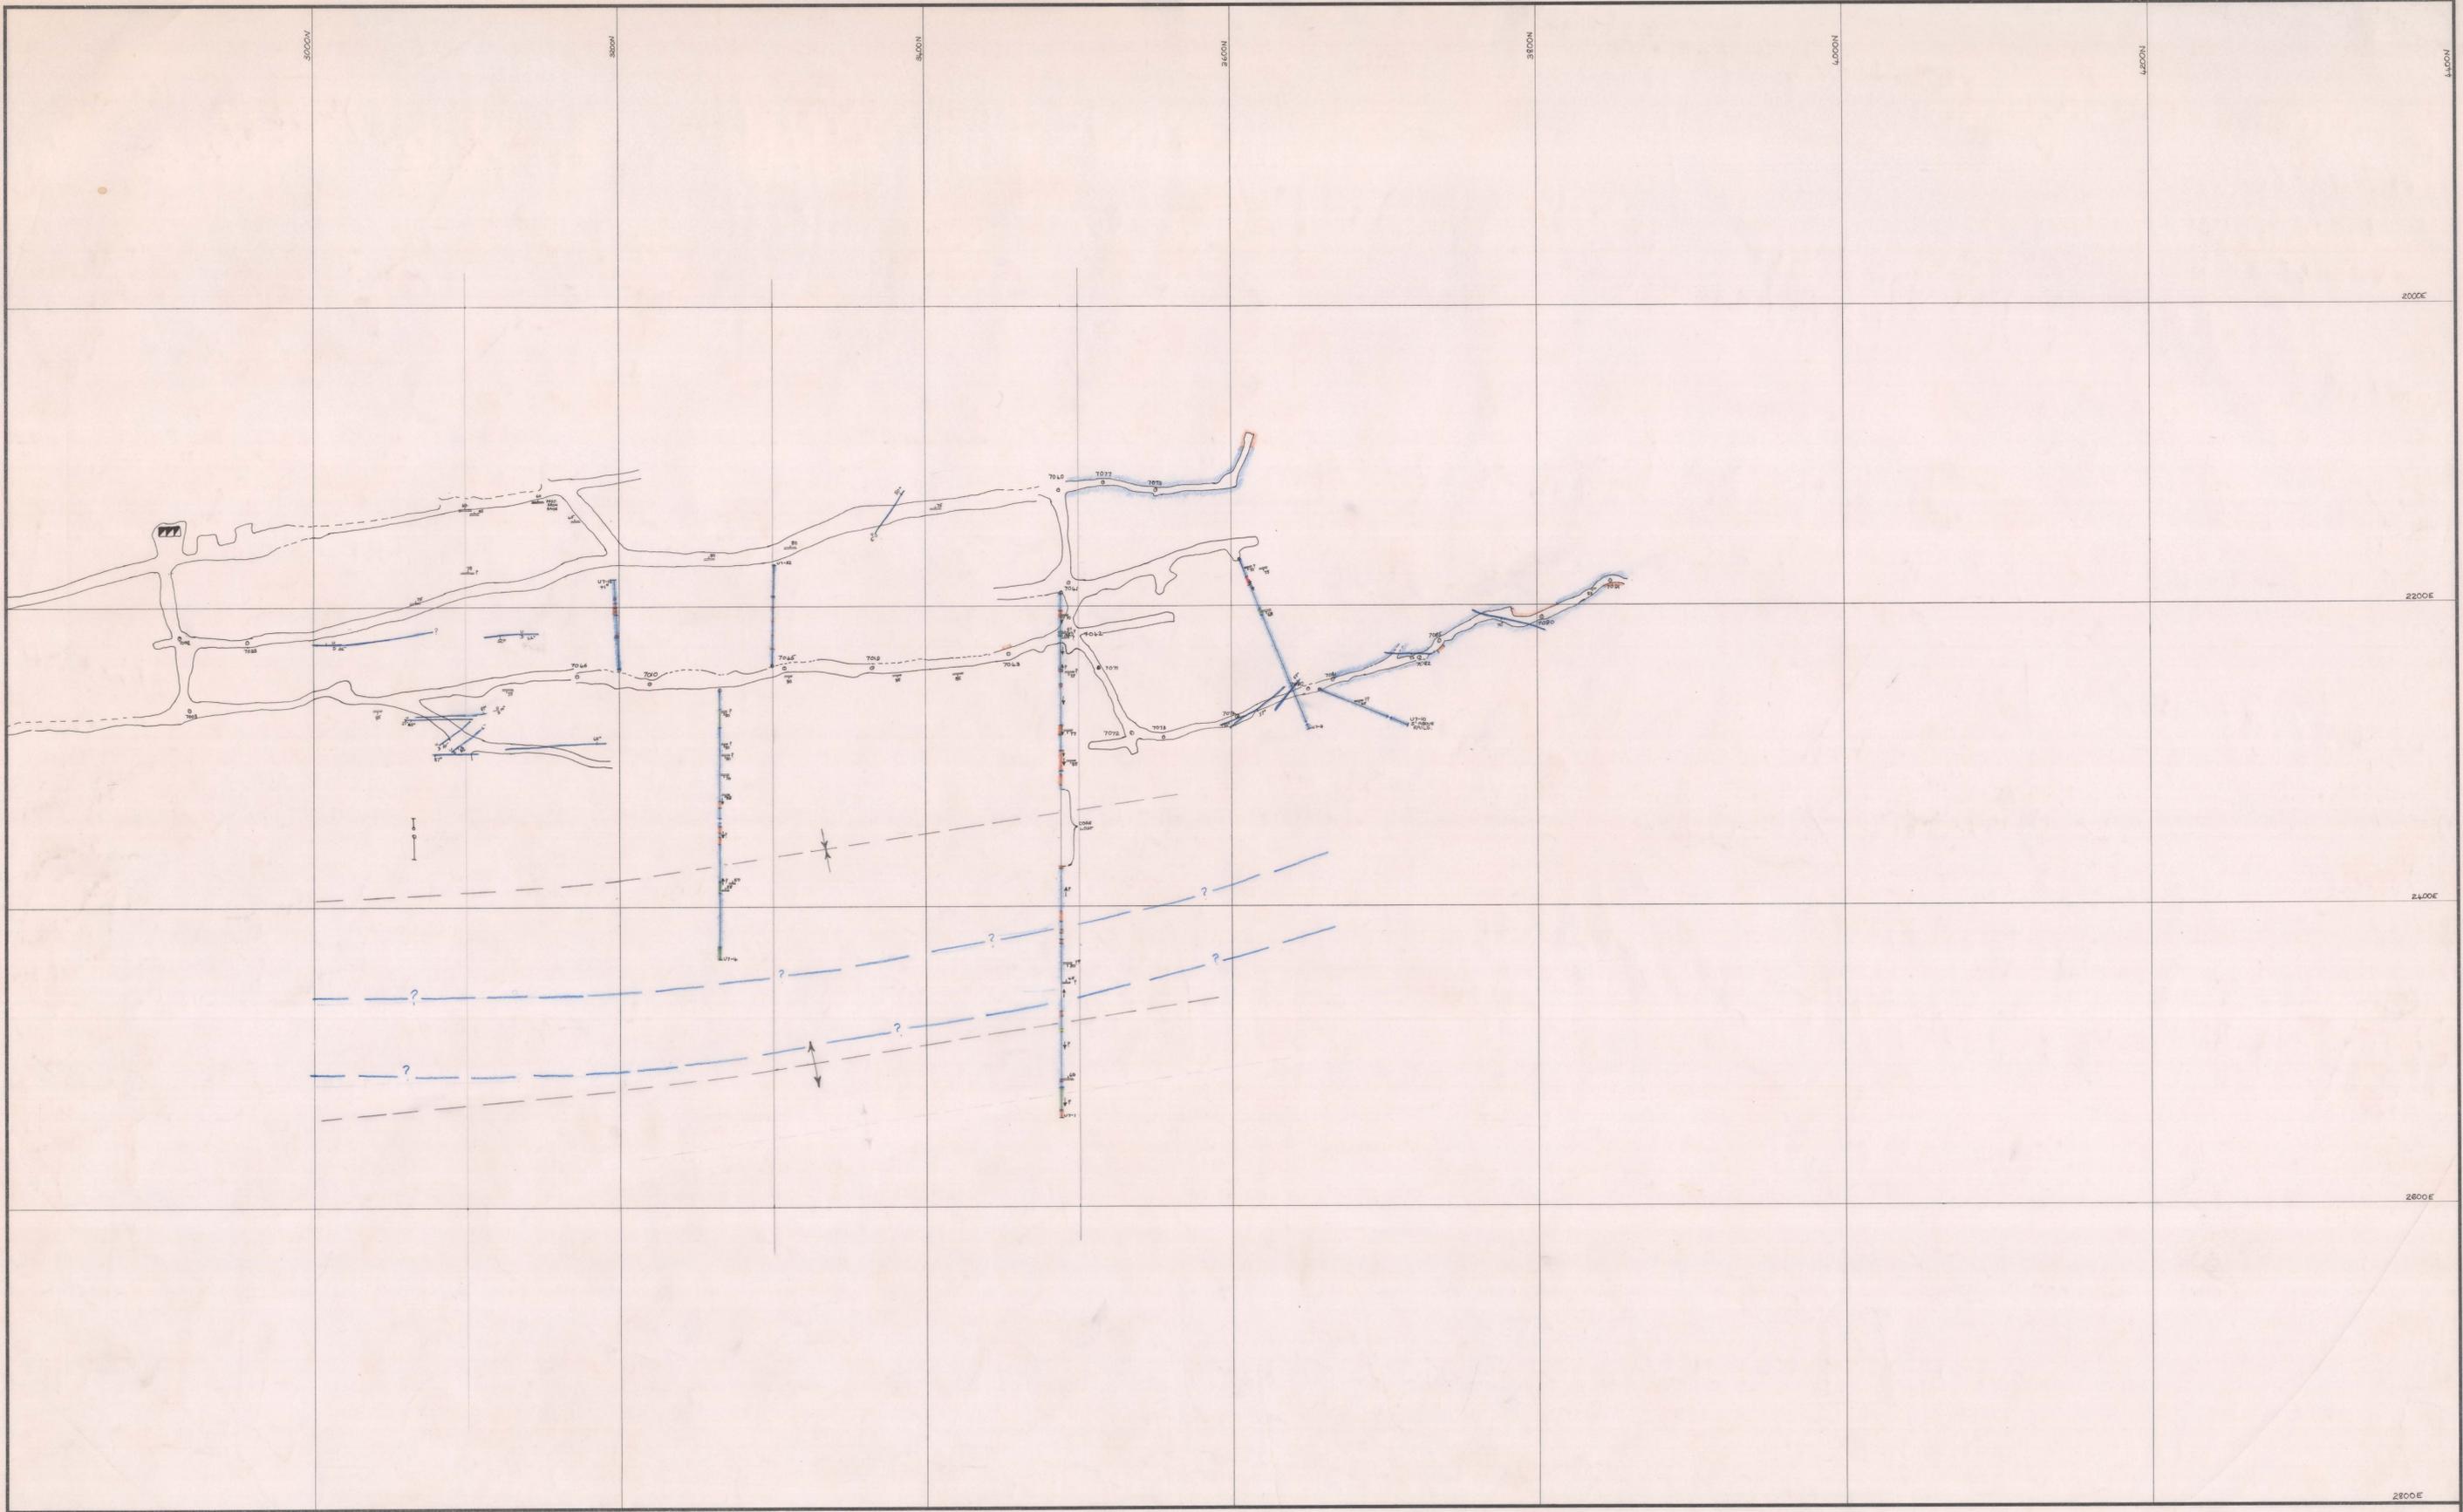

7 LEVEL NORTH - LITHOLOGICAL PLAN

SURVEY	-	-	-	-
GEOLOGY	-	(RMT), MFR	-	-
ENGINEERING	-	-	-	-
DRAWN	-	MFR	-	-
TRACED	-	-	-	-
REFERENCE	-	-	-	-
PRINT No.	-	-	-	-
DRAWING No.-				

DRAWER: