
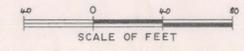


5m

ABERF\_124

124

2020UR

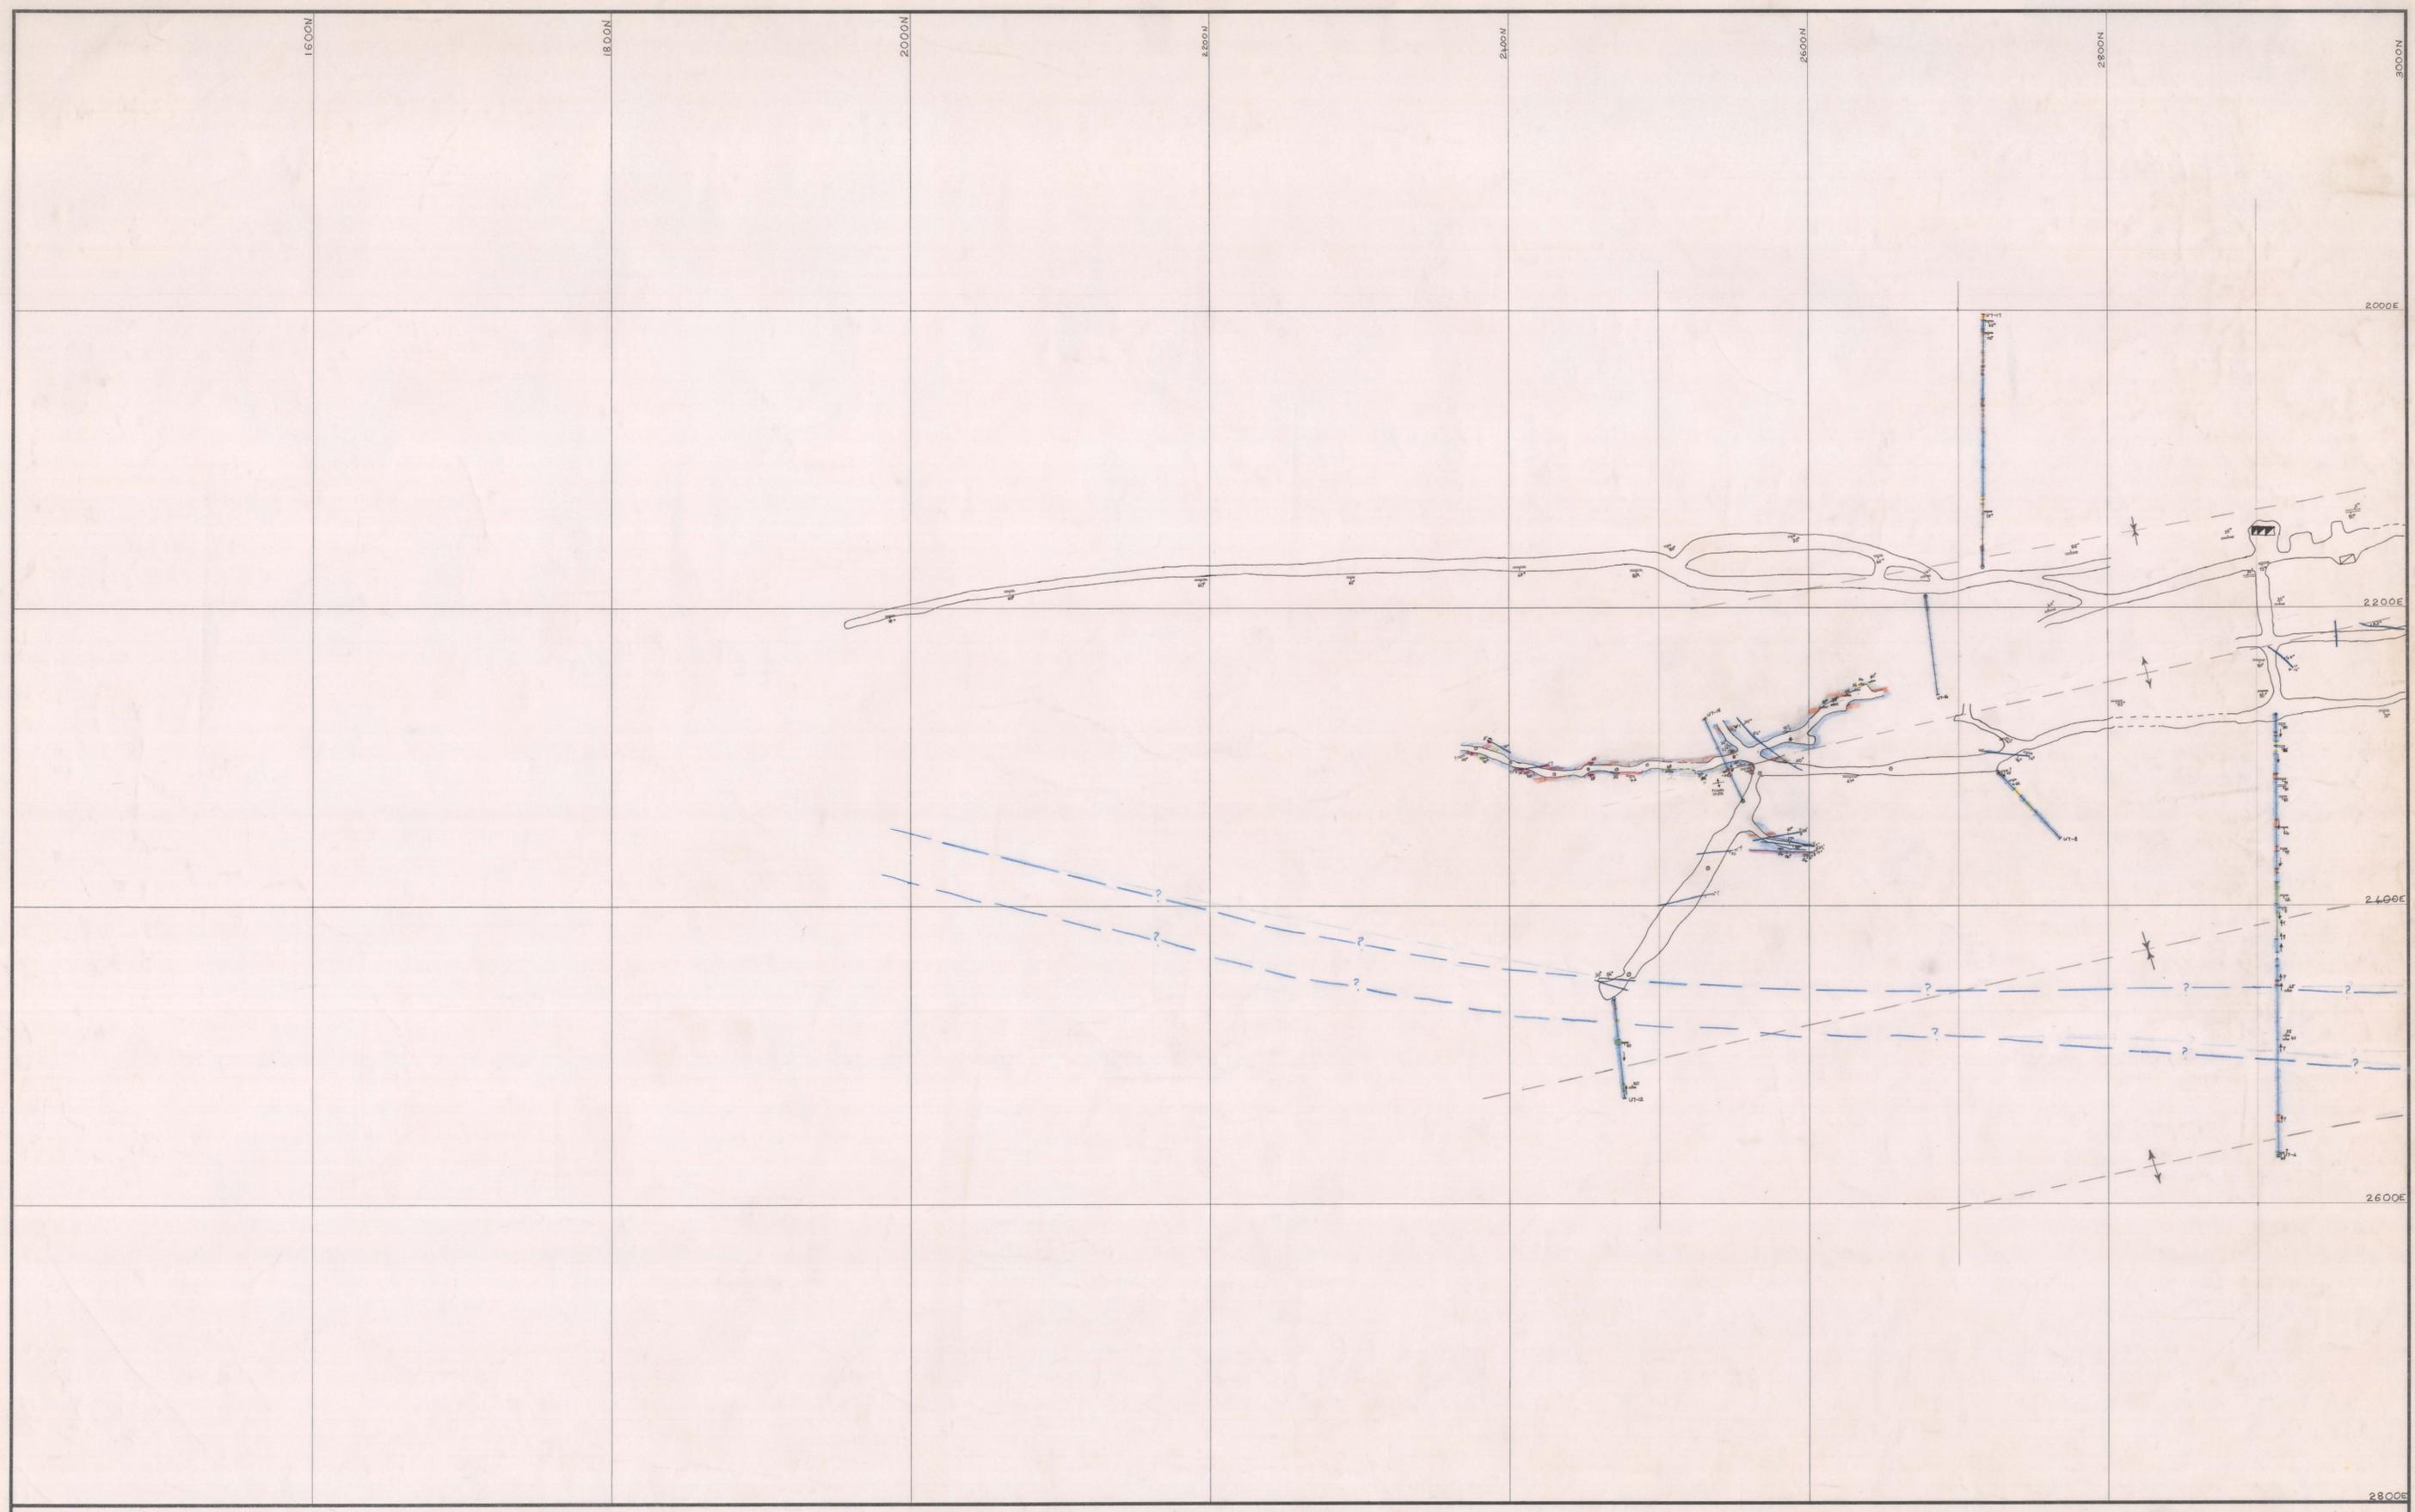

7 LEVEL SOUTH - LITHOLOGICAL PLAN

SURVEY - (M.M.T.) M.R. - / /  
 GEOLOGY - (M.M.T.) M.R. - / /  
 ENGINEERING - M.R. - / /  
 DRAWN - M.R. - / /  
 TRACED - M.R. - / /  
 REFERENCE -  
 PRINT No. -  
**DRAWING No. -**  
 DRAWER: