



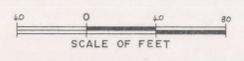

ABERF_126

126

COLOUR

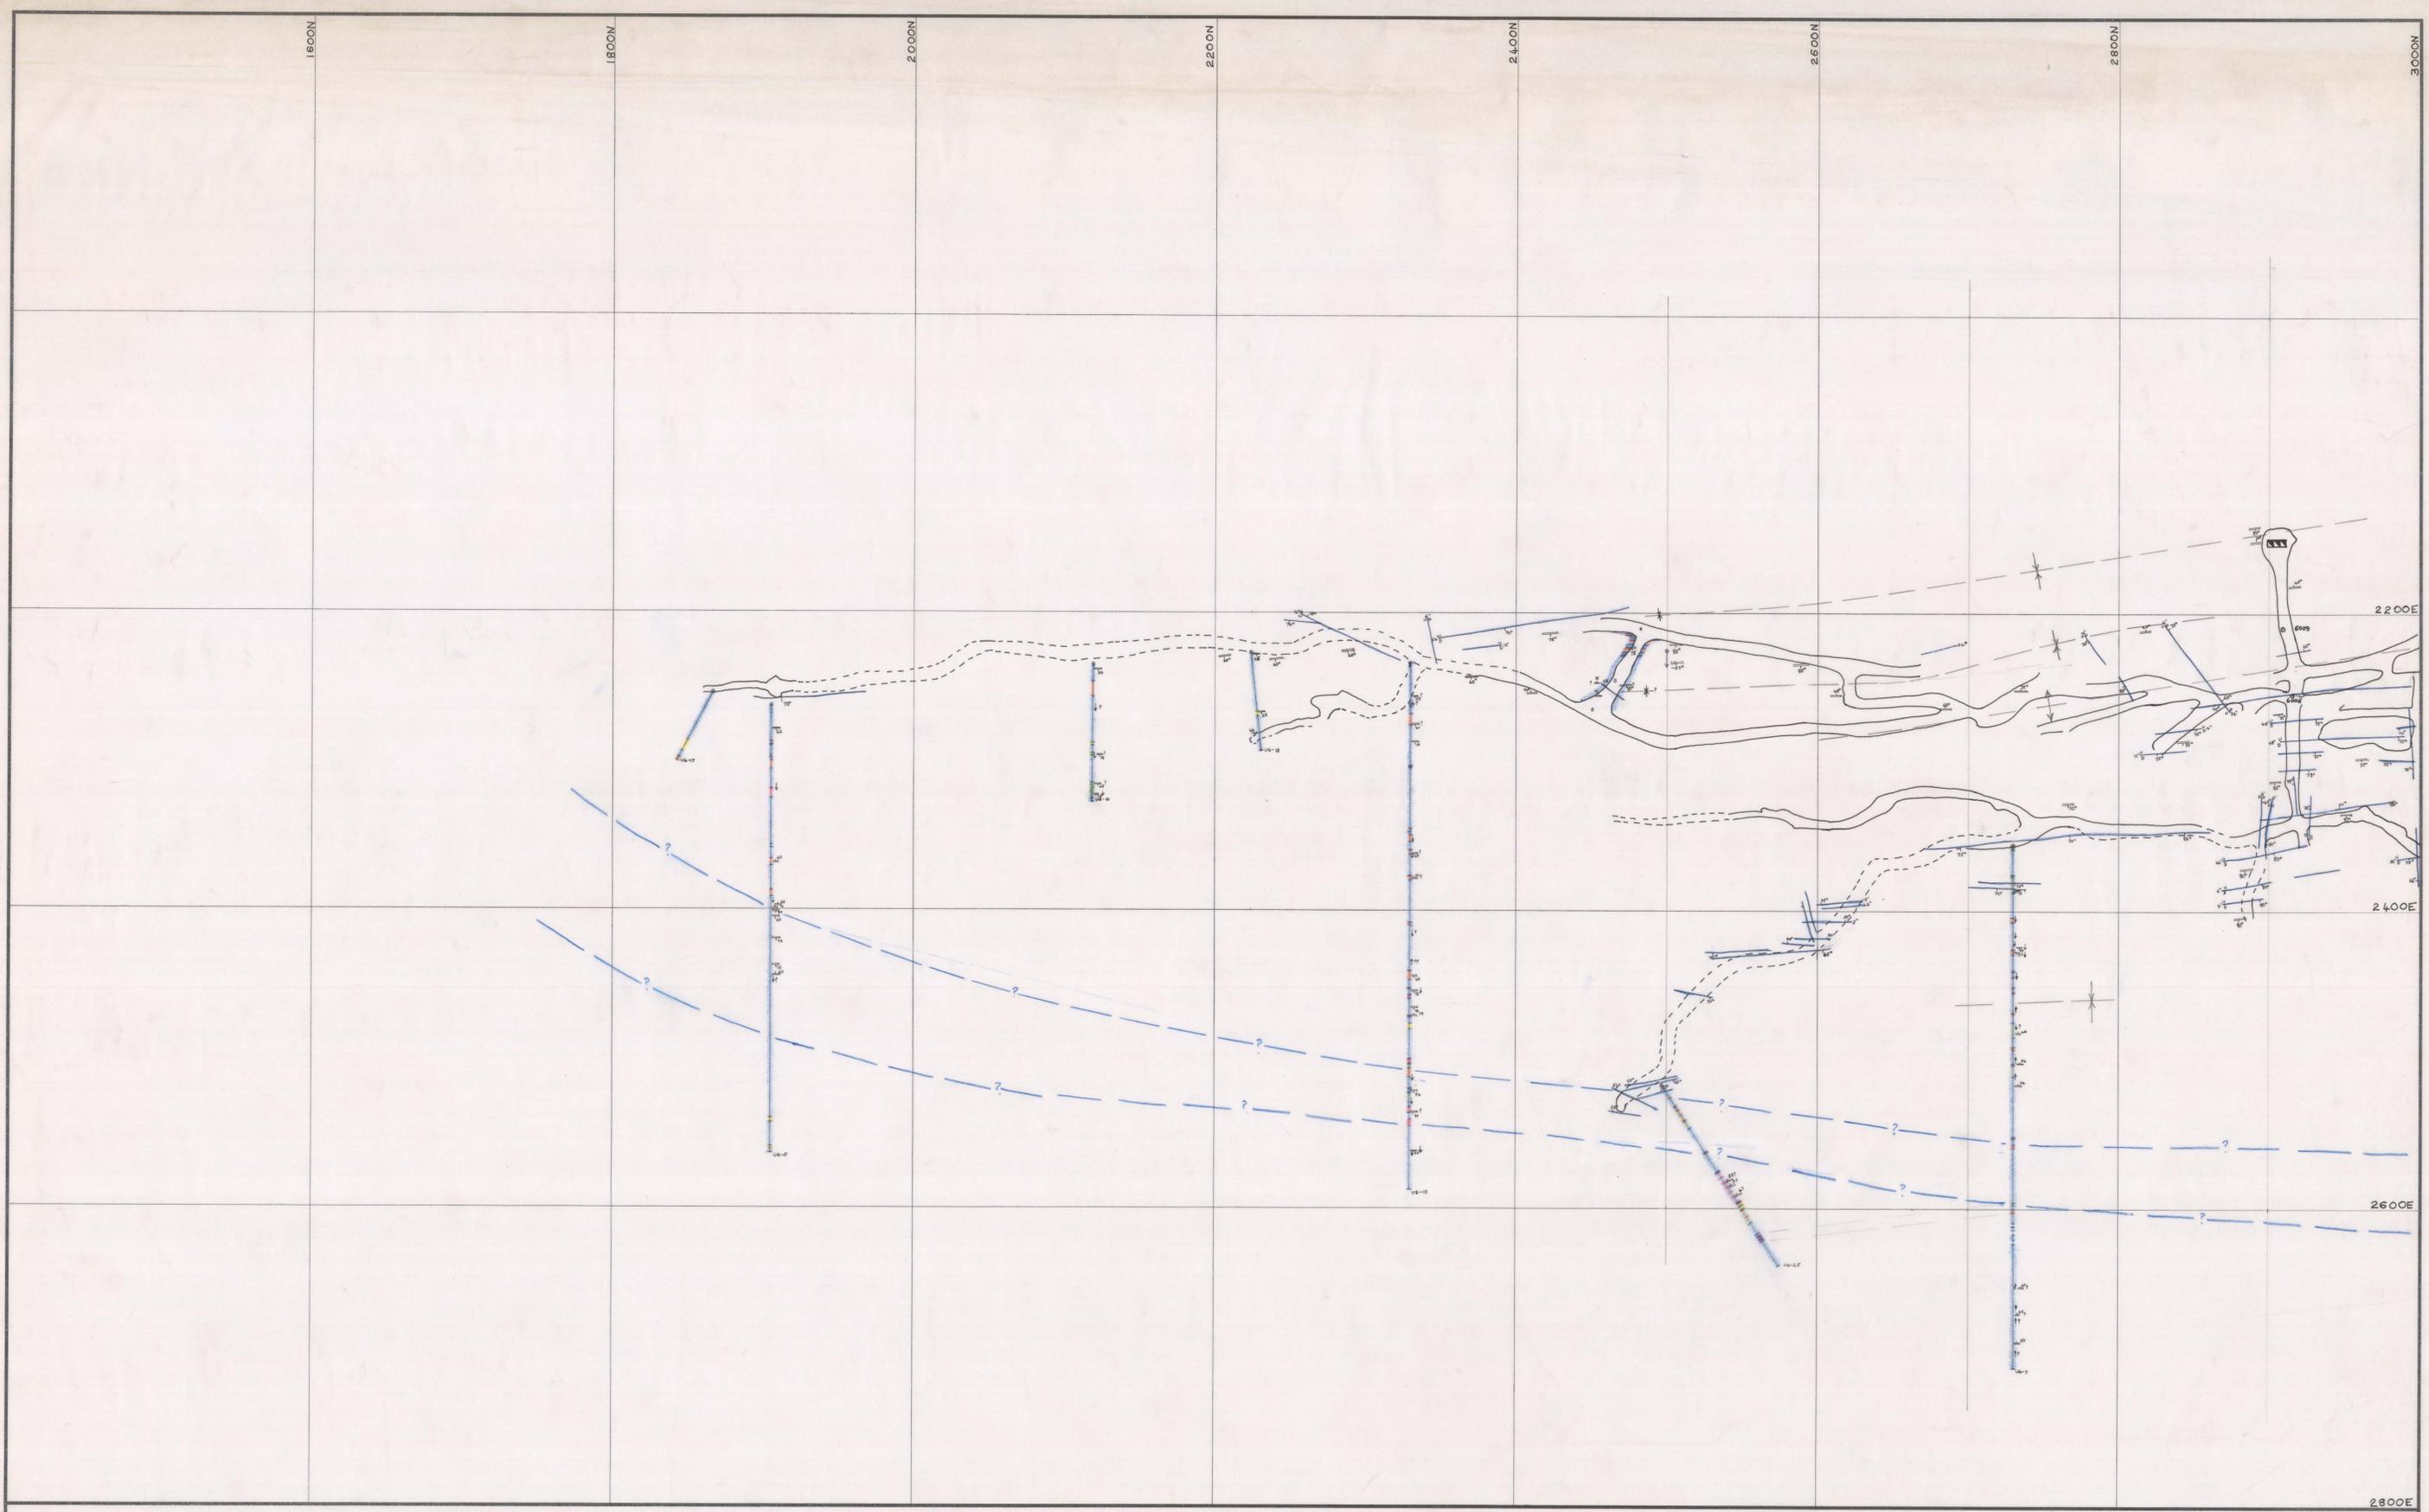

6 LEVEL SOUTH - LITHOLOGICAL PLAN

SURVEY - / /
 GEOLOGY - A.M.T., M.F.R. / / /
 ENGINEERING - / / /
 DRAWN - M.F.R. / / /
 TRACED - / / /
 REFERENCE - / / /
 PRINT No. / / /
DRAWING No. -
 DRAWER: