




ABERF_129

129

COLLUM

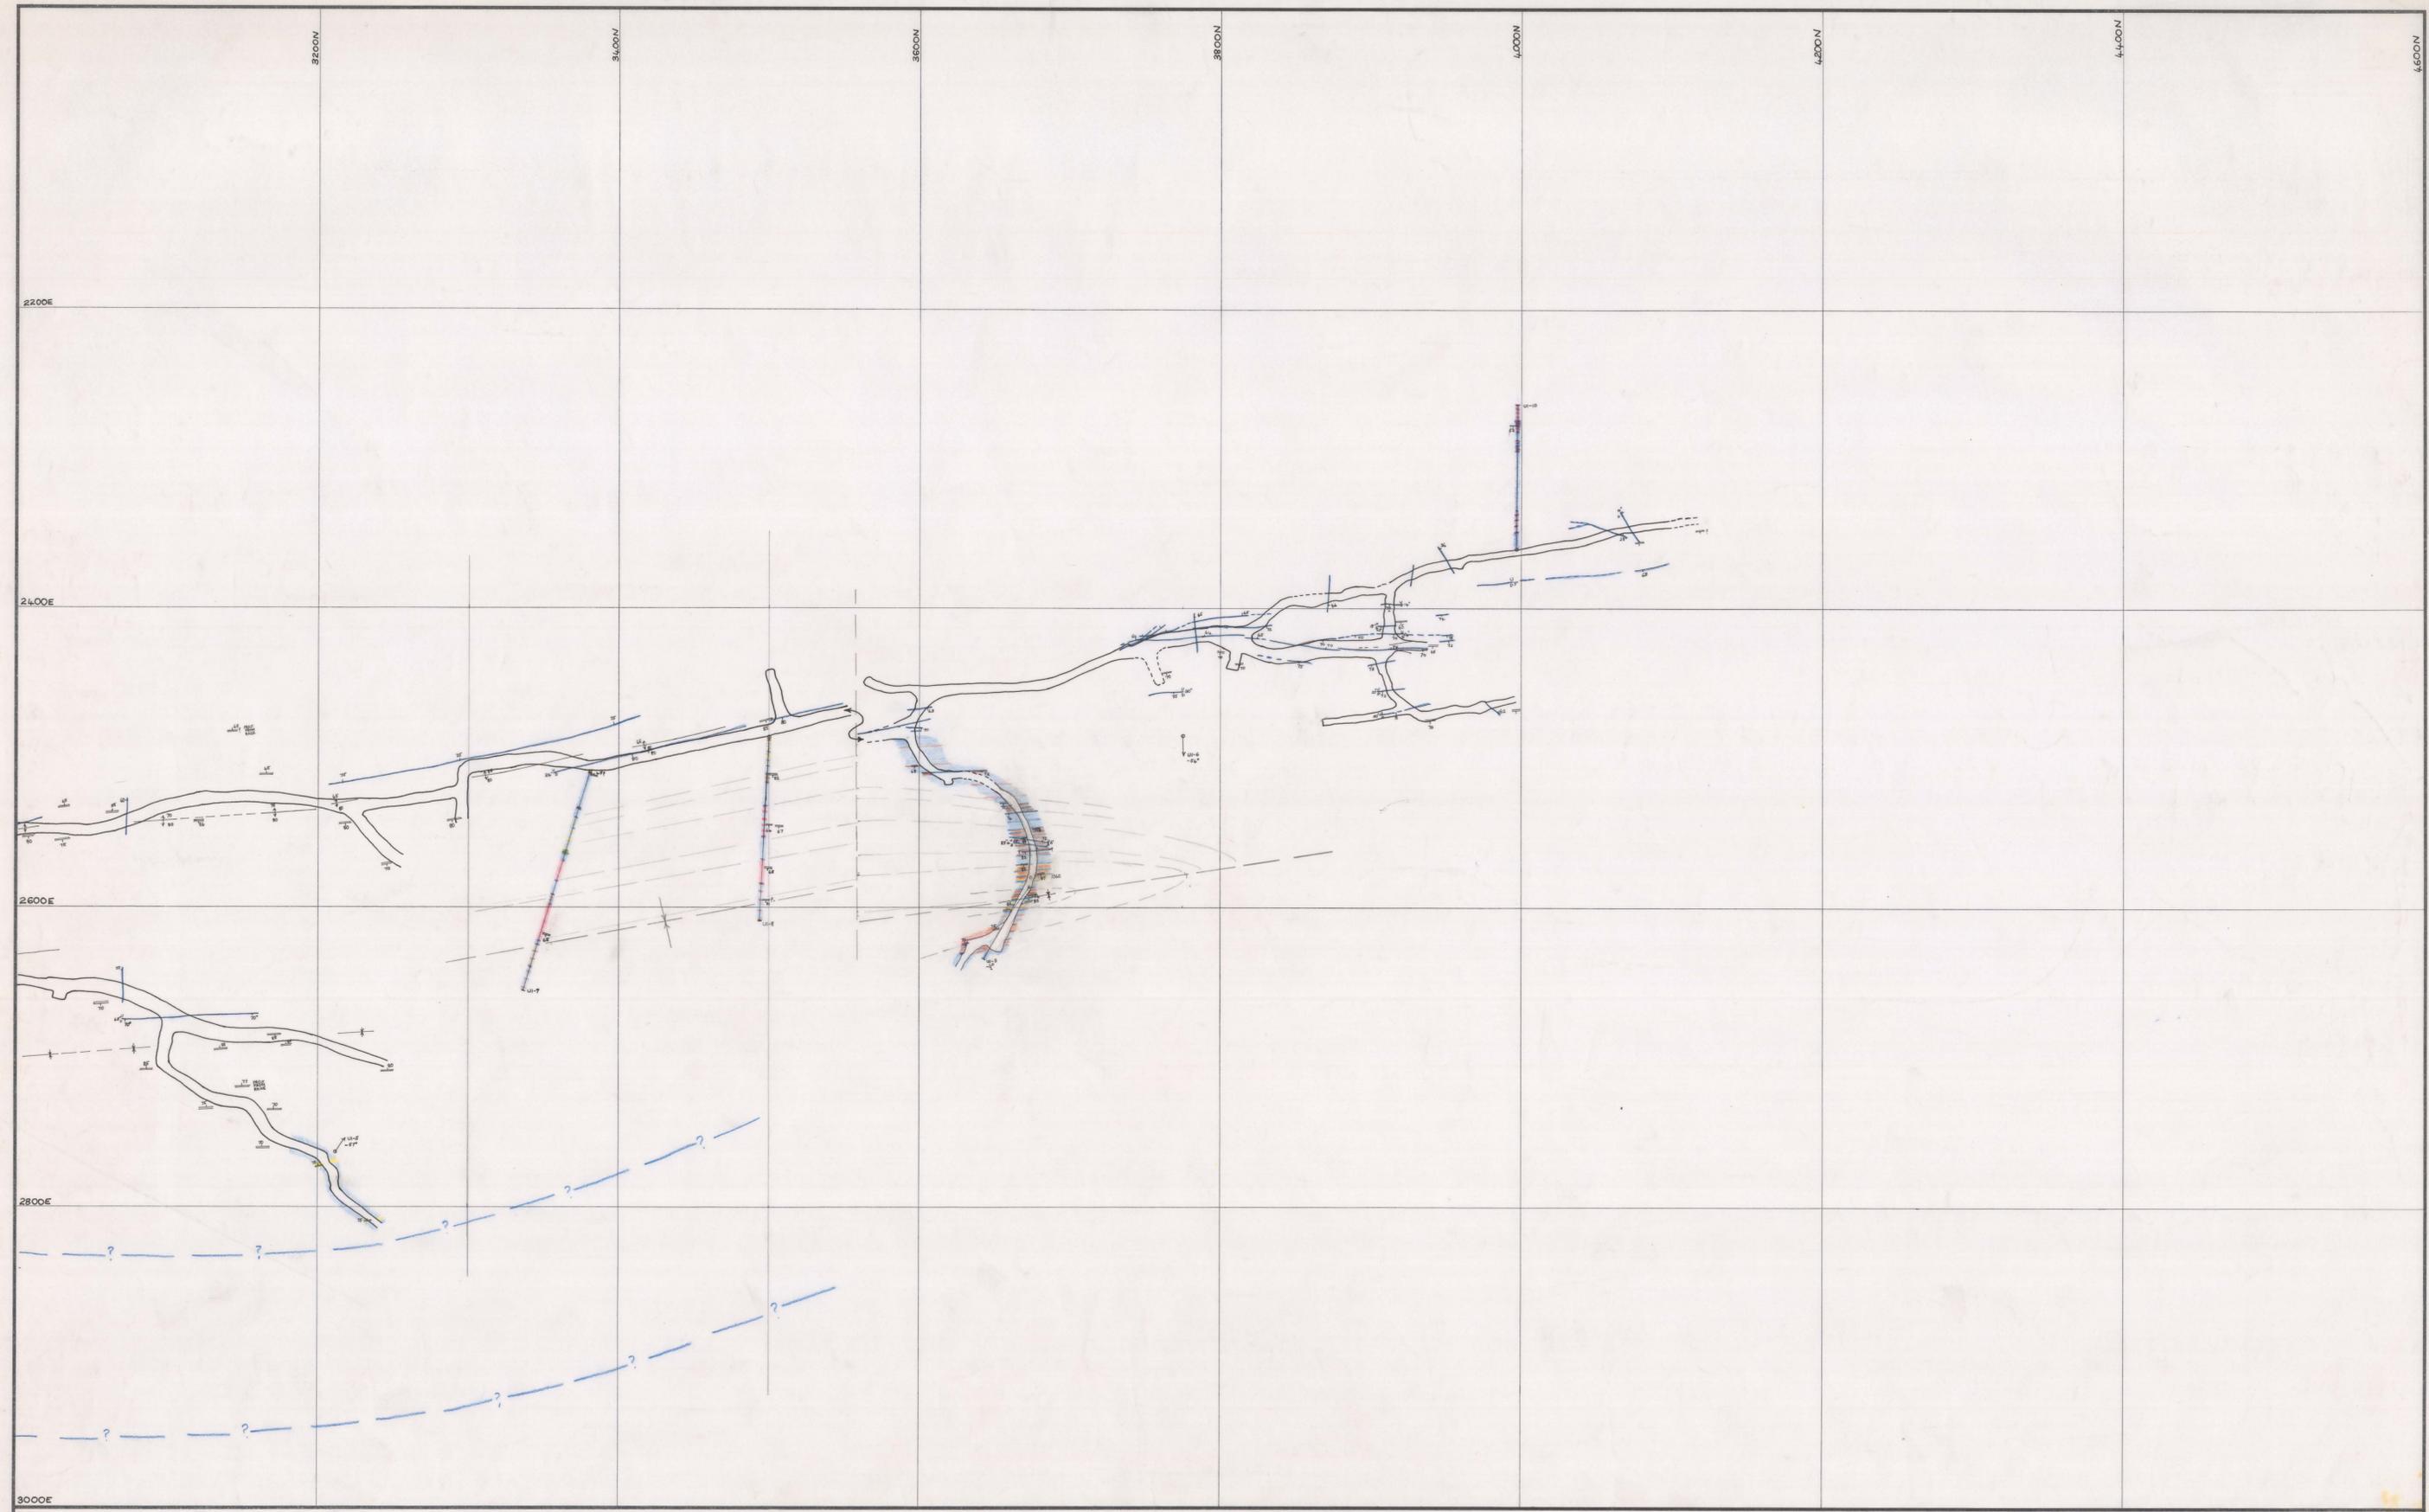

LEVEL NORTH - LITHOLOGICAL PLAN

SURVEY - - - / /
 GEOLOGY - M.F.R. - - / /
 ENGINEERING - - - / /
 DRAWN - M.F.R. - - / /
 TRACED - - - / /
 REFERENCE - - - / /
 PRINT No. - - - / /
DRAWING No. -

DRAWER: