
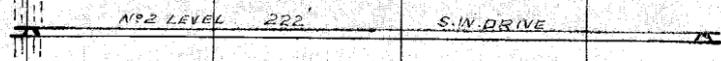
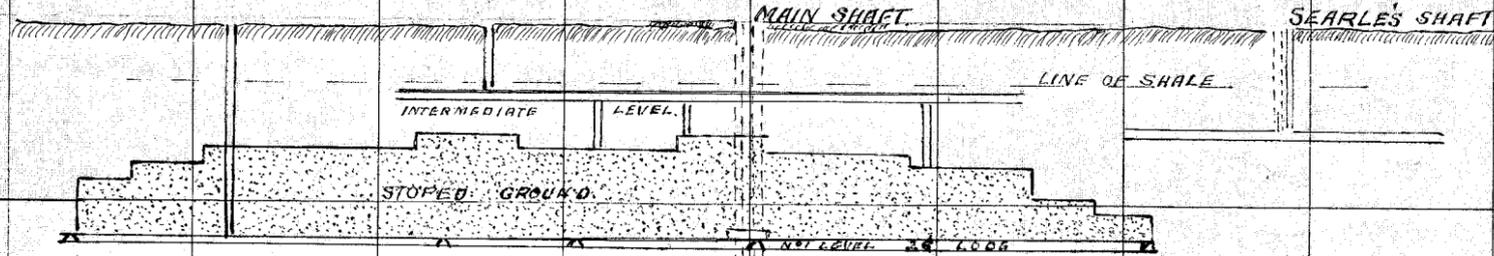


5 cm

LONGITUDINAL SECTIONS

ABERFOYLE TIN N.L. ROSSARDEN. TAS

*Stope on vein
West of 26 Tade.*

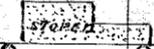

Scale 100 = 1"

