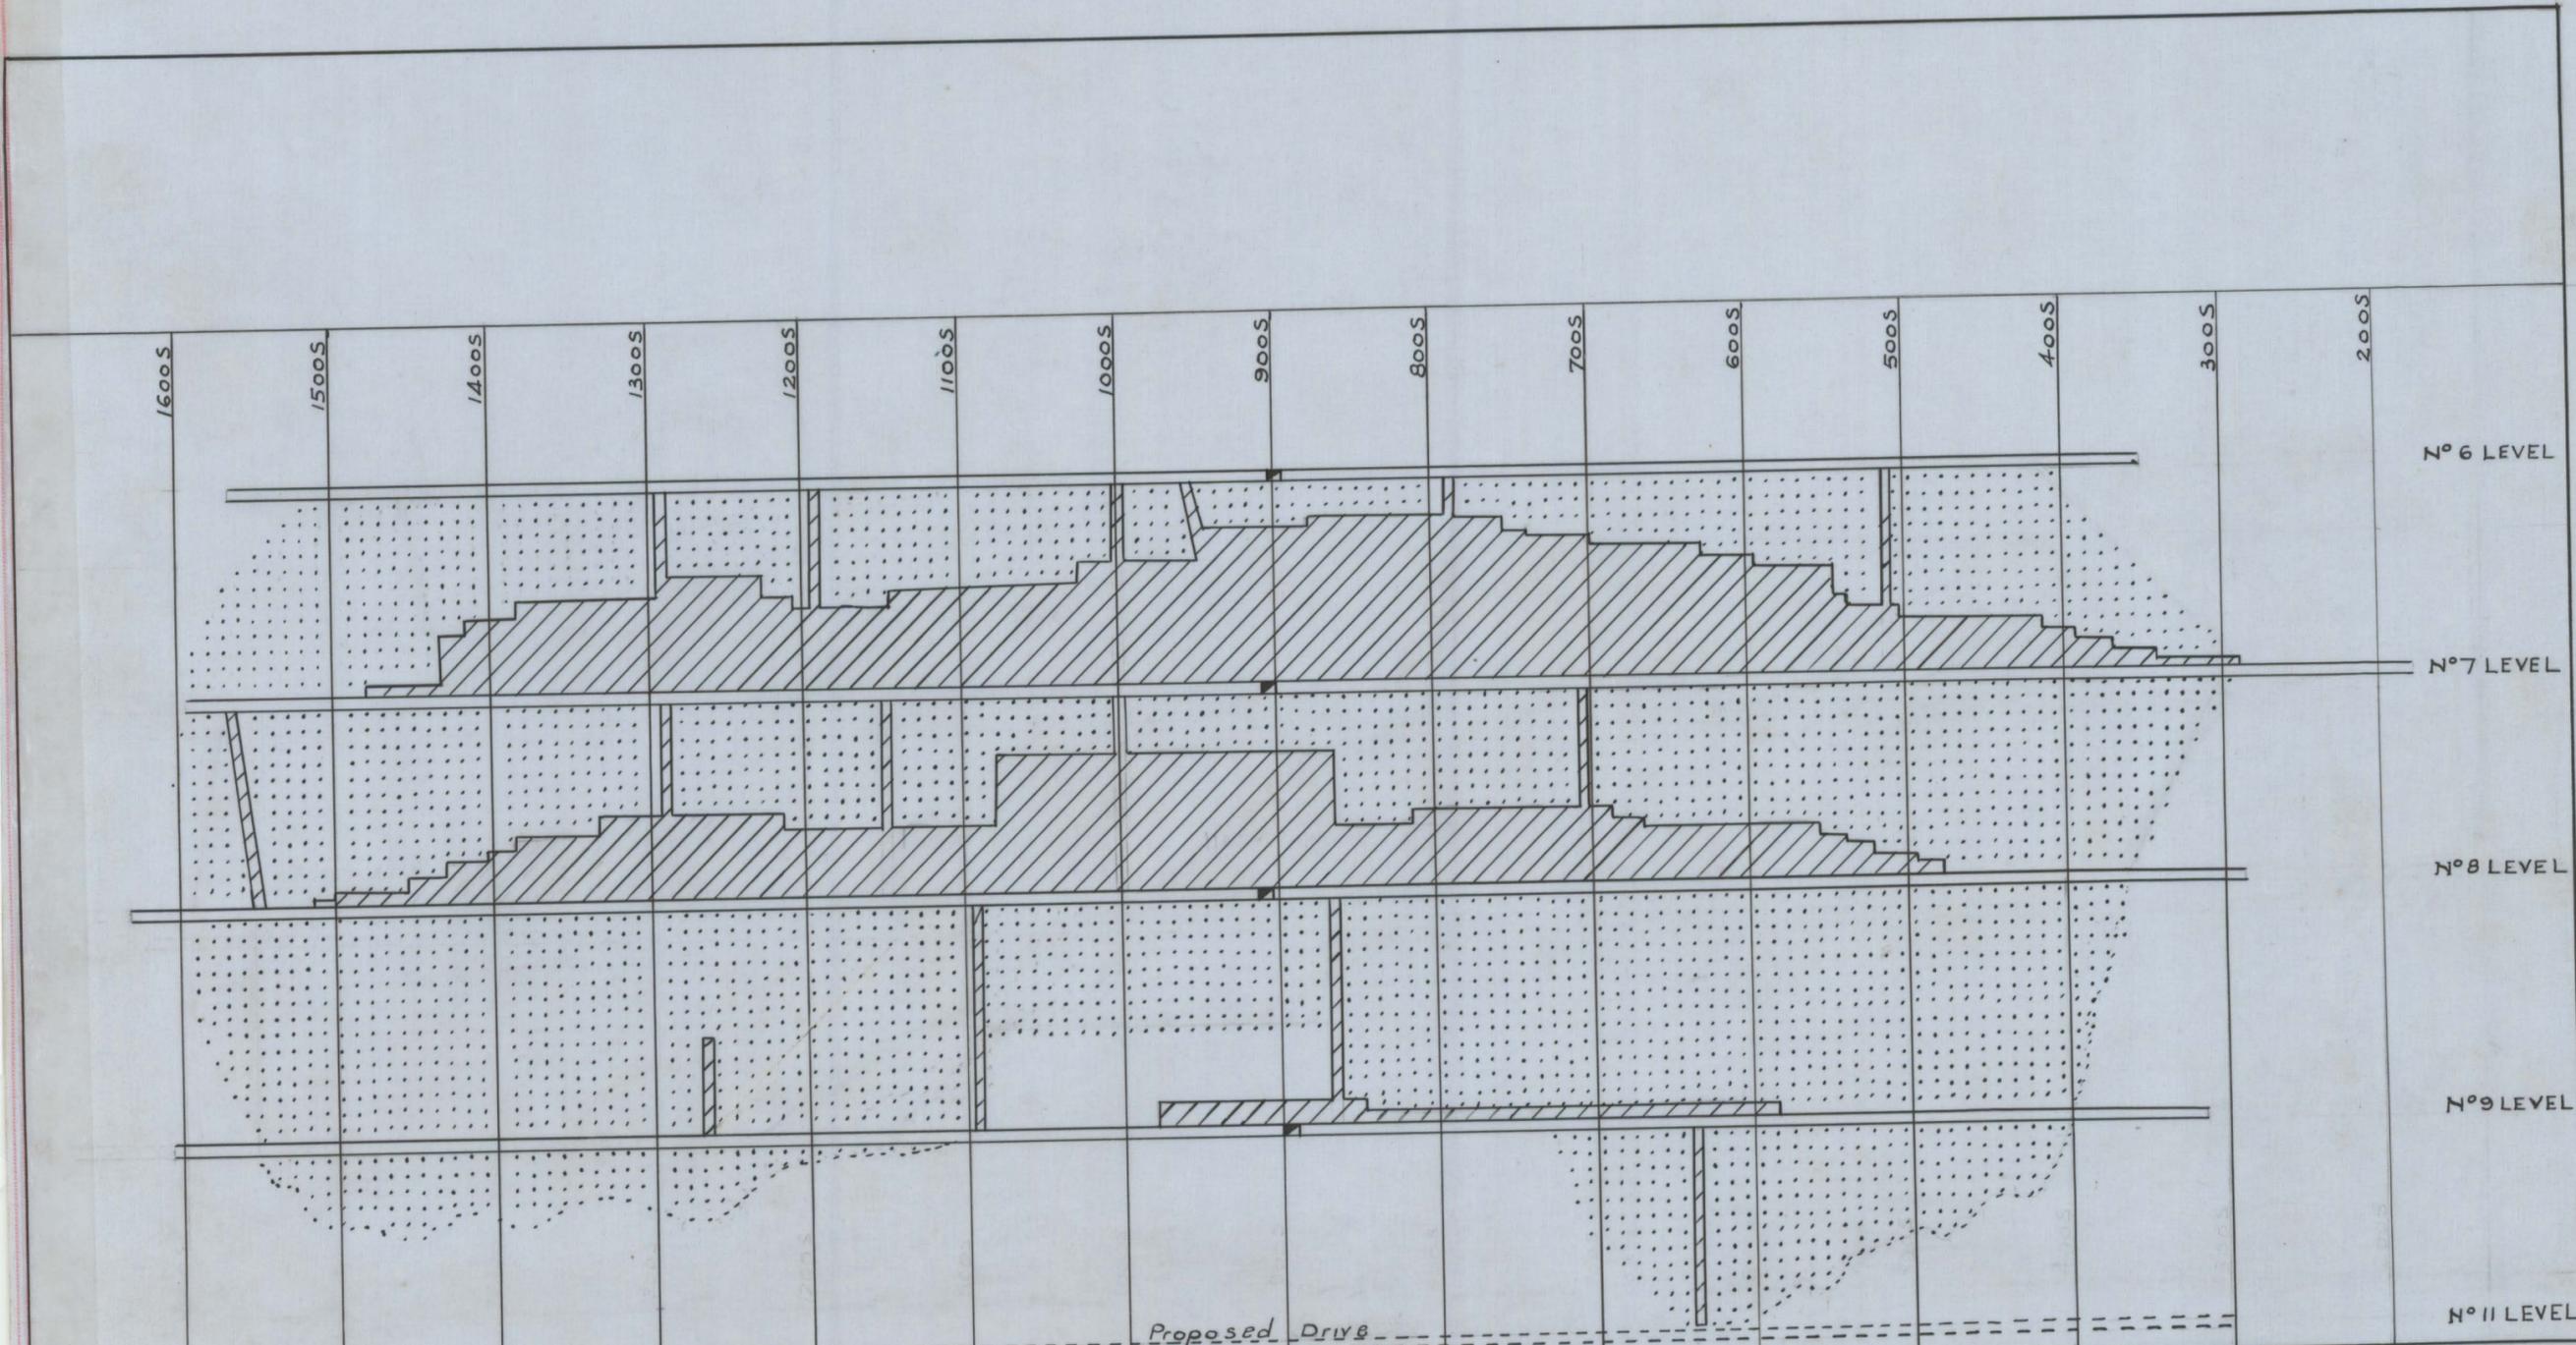


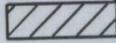
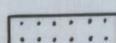
161

5 cm



ABERFOYLE TIN N.L.  
 LONGITUDINAL SECTION  
 MAIN VEIN

DRAWN <i>HAMILTON</i>	SCALE 1"=100'
TRACED <i>H</i>	DATE 16-9-55

**LEGEND**  
 Ore mined out   
 Ore yet to be mined 

ABERF\_161