





ABERF_163

163

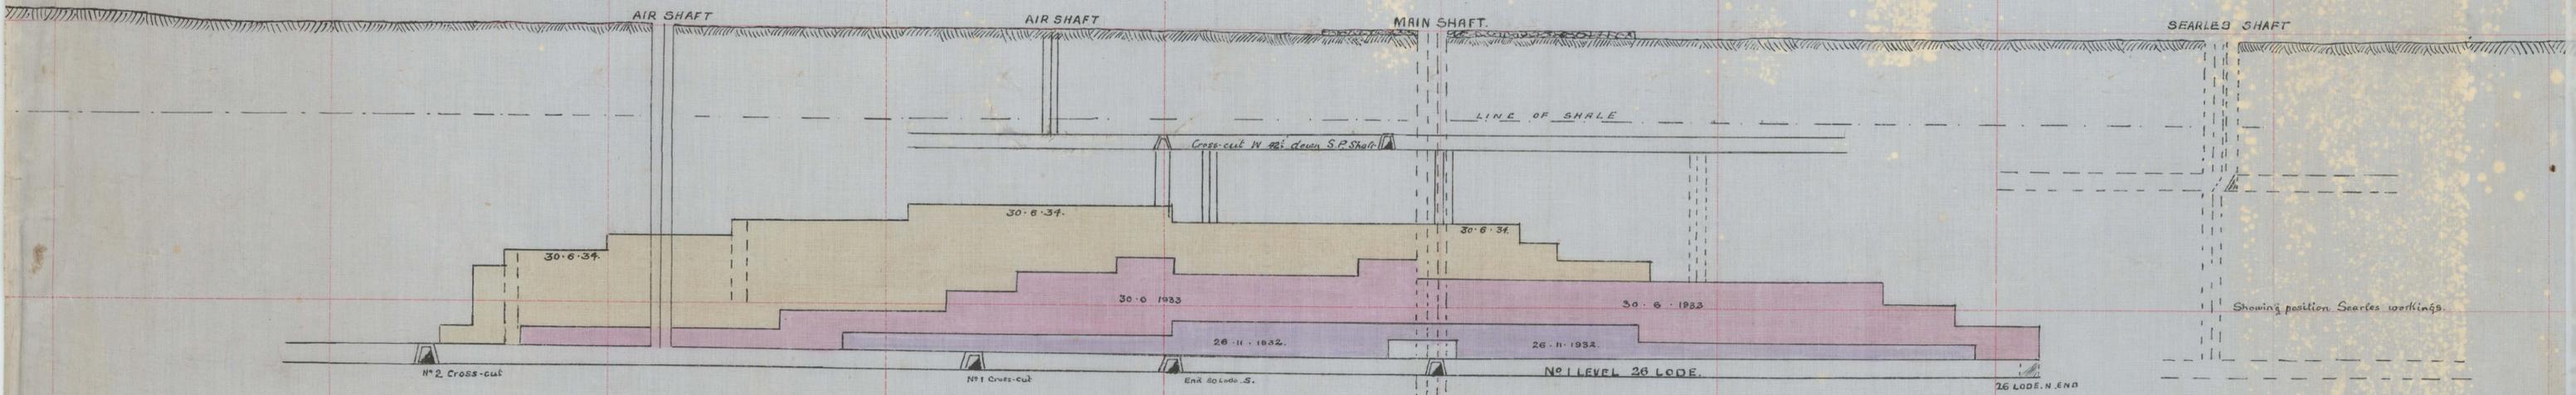

LON' L SECTIONS OF ABERFOYLE TIN N. L.

LOOKING WEST. SCALE 30' = 1"

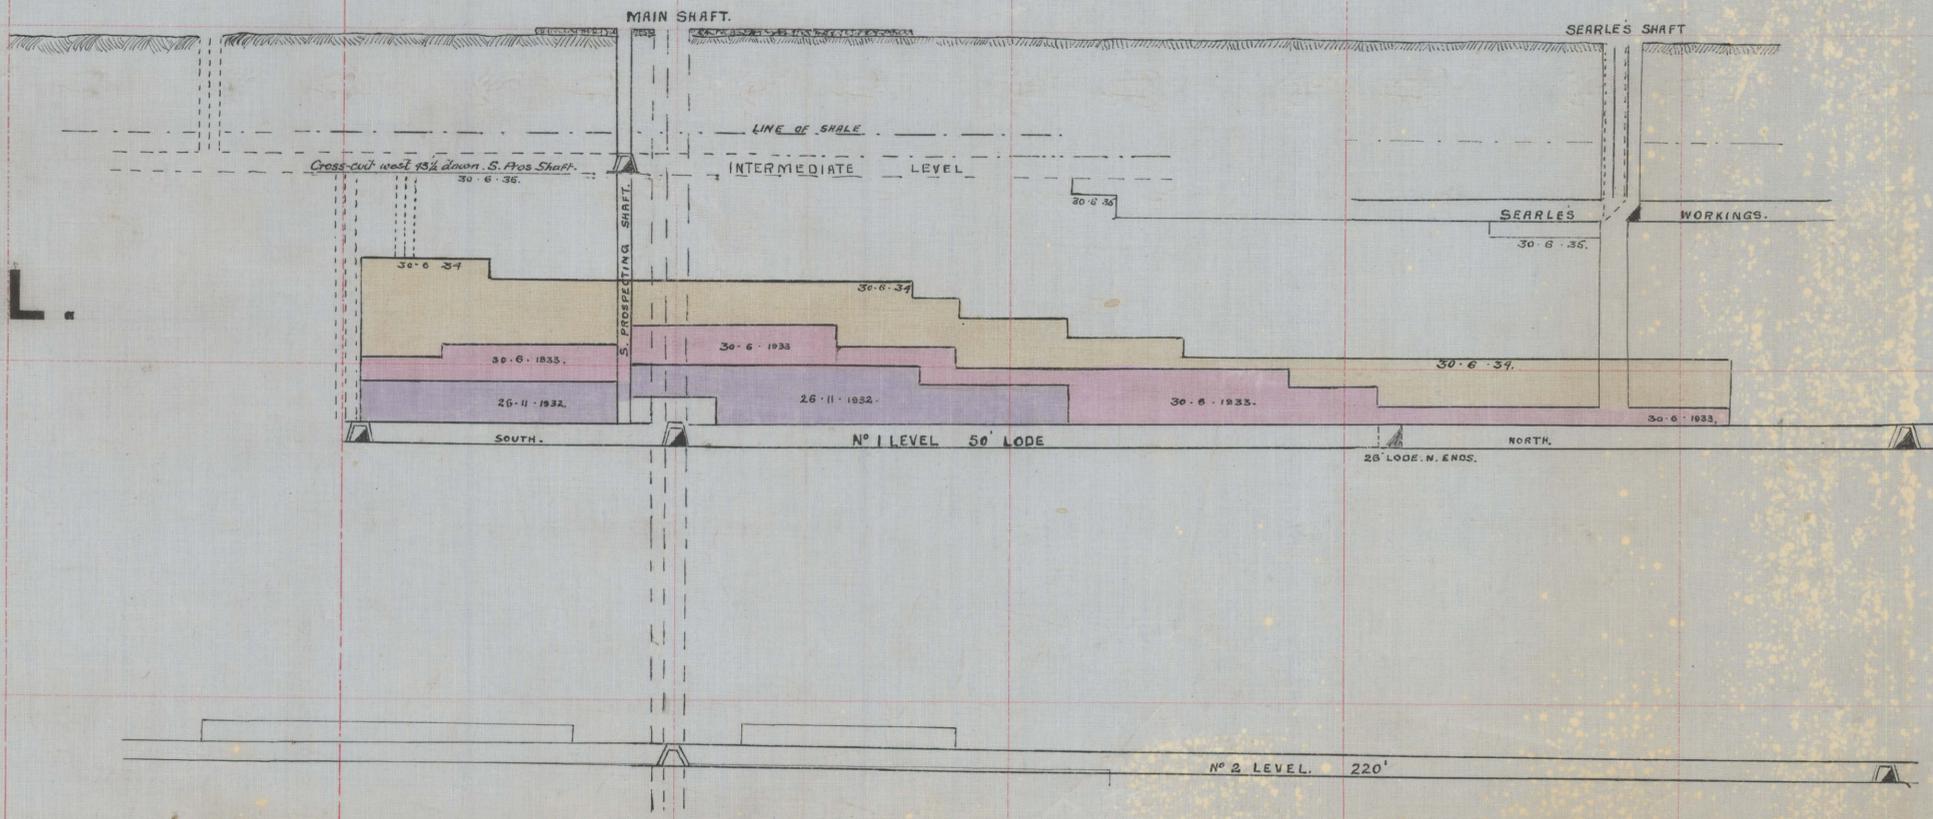

ABERFOYLE TIN N.L.
STOREY'S CREEK, TAS.

A. Schell
Min. Manager
18/7/1935. + 2/8/34.