


5 cm

ABERF_170

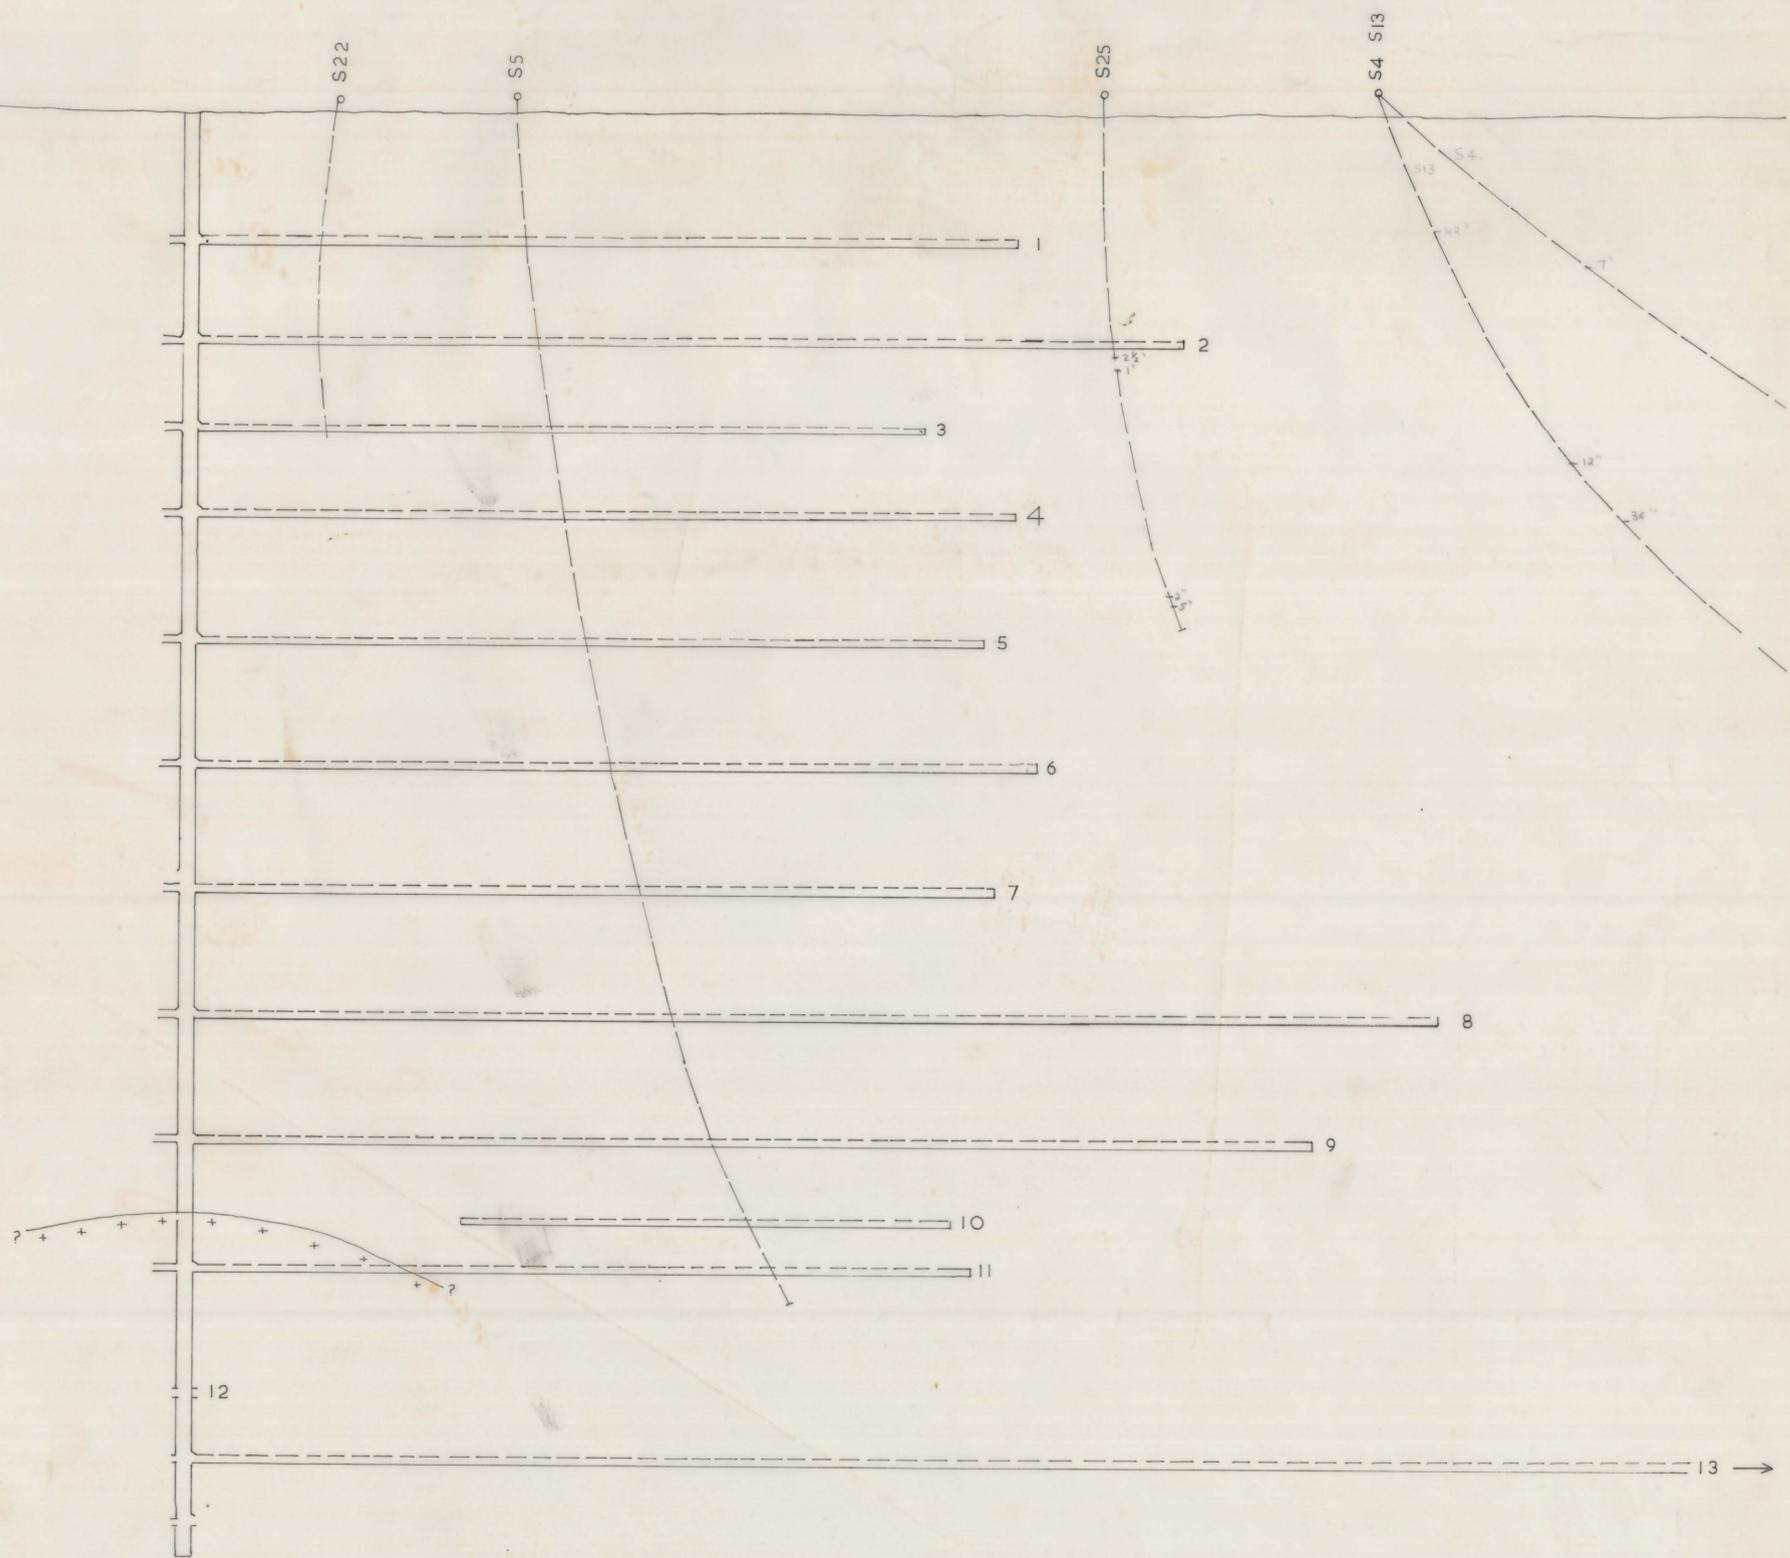

ITEM	DESCRIPTION	LENGTH	MAT'L	REQ'D
ABERFOYLE MANAGEMENT PTY. LTD. 505 ST. KILDA ROAD, 3004				
<u>ABERFOYLE MINE 1971</u>				
DRAWN	A.S.F.	DRAWING No.		DWG. SIZE
CHECKED		SCL 14		B
APPROVED				
DATE	6/8/71	ISSUE		A
SCALE	1"=100'			

LONGITUDINAL PROJECTION ALONG			
1578 E			
ISSUE	CHANGE RECORD	DATE	INIT

170