


APPROX. TRAINING - SEE FIELD NOTES FOR DETAILS

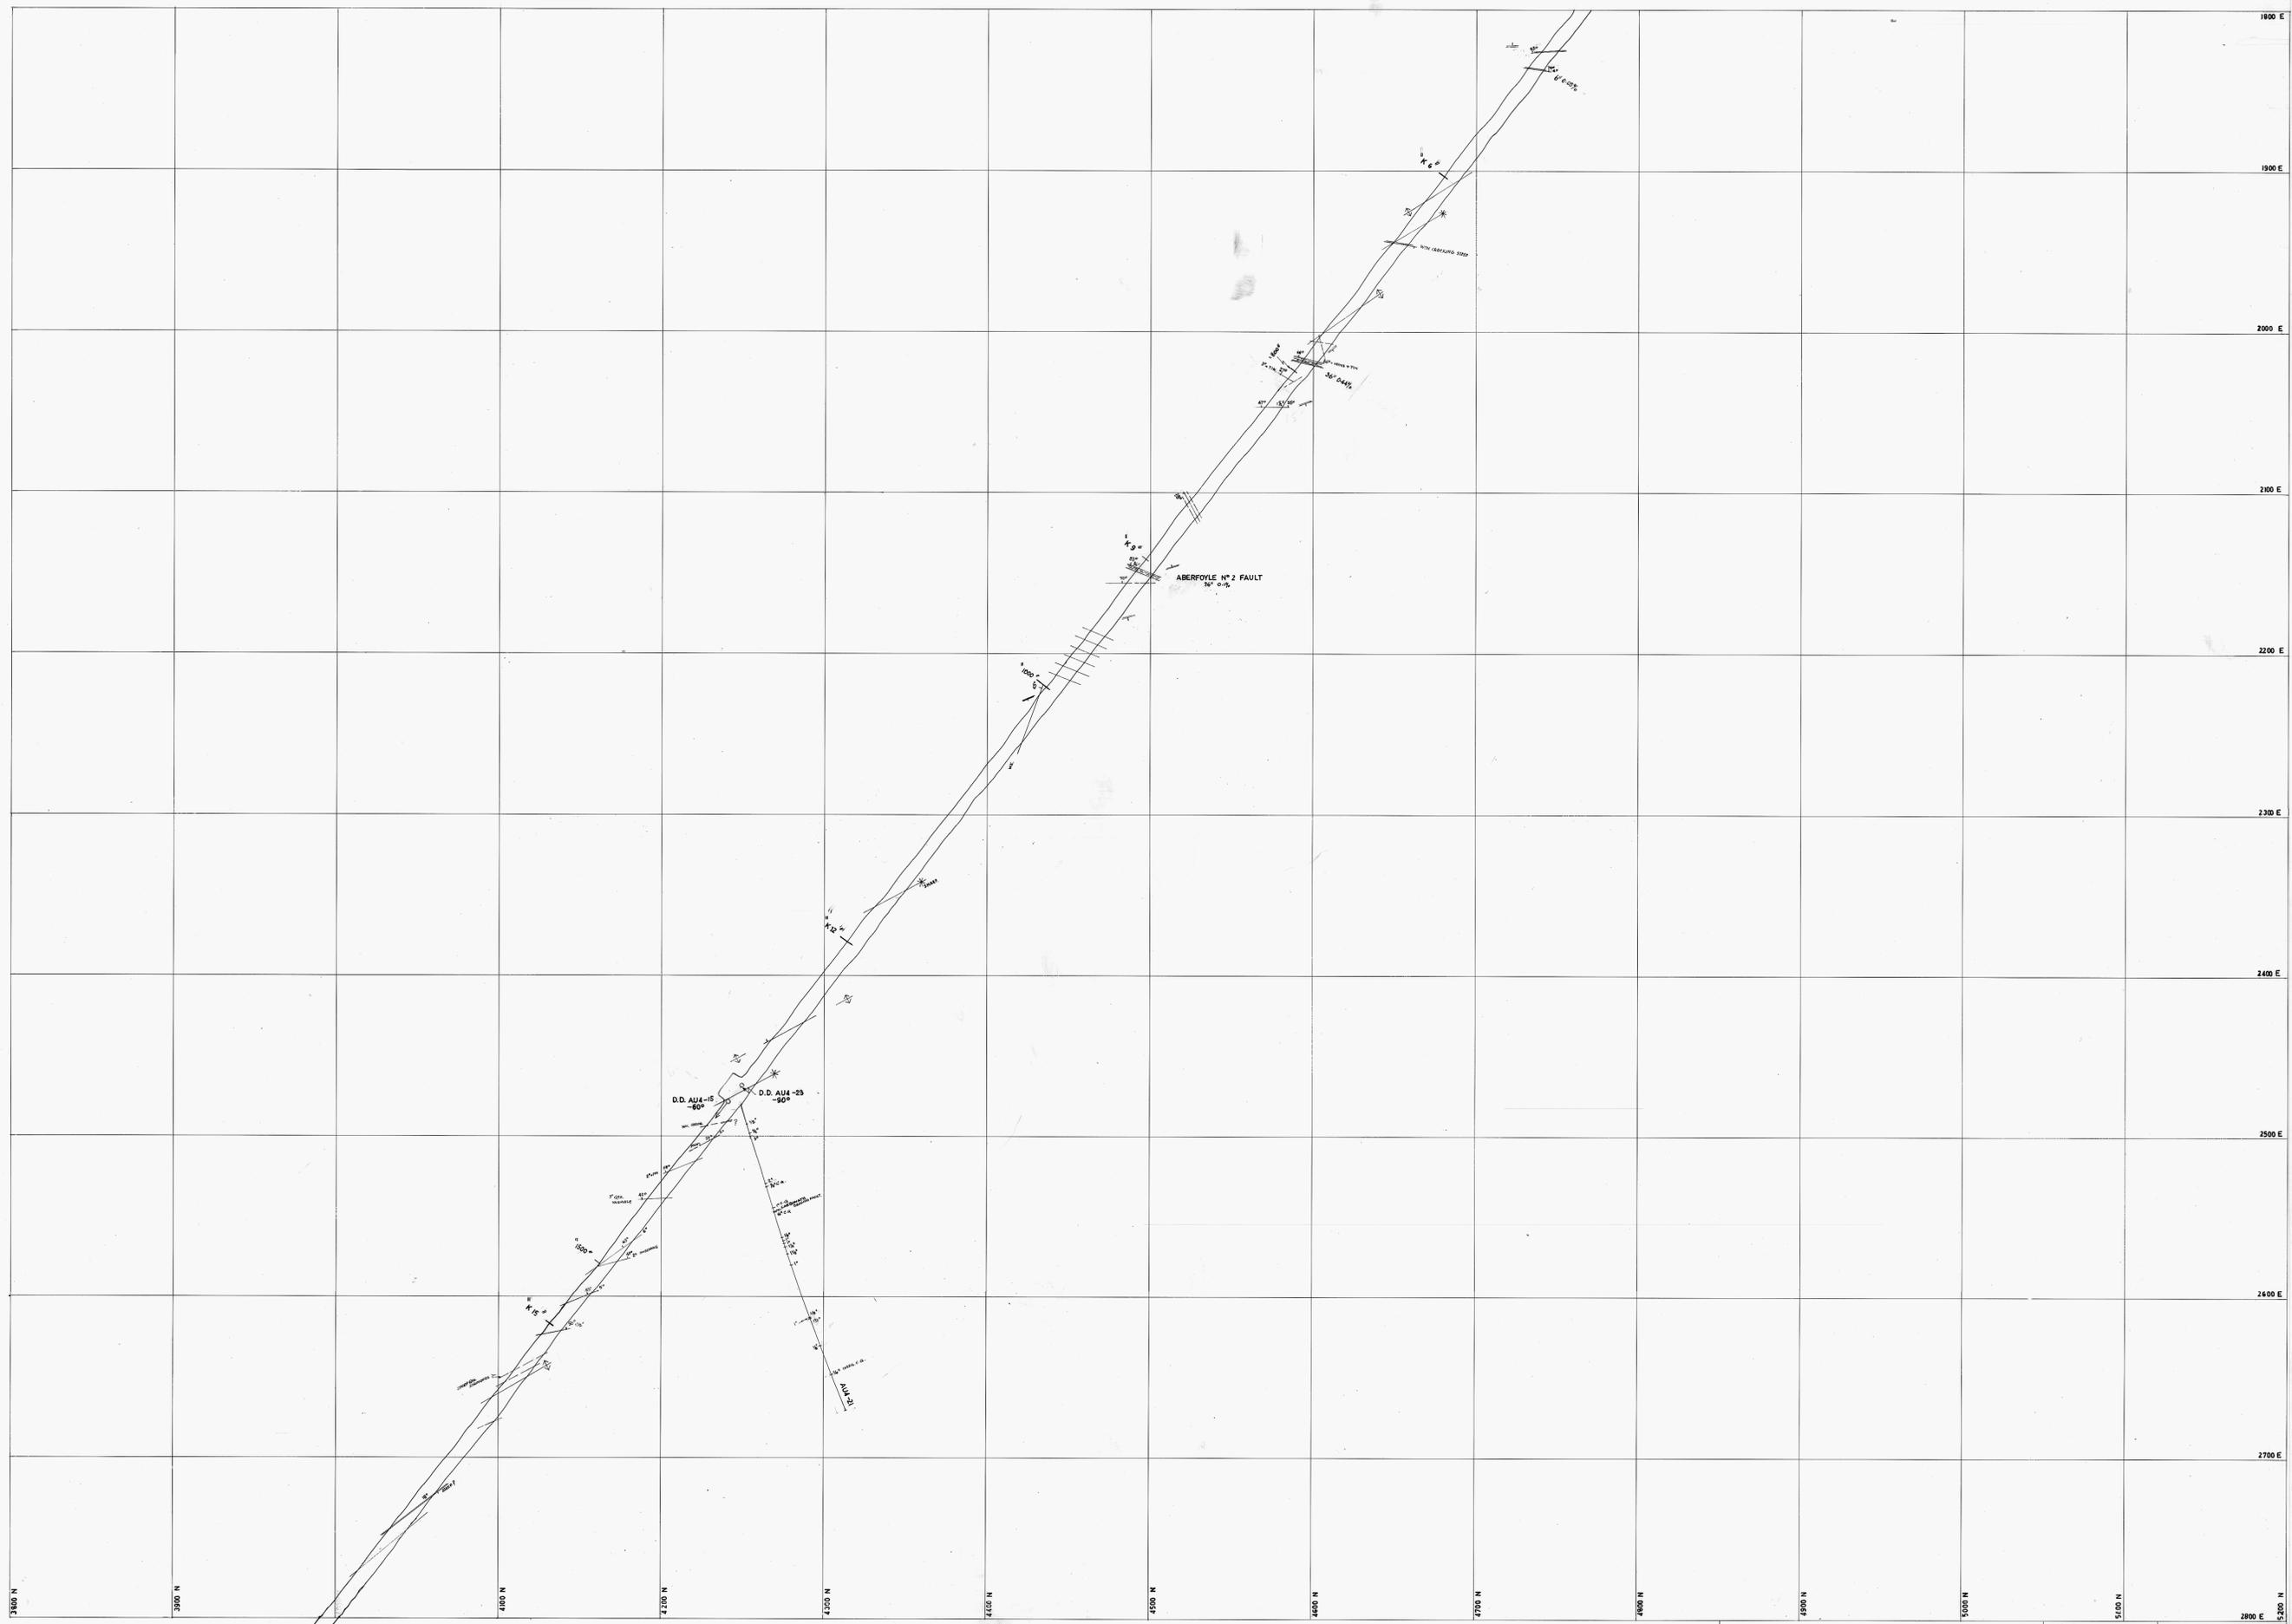

ABERFOYLE No 2 FAULT
 30° 00' 00" N
 100' 00" 00"

AB-207-G

DARK : BEST AVAILABLE SURVEY.
 FAINT : SUBJECT TO RE-SURVEY.
 GEOLOGICALLY ADAPTED FROM EXISTING MAPPING BY VARIOUS
 WORKERS AND SUBJECT TO RE-MAPPING IN CRITICAL AREAS.

ABERFOYLE TIN N.L.
ABERFOYLE MINE

DRAWN
CHECKED
SCALE
40 FEET TO 1 INCH

4 LEVEL
 (No 2 ADIT)
 R.L. 1816-19

AS 2576