


50m

AB-208-G

208

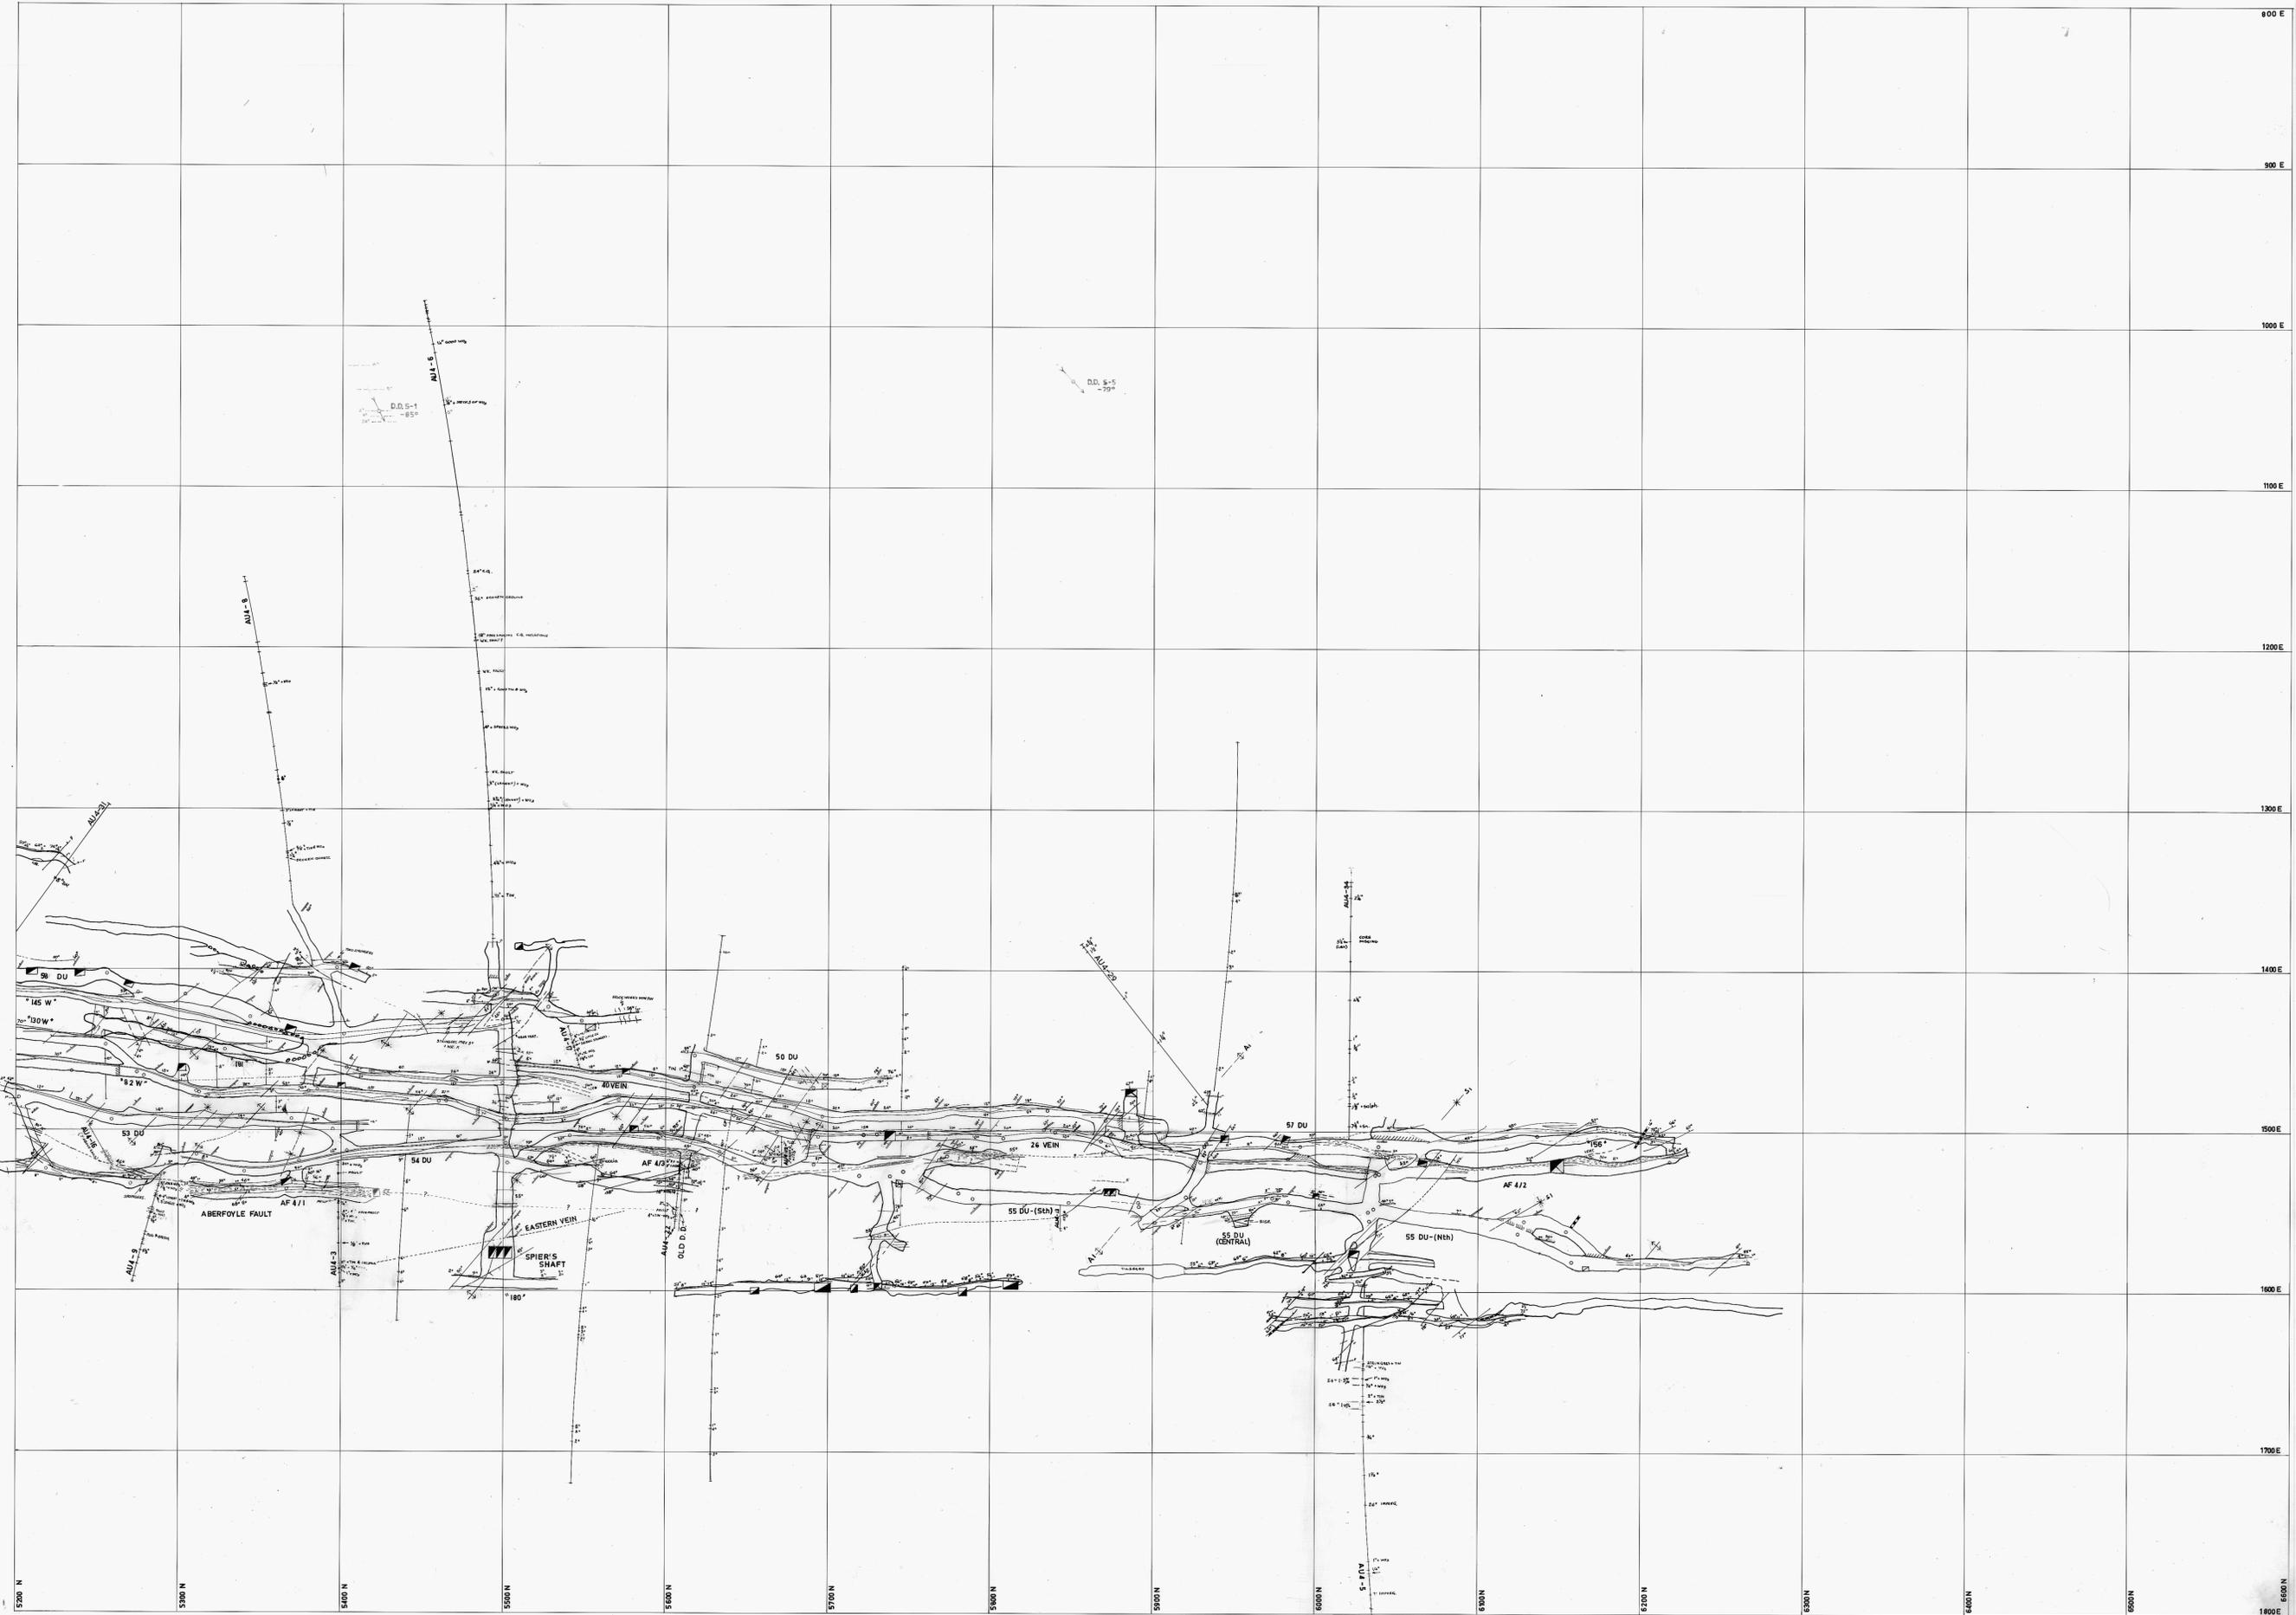

AB-208-G

DARK : BEST AVAILABLE SURVEY.
 FAINT : SUBJECT TO RE-SURVEY.
 GEOLOGY ADAPTED FROM EXISTING MAPPING BY VARIOUS WORKERS AND SUBJECT TO RE-MAPPING IN CRITICAL AREAS

ABERFOYLE TIN N.L.
ABERFOYLE MINE

DRAWN
CHECKED
SCALE 40 FEET TO 1 INCH

4 LEVEL
 R.L. 1816-19