


5 CM

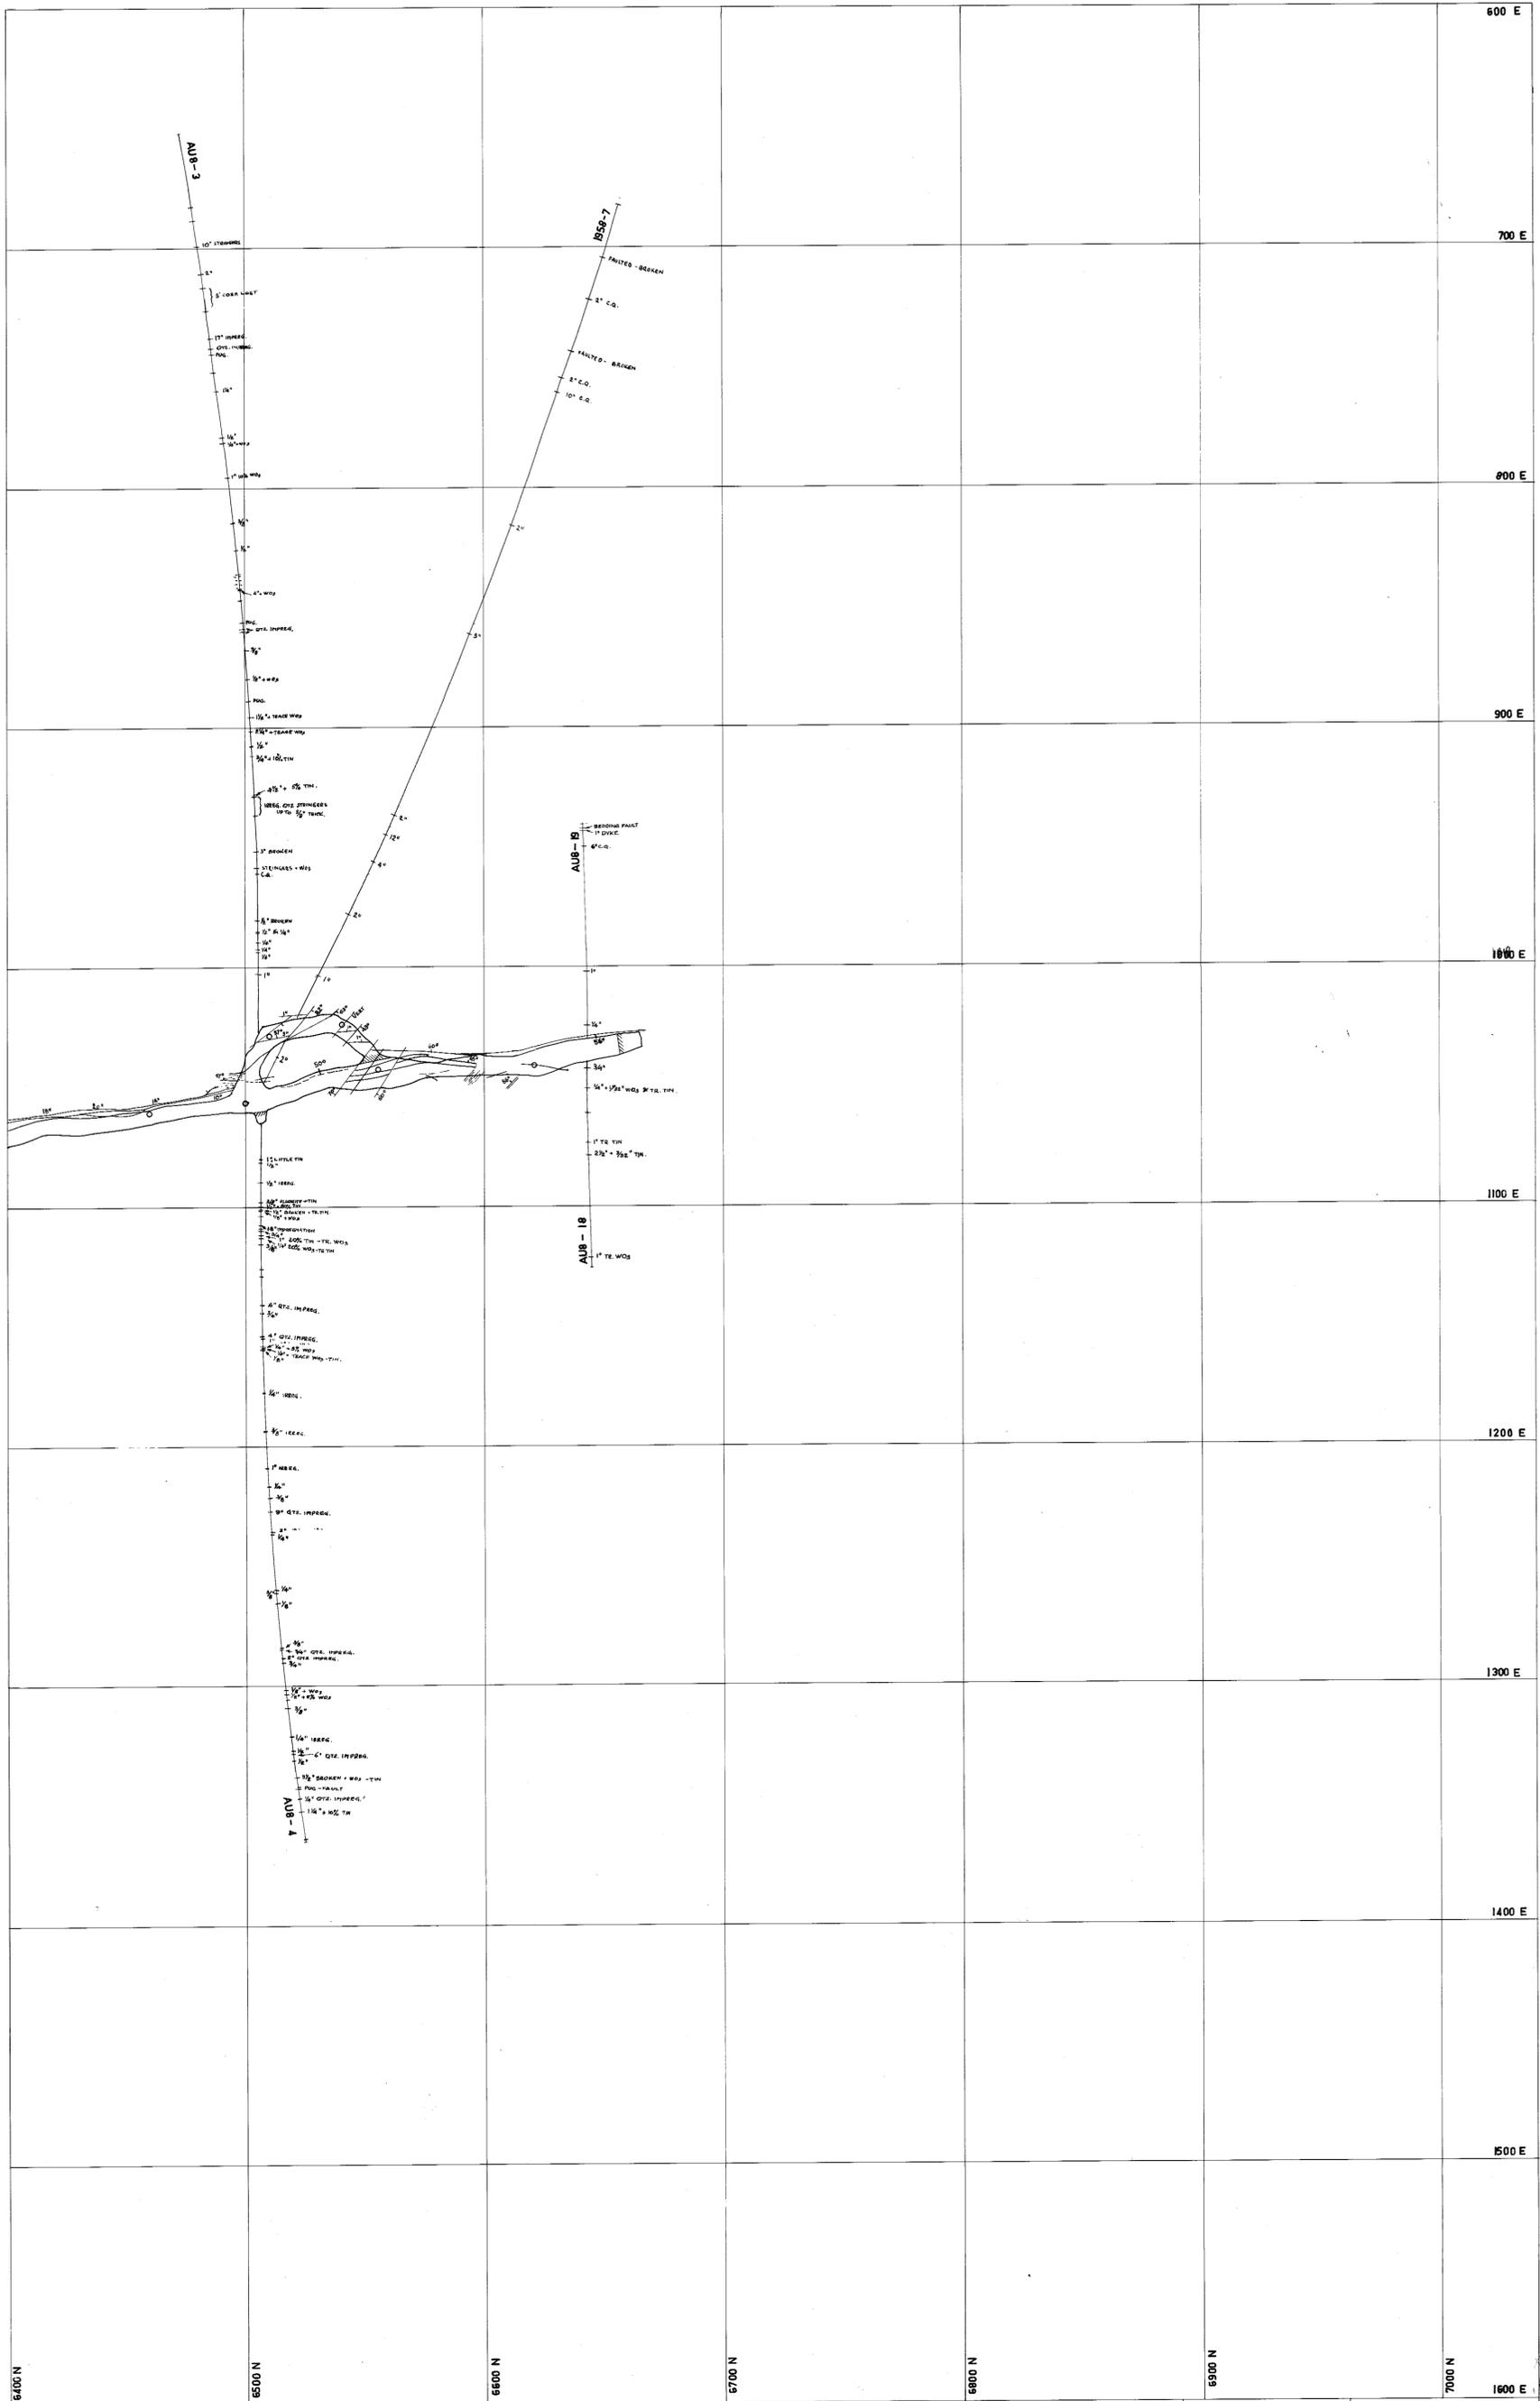

AB-216-G

DARK : BEST AVAILABLE SURVEY
FAINT : SUBJECT TO RE-SURVEY.

AB-216-G

ABERFOYLE TIN NL.
ABERFOYLE MINE

DRAWN
CHECKED
SCALE 40 FEET TO 1 INCH

8 LEVEL
R.L. 1336-97