


50m

AB 220-G

220

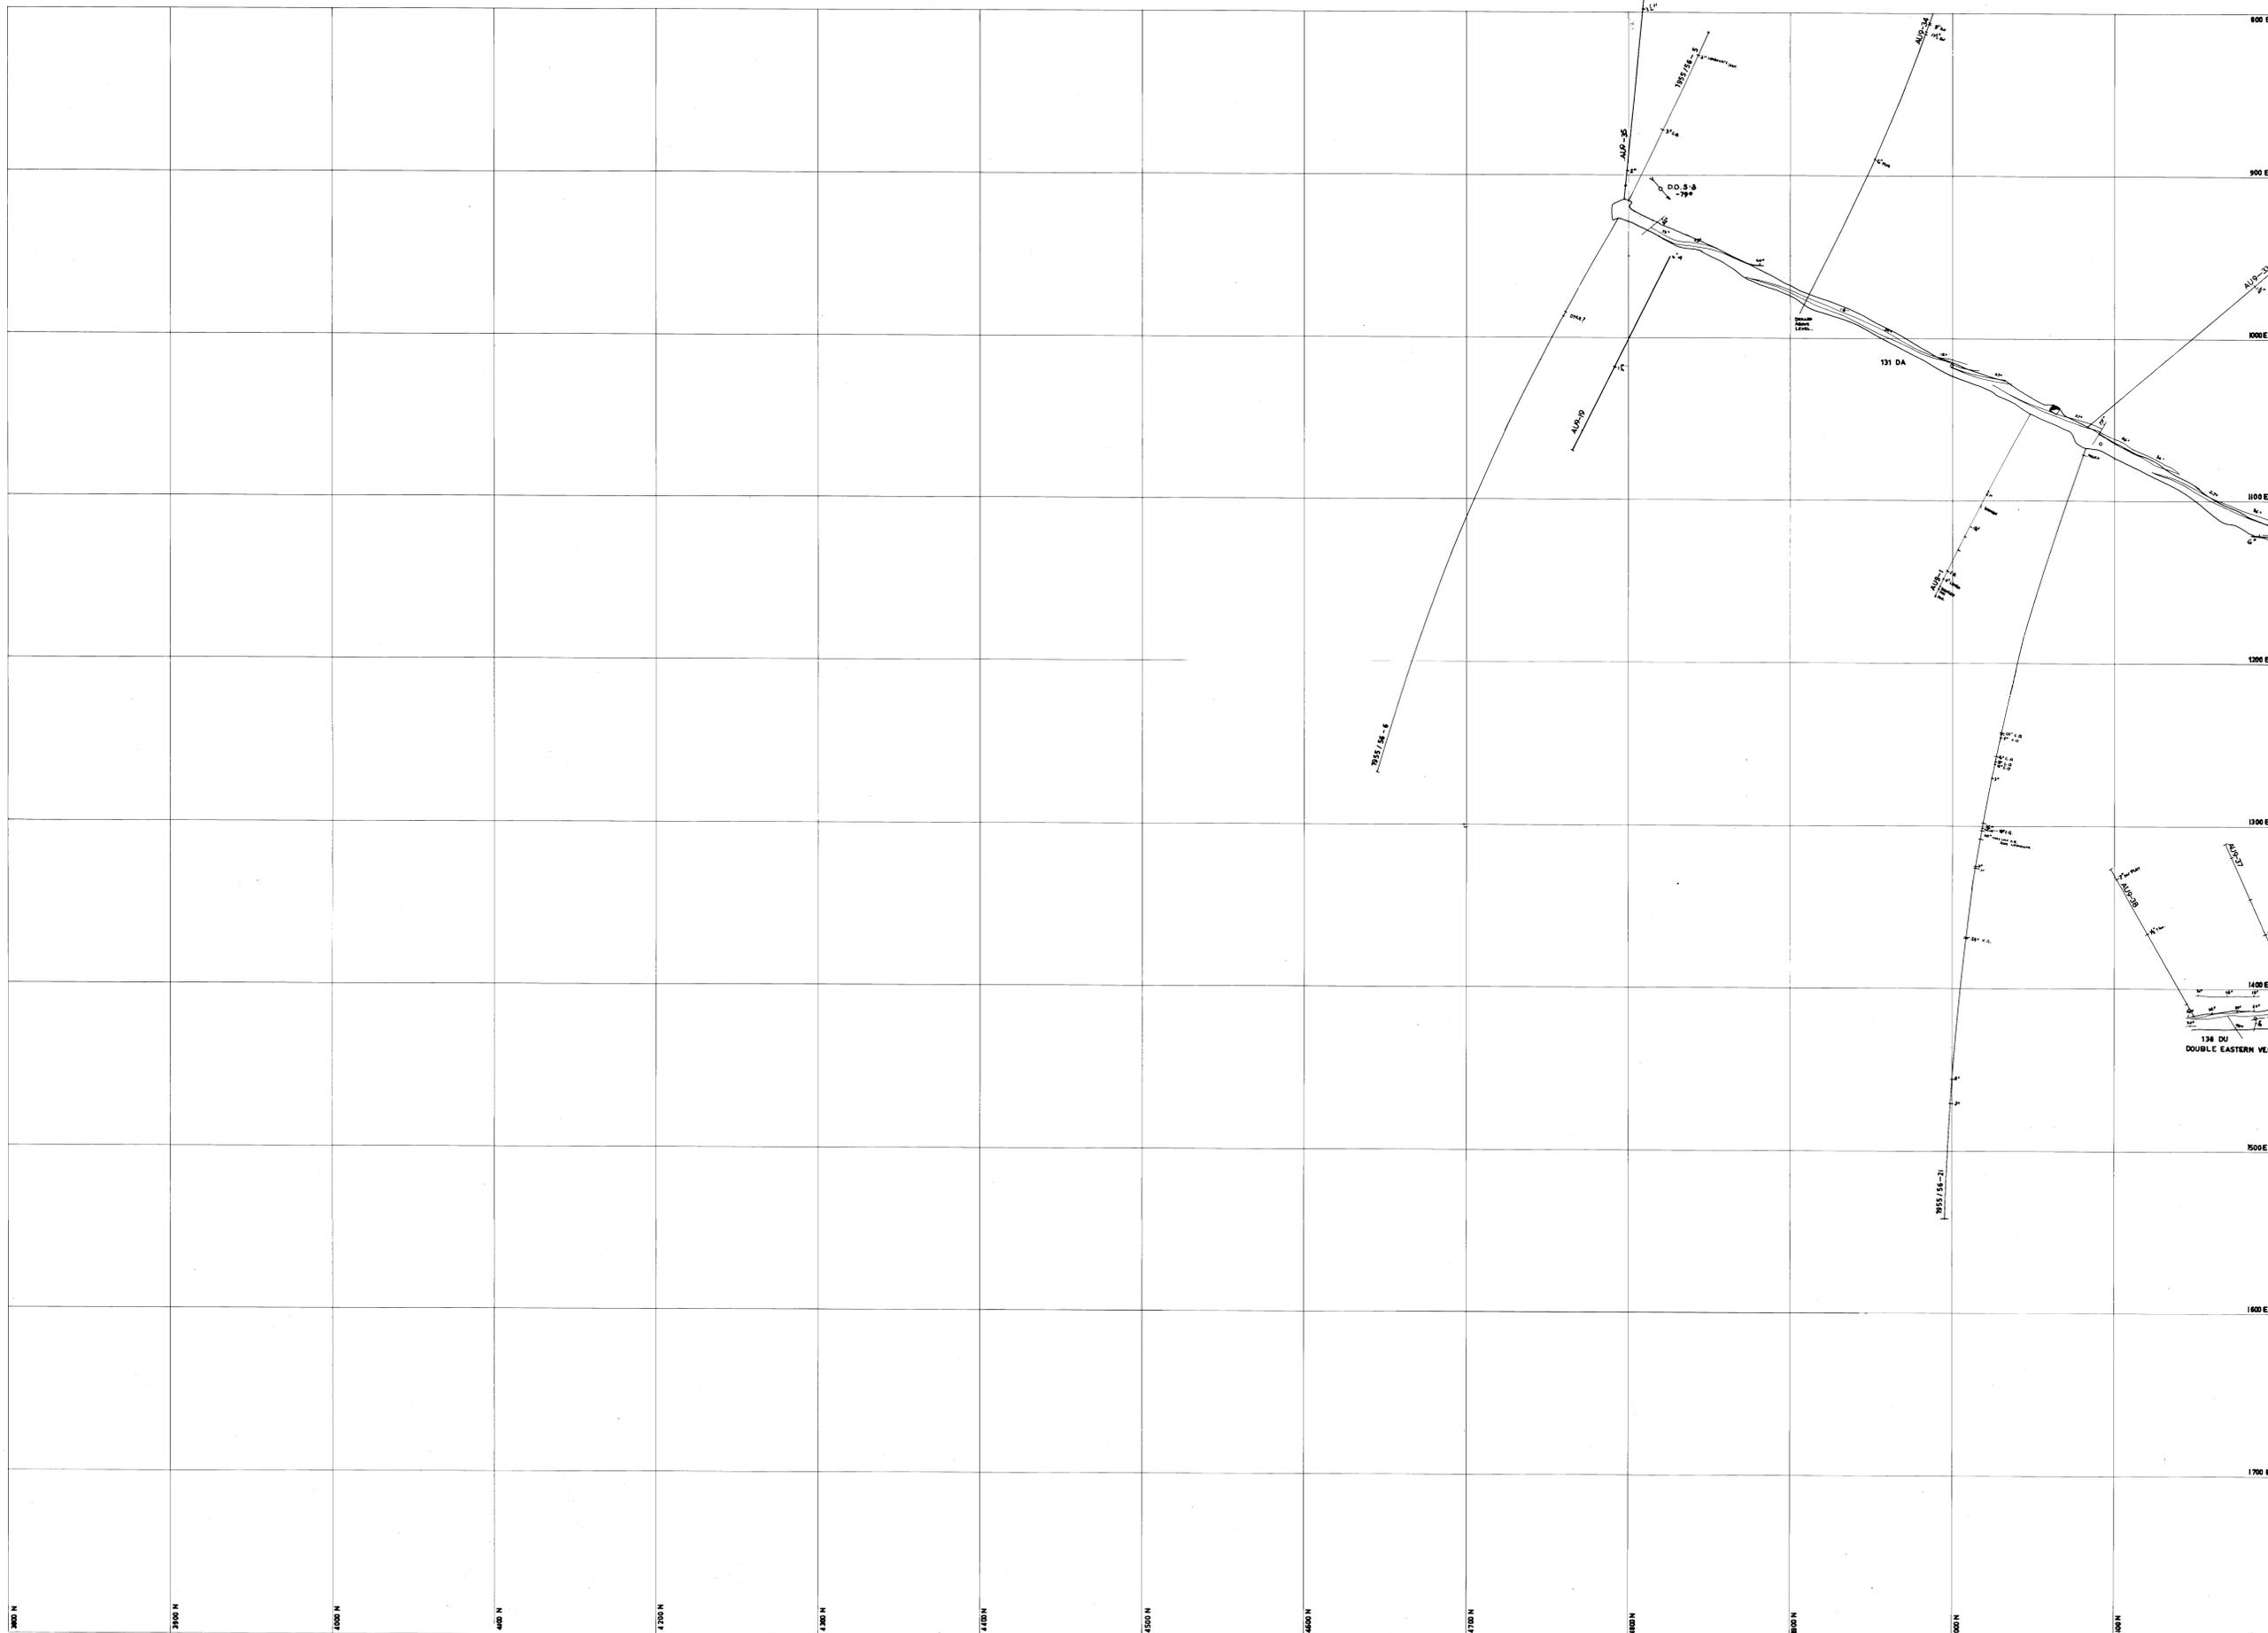

AB-220-G

DARK: BEST AVAILABLE SURVEY.  
 FAINT: SUBJECT TO RE-SURVEY.  
 GEOLOGY ADAPTED FROM EXISTING MAPPING BY VARIOUS WORKERS AND SUBJECT TO RE-MAPPING IN CRITICAL AREAS.

ABERFOYLE TN N.L. <b>ABERFOYLE MINE</b>		<b>9 LEVEL</b> R.L. 1216-85
DRAWN _____ CHECKED _____ SCALE 40 FEET TO 1 INCH		