


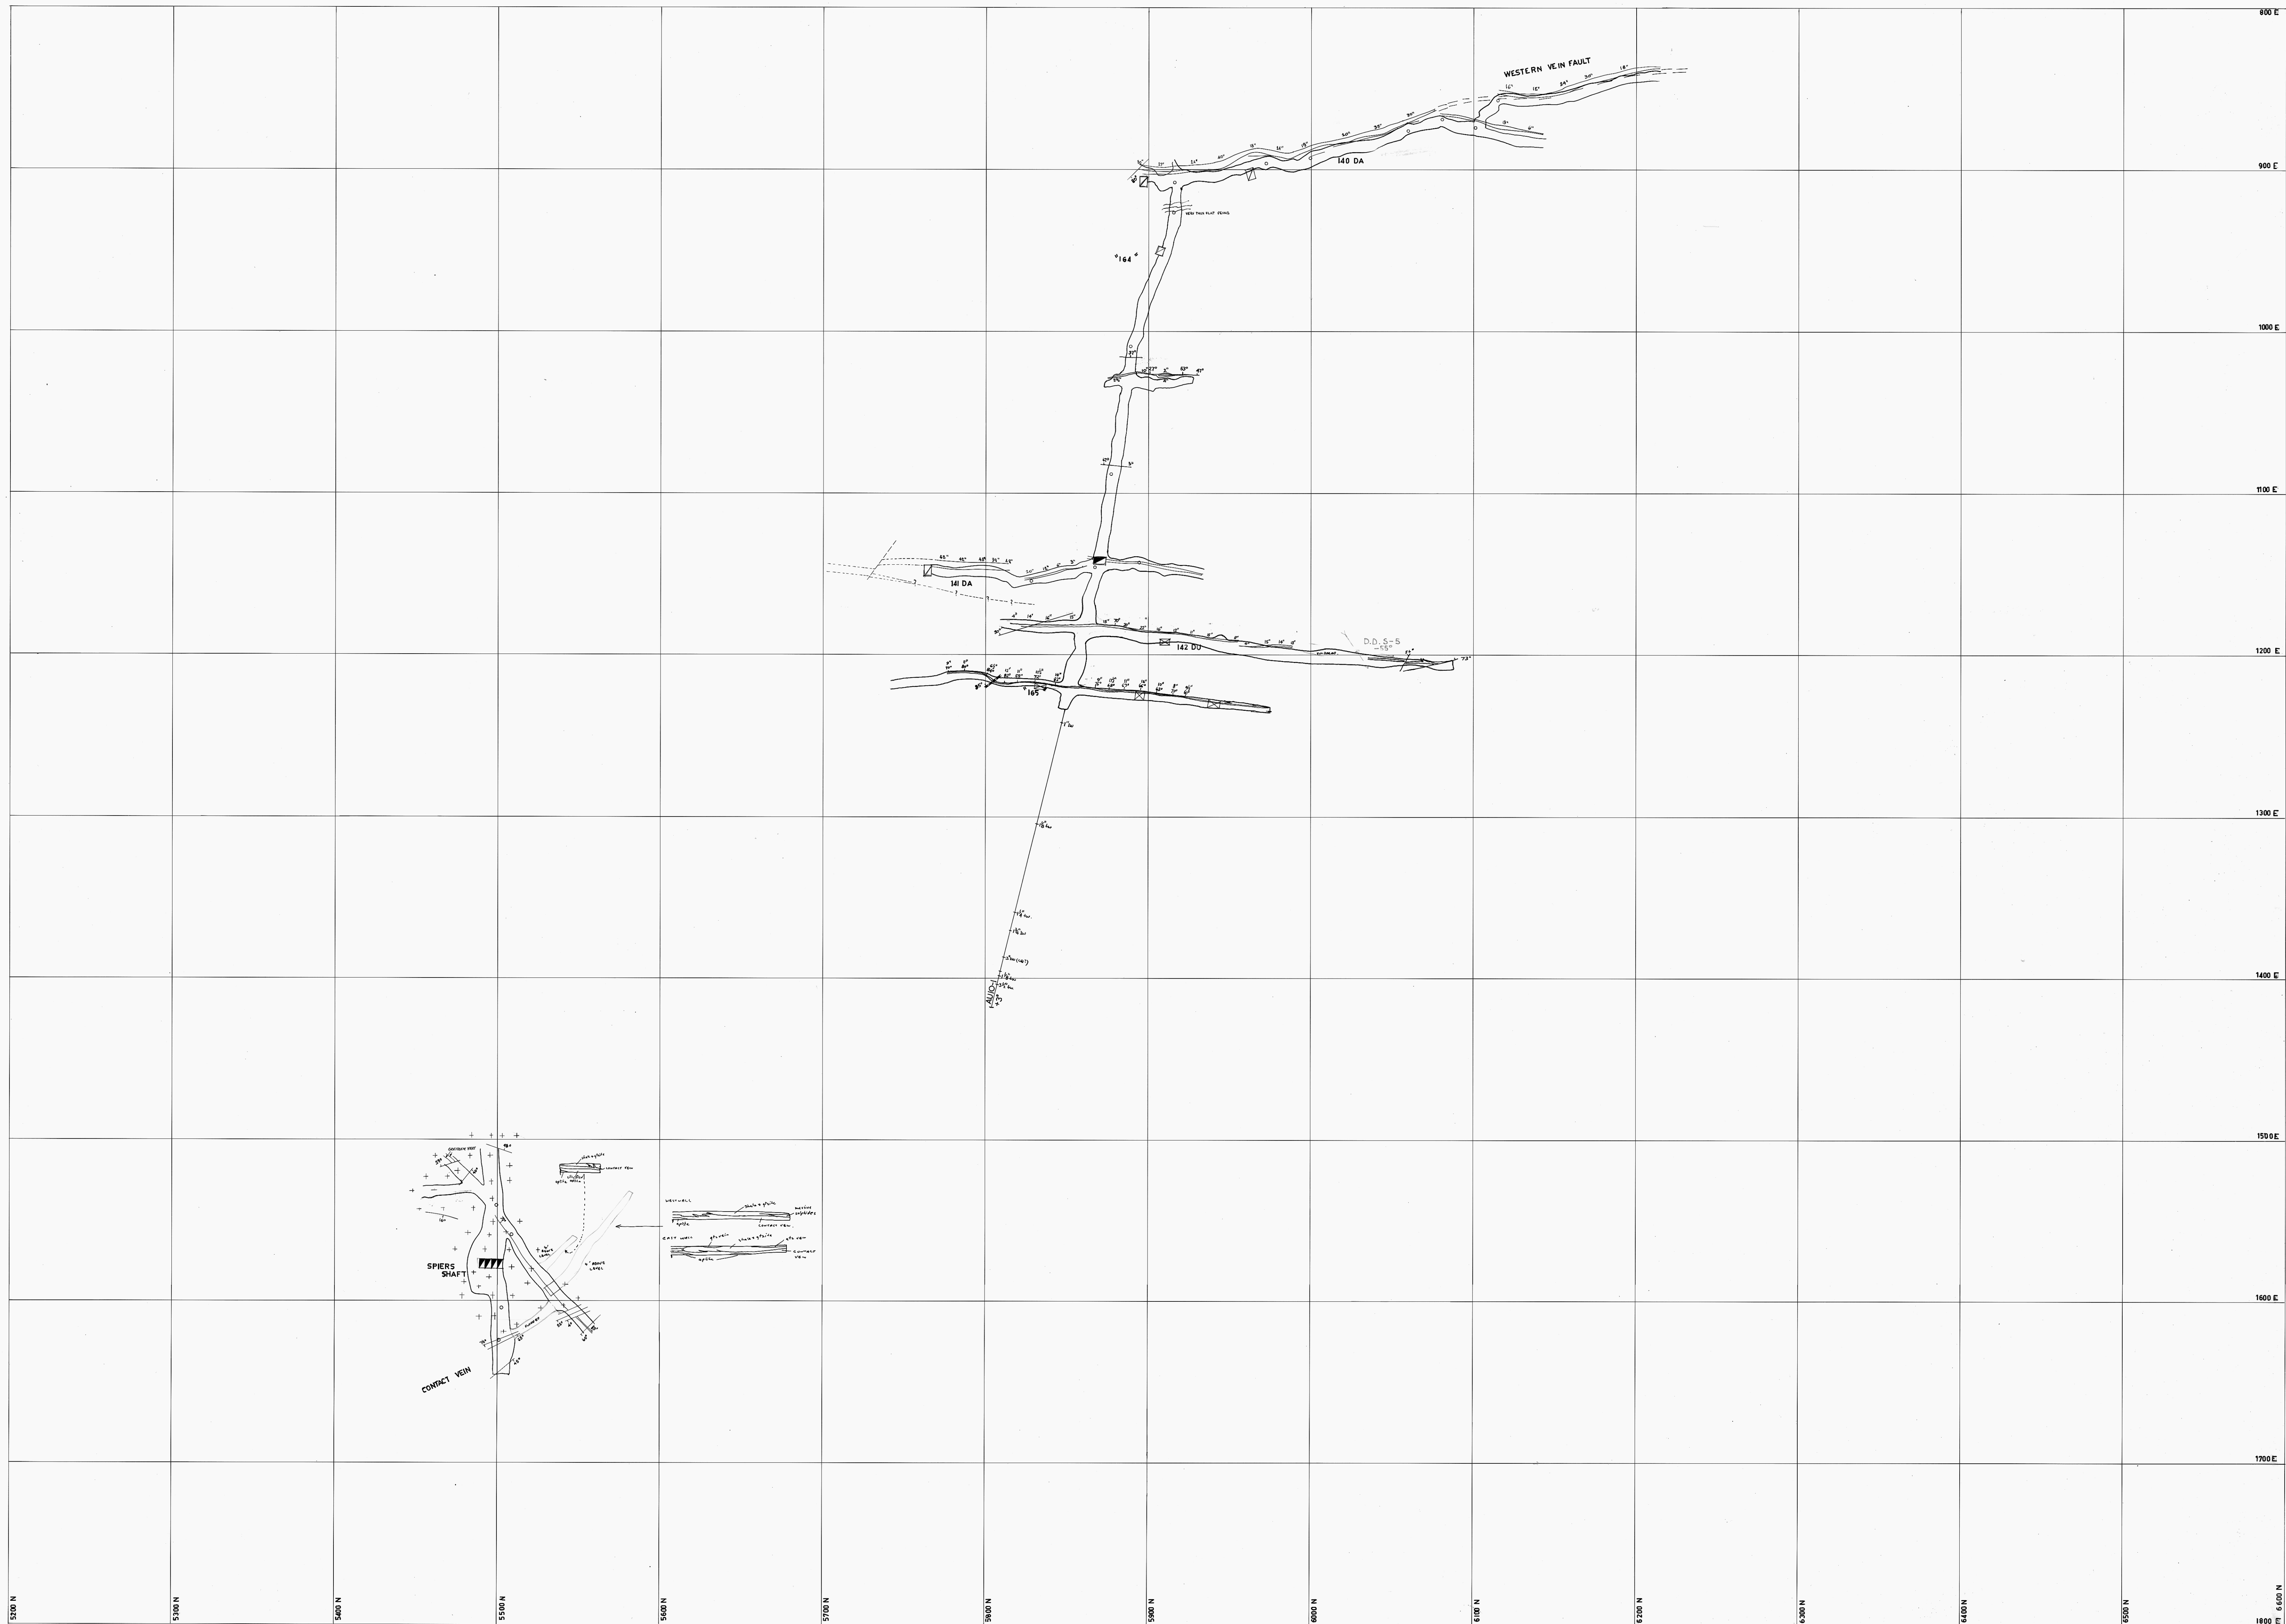

AB-221-G

DARK : BEST AVAILABLE SURVEY.
Faint : SUBJECT TO RE-SURVEY.
GEOLOGY ADAPTED FROM EXISTING MAPPING BY VARIOUS
WORKERS AND SUBJECT TO RE-MAPPING IN CRITICAL AREAS.

ABERFOYLE TIN N.L.
ABERFOYLE MINE

DRAWN
CHECKED
SCALE
40 FEET TO 1 INCH

10 LEVEL
R.L. 1143.33