


5m

800 E
900 E
1000 E
1100 E
1200 E
1300 E
1400 E
1500 E
1600 E
1700 E
1800 E

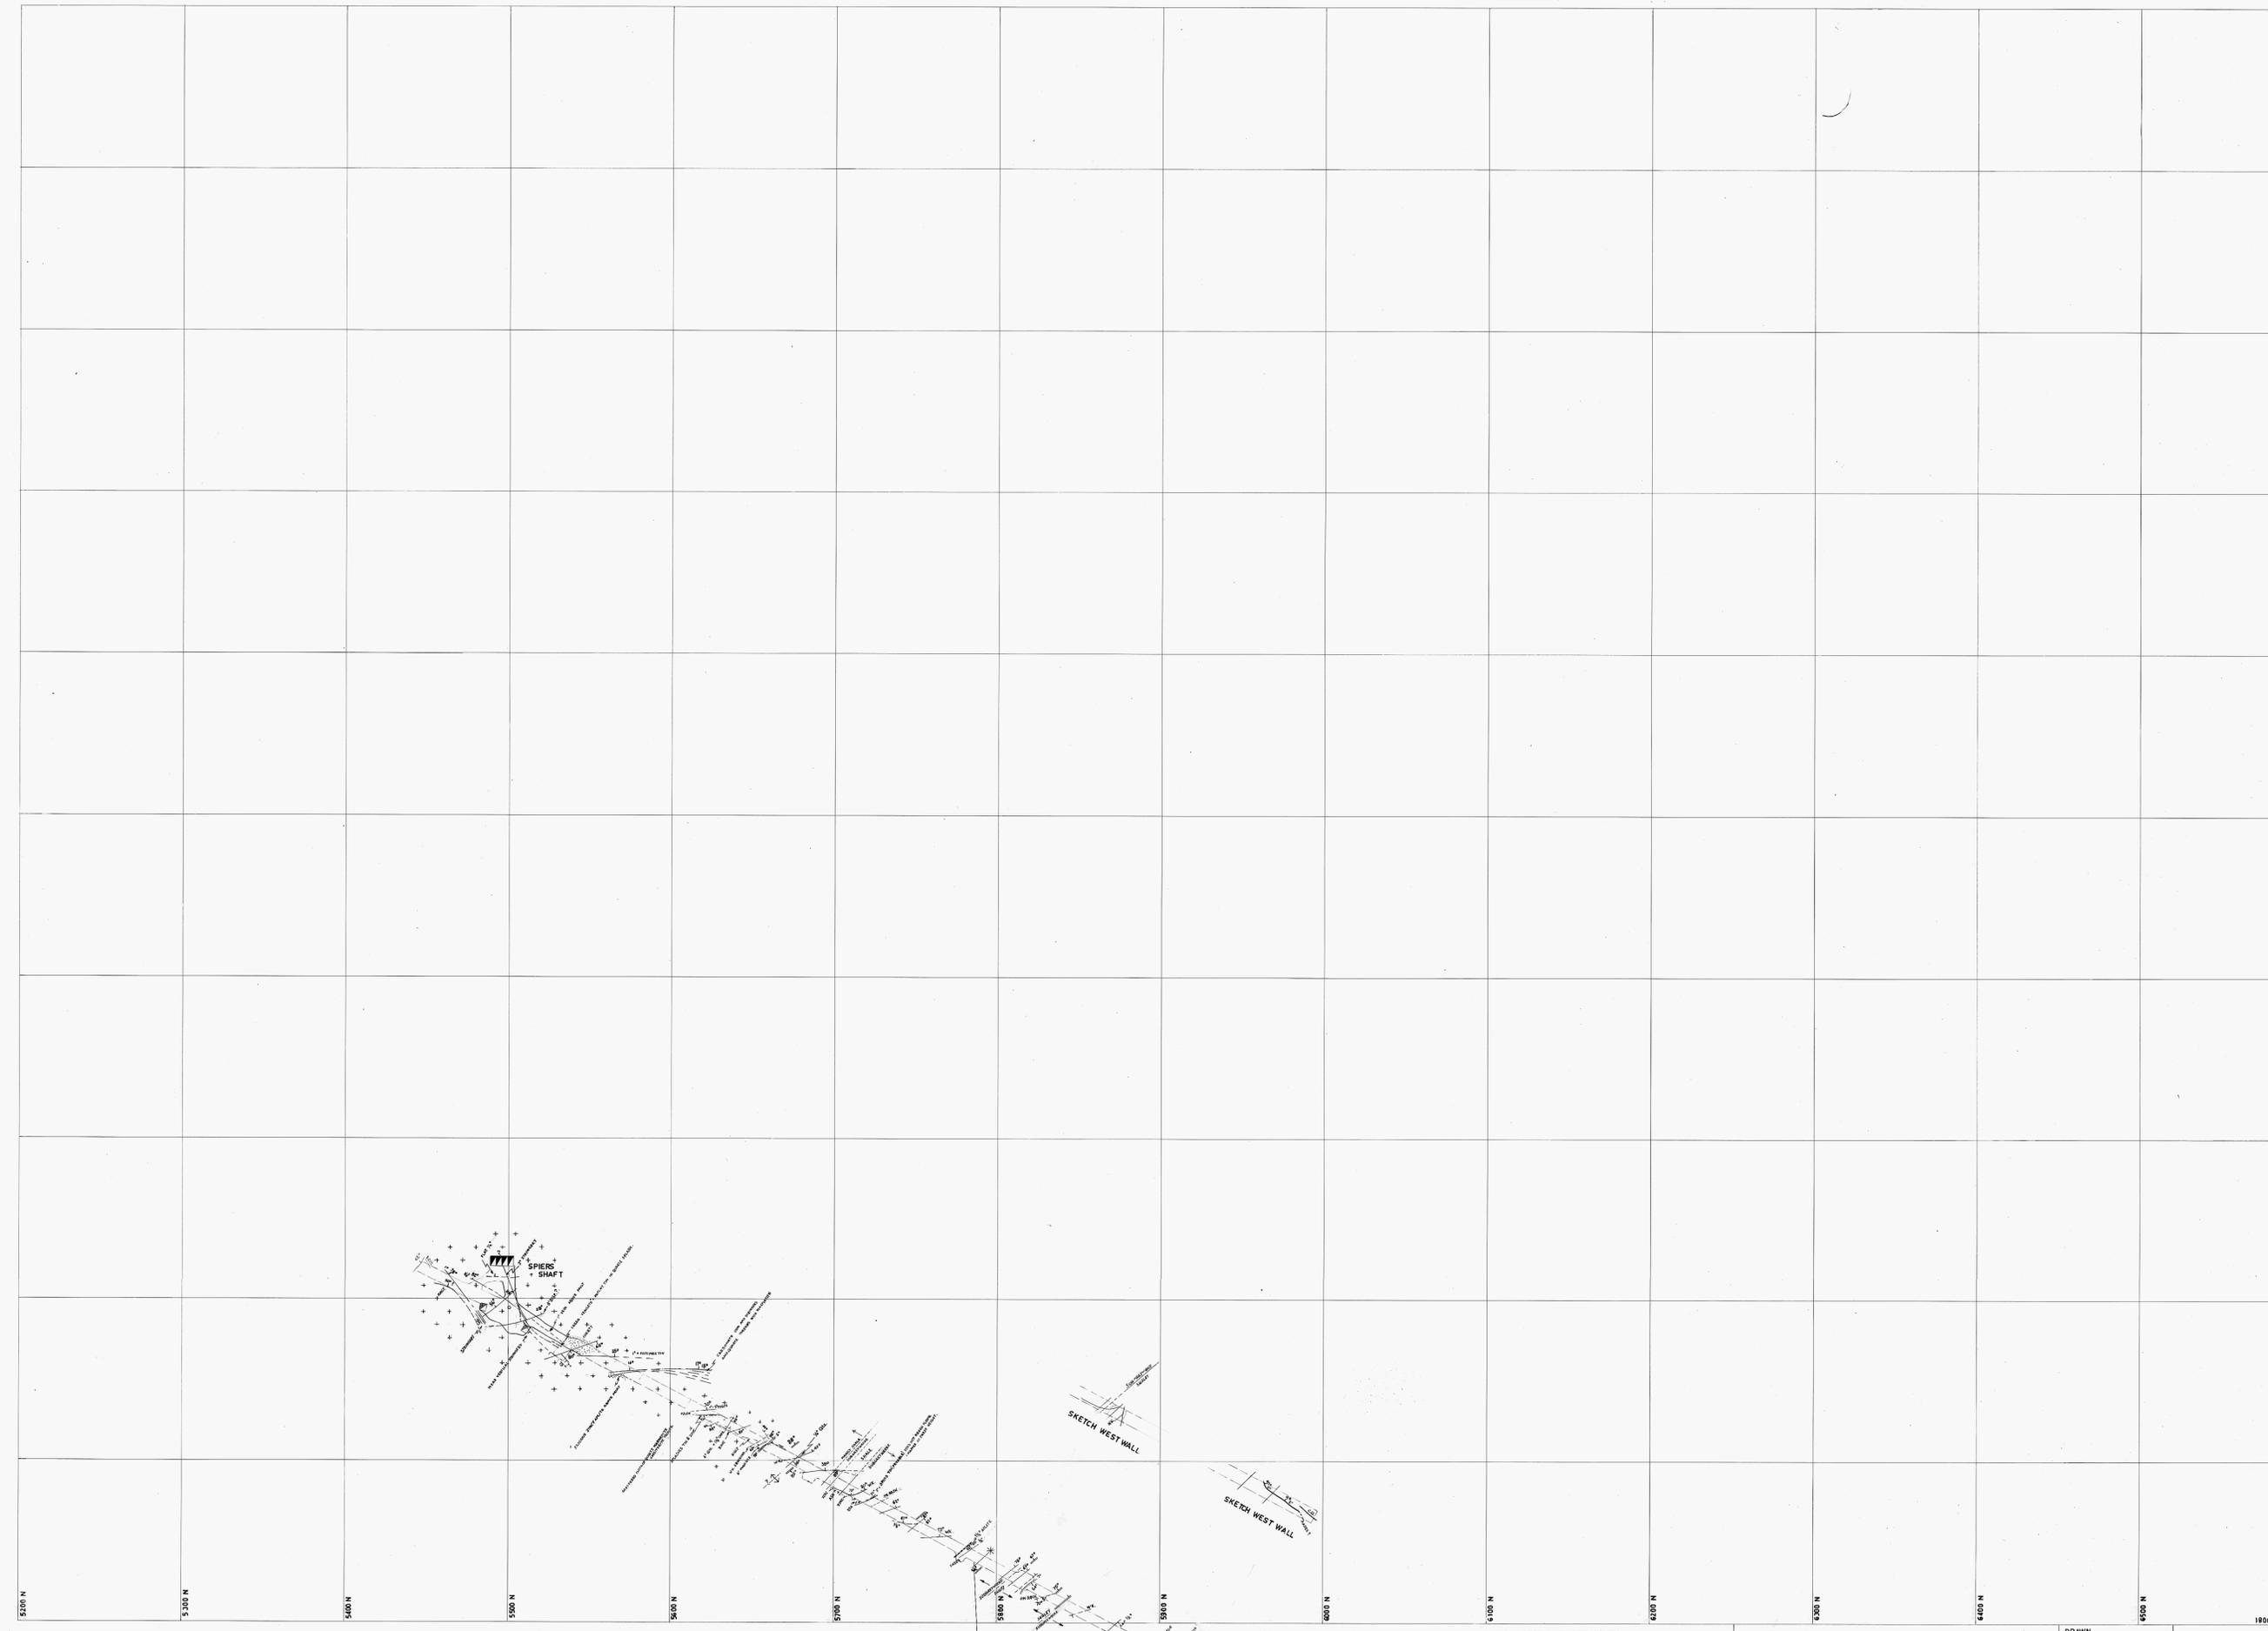

DARK : BEST AVAILABLE SURVEY
FAINT : SUBJECT TO RE-SURVEY.

ABERFOYLE TIN N.L.
ABERFOYLE MINE
 AB 2

DRAWN
CHECKED
SCALE
40 FEET TO 1 INCH

13 LEVEL