


319

5 cm

ABERF-319D

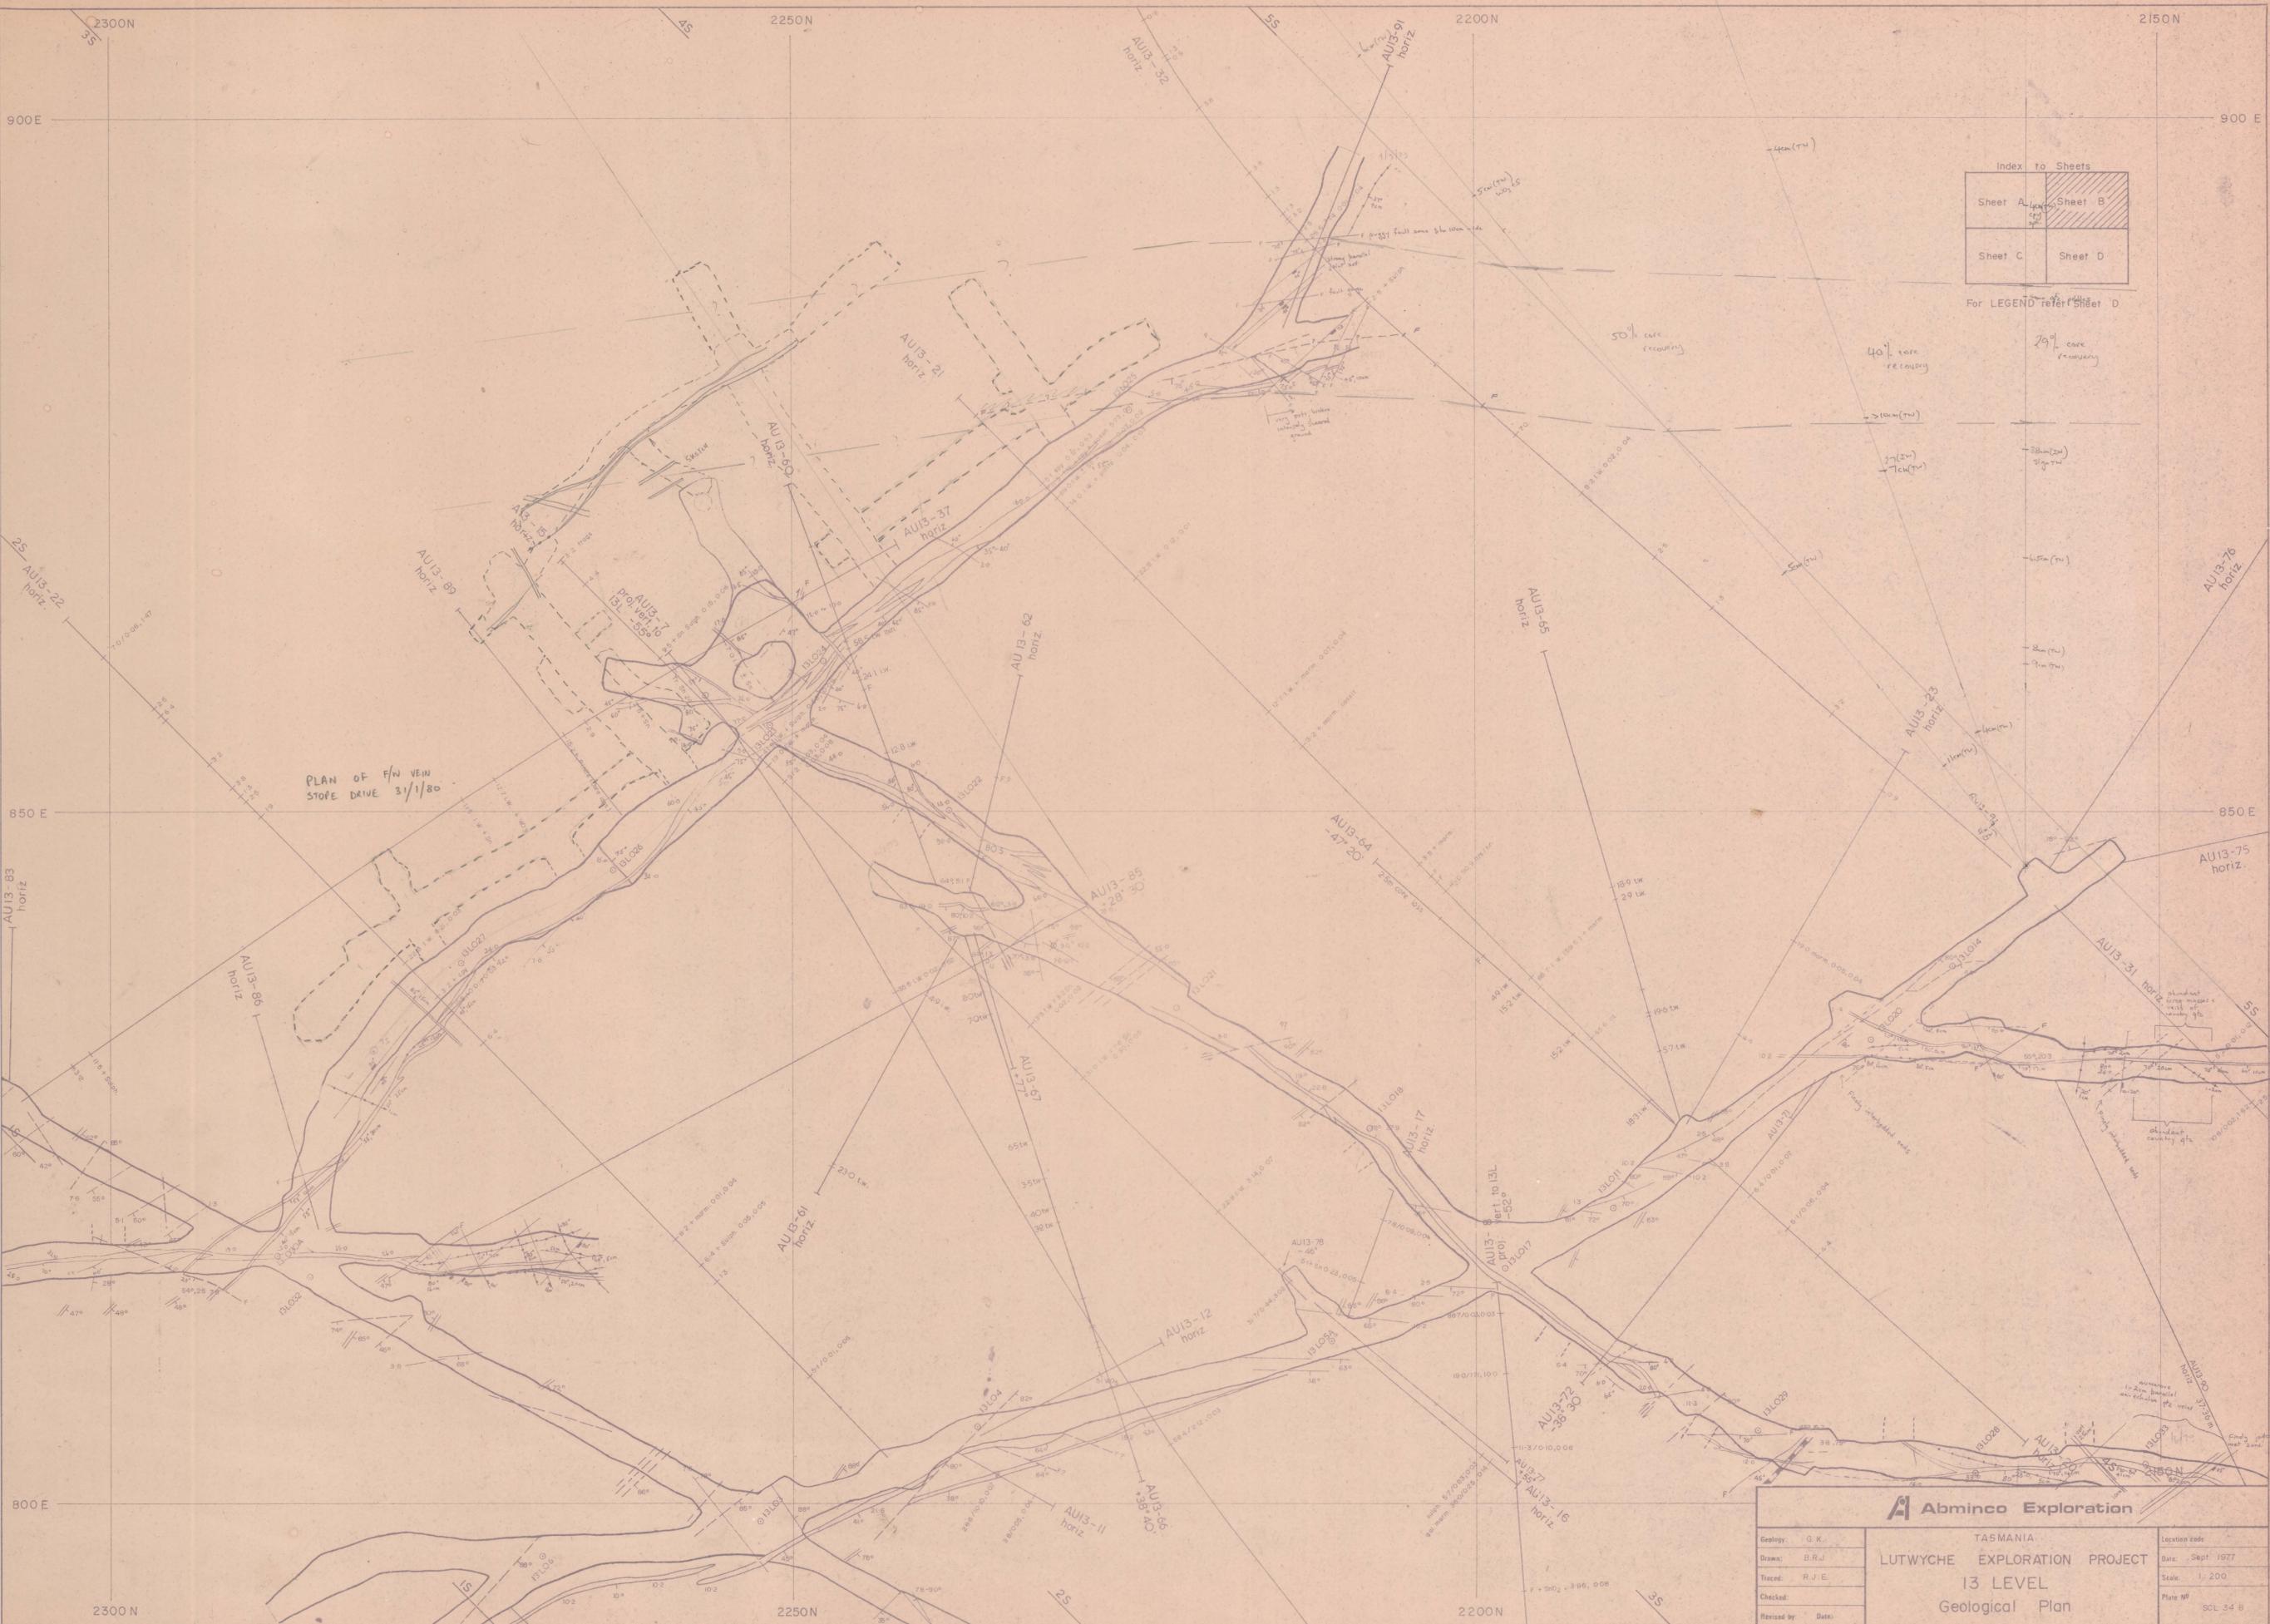

Index to Sheets	
Sheet A	Sheet B
Sheet C	Sheet D

For LEGEND refer Sheet D

Abminco Exploration

TASMANIA
LUTWICHE EXPLORATION PROJECT
13 LEVEL
Geological Plan

Geology: G.K.	Location code:
Drawn: B.R.J.	Date: Sept. 1977
Traced: R.J.E.	Scale: 1:200
Checked:	Plate No:
Revised by: Date:	SCL 34 B