

SW.

NE.

REFERENCE LINE

ABERVOLE FAULT

ABERVOLE RIVULET



2000

1500

1000

500

13 LEVEL

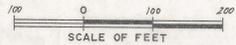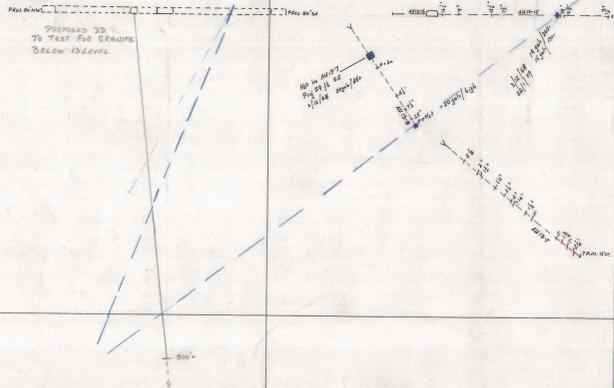

LUTWICHE - EXPLORATION PROJECT
 SECTION 4 S. - HYDRO GEOLOGY

SURVEY	-	-	-	-
GEOLOGY	-	G.K. DKT	-	11/69
ENGINEERING	-	-	-	-
DRAWN	-	-	-	-
TRACED	-	-	-	-
REFERENCE	-	-	-	-
PRINT No.	-	-	-	-
DRAWING No. - LU-72-G				

DRAWER:



ABERF_374

374