


PLAN

S34


TRUE SECTION

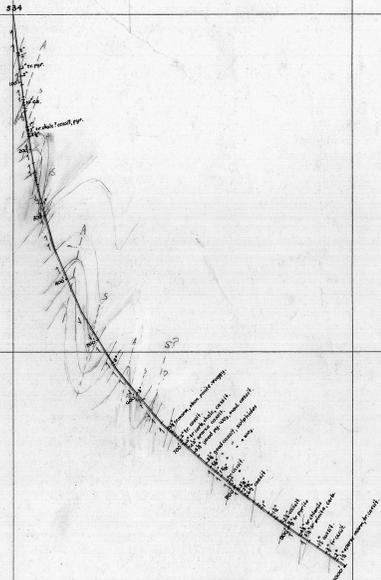

PLAN

S35



TRUE SECTION

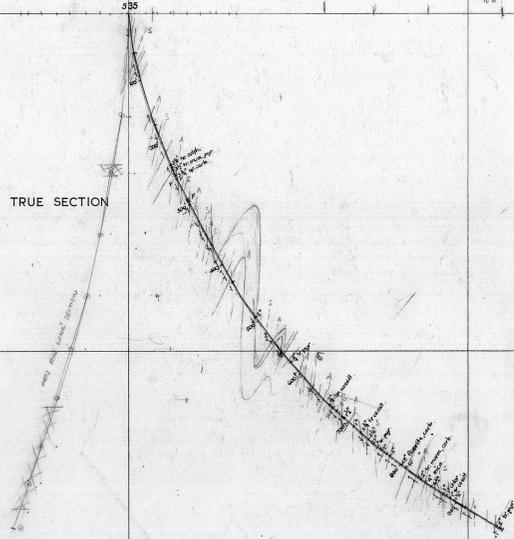

PLAN

S36

TRUE SECTION

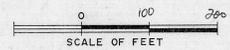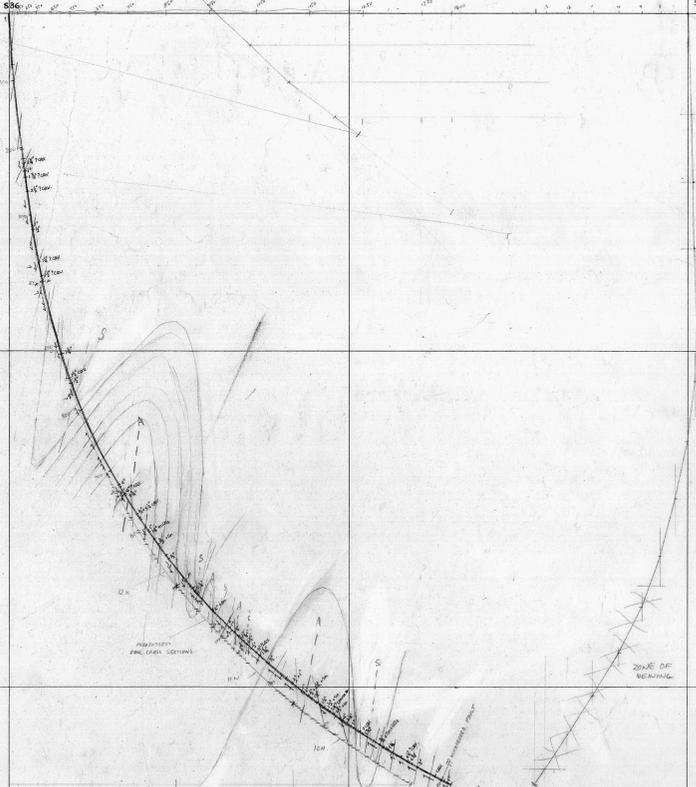

L. E. P.
 SURFACE DRILL HOLES.
 S34 . S35 . S36
 FACT SECTIONS

SURVEY - - - / /
 GEOLOGY - - - / /
 ENGINEERING - - - / /
 DRAWN - - - / /
 TRACED - - - / /
 REFERENCE - - - / /
 PRINT No. - - - / /
 DRAWING No. - LU-11-6

DRAWER: