


ABERF_461

LU.65.4

461

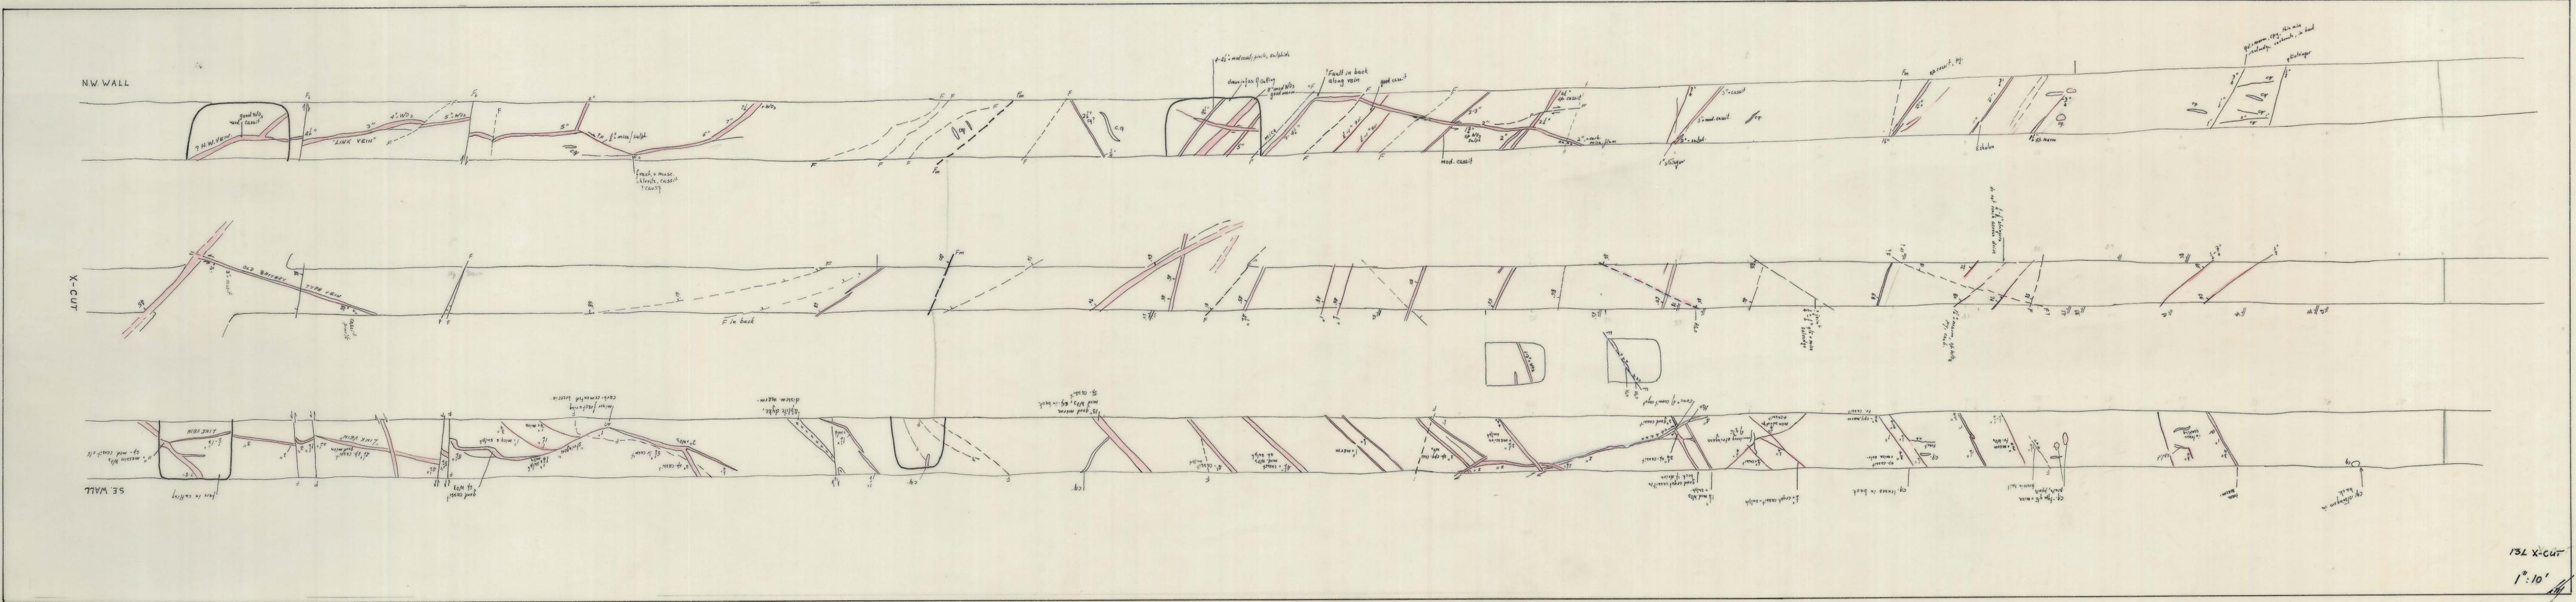

13L X-CUT
1" = 10'

LU 656