
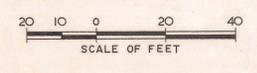


36

ABERF 467

467

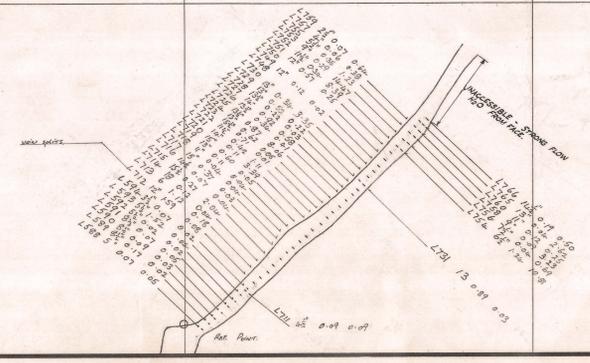

ABERFOYLE LTD.
 LUTWYCHE EXPLORATION PROJECT
 13 LEVEL RISE
 ASSAY PLAN
 SECTION 15

SURVEY - Survey Dept. - / / 69
 GEOLOGY - G.K. - / / 69
 ENGINEERING - / / /
 DRAWN - B.R.J. - / / 69
 TRACED - / / /
 REFERENCE -
 PRINT No. -
 DRAWING No. - LU-69-G
 DRAWER: