


478

ABERF_478

5 cm

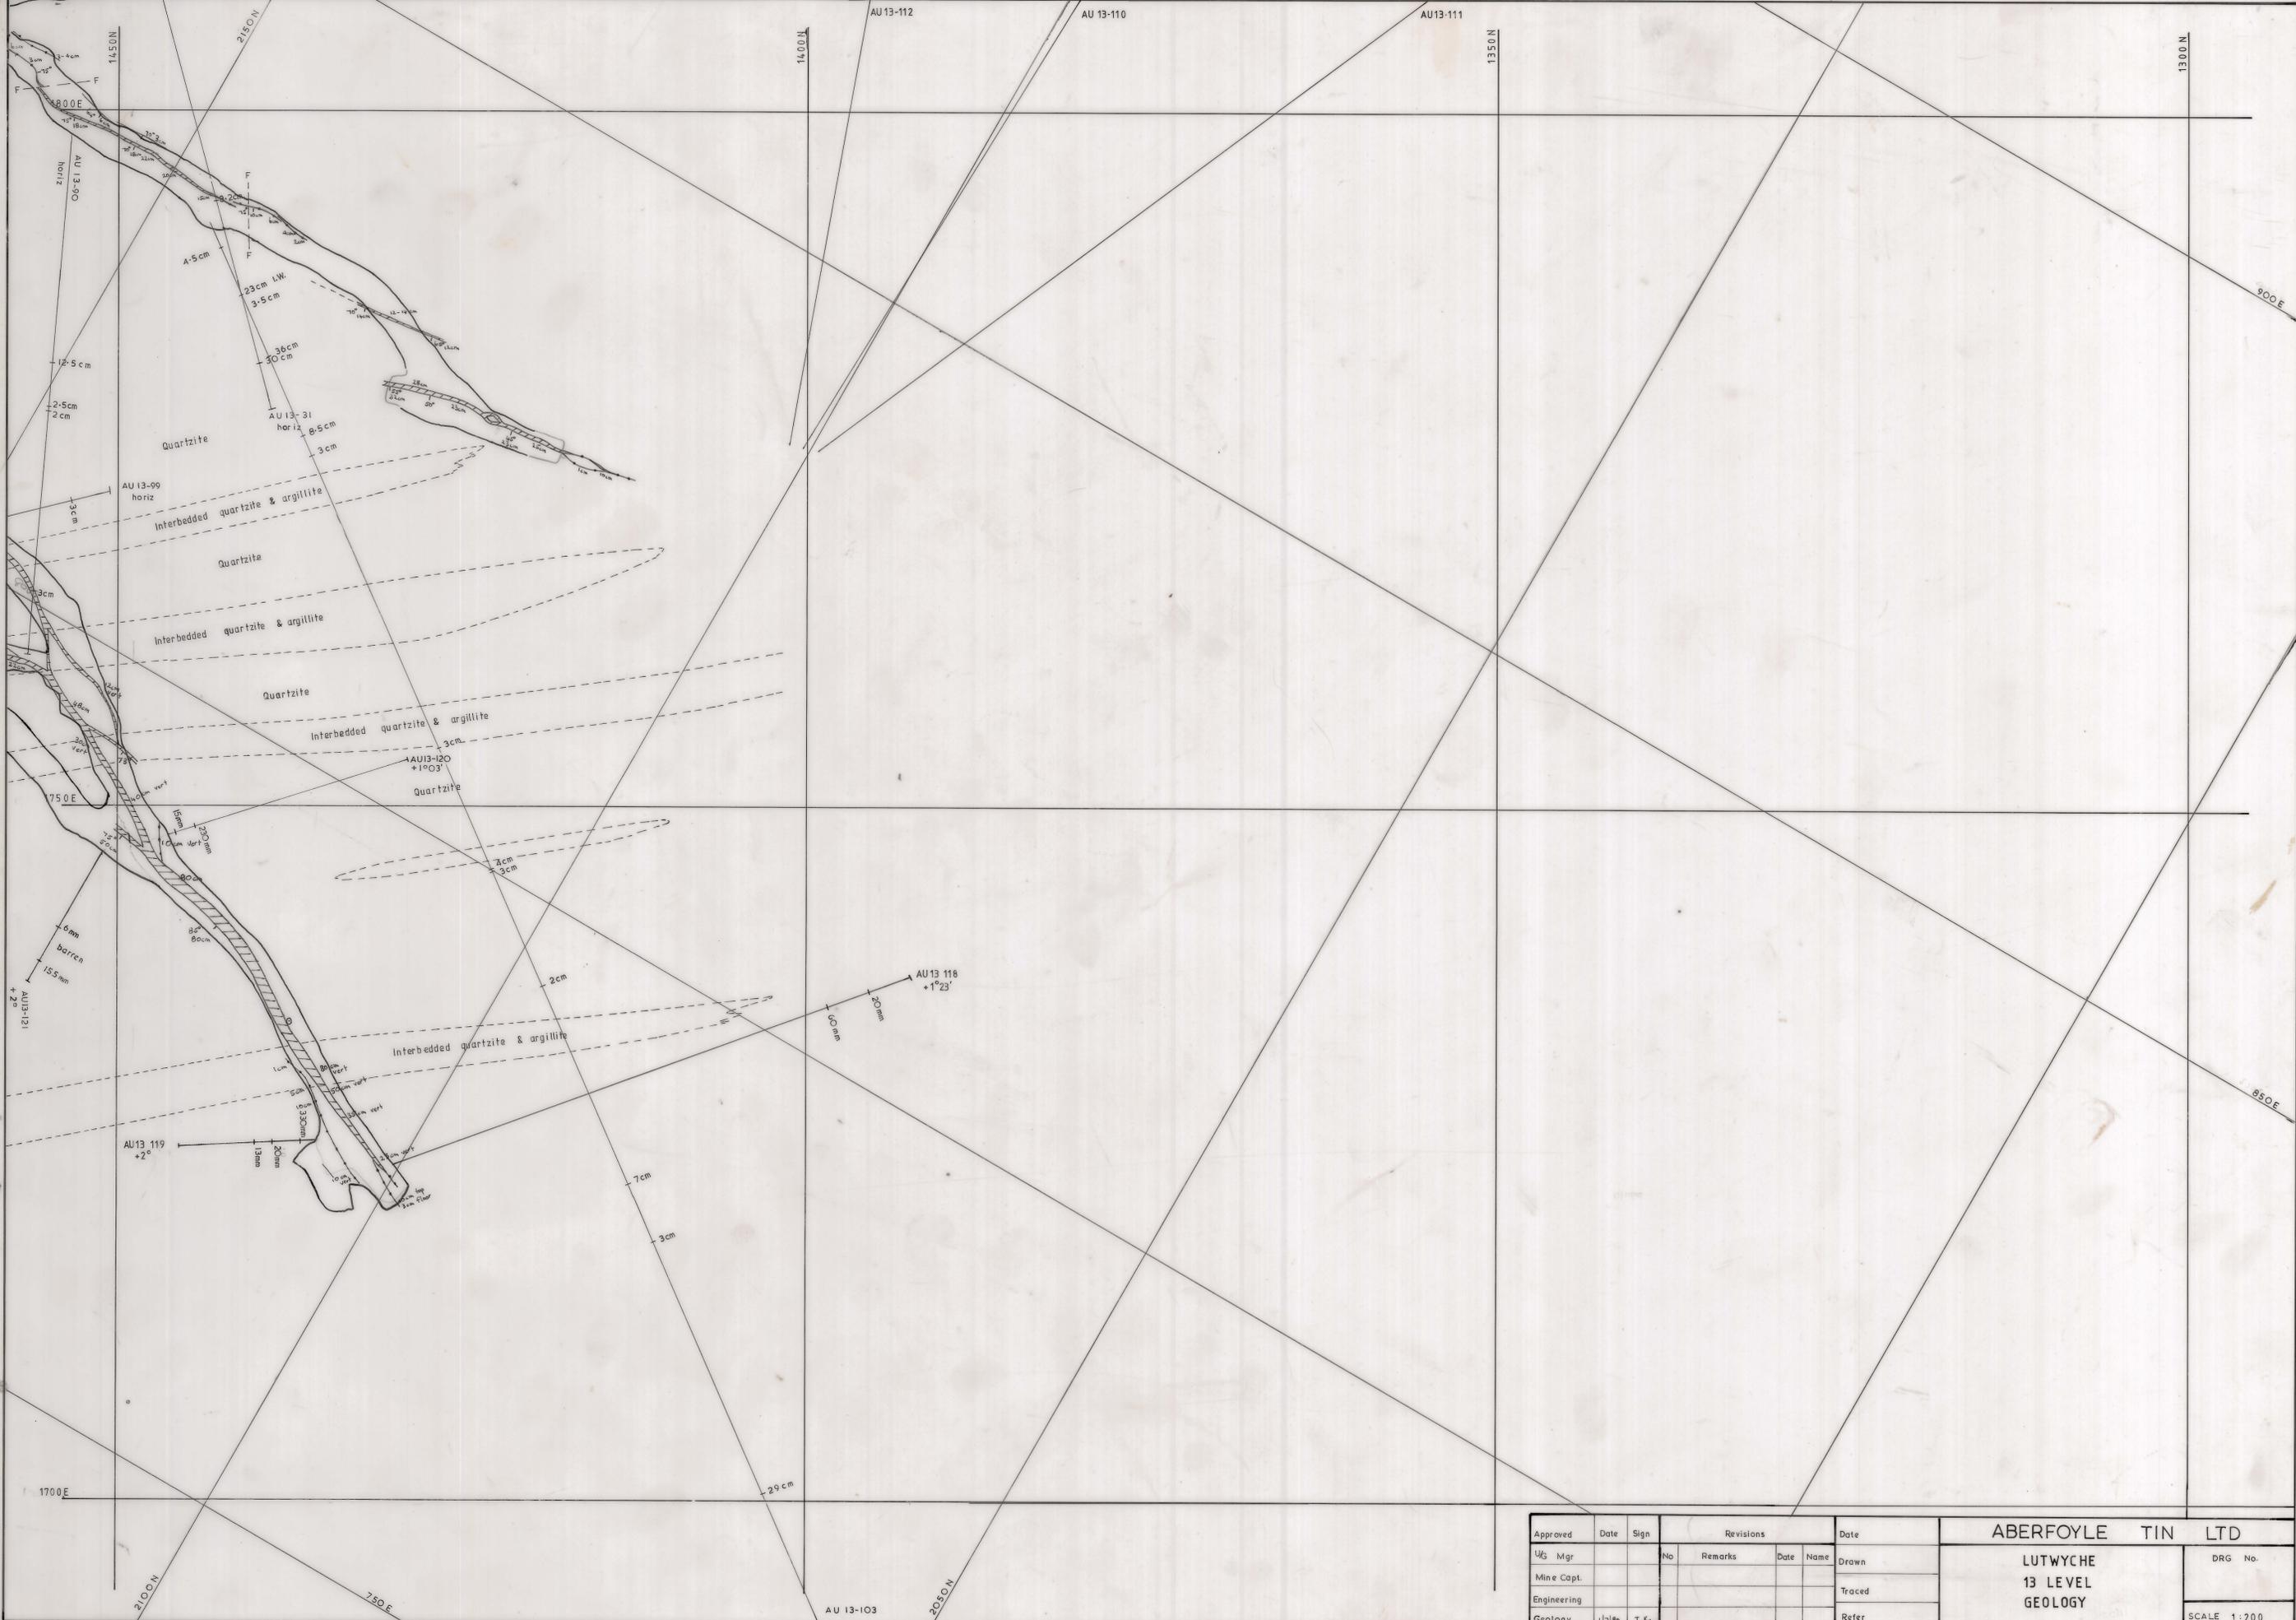

Approved	Date	Sign	Revisions			Date
UG Mgr			No	Remarks	Date	Name
Mine Capt.						
Engineering						
Geology	1/7/86	T.C.				

ABERFOYLE TIN LTD

LUTWYCHE
13 LEVEL
GEOLOGY

DRG No. _____

SCALE 1:200