
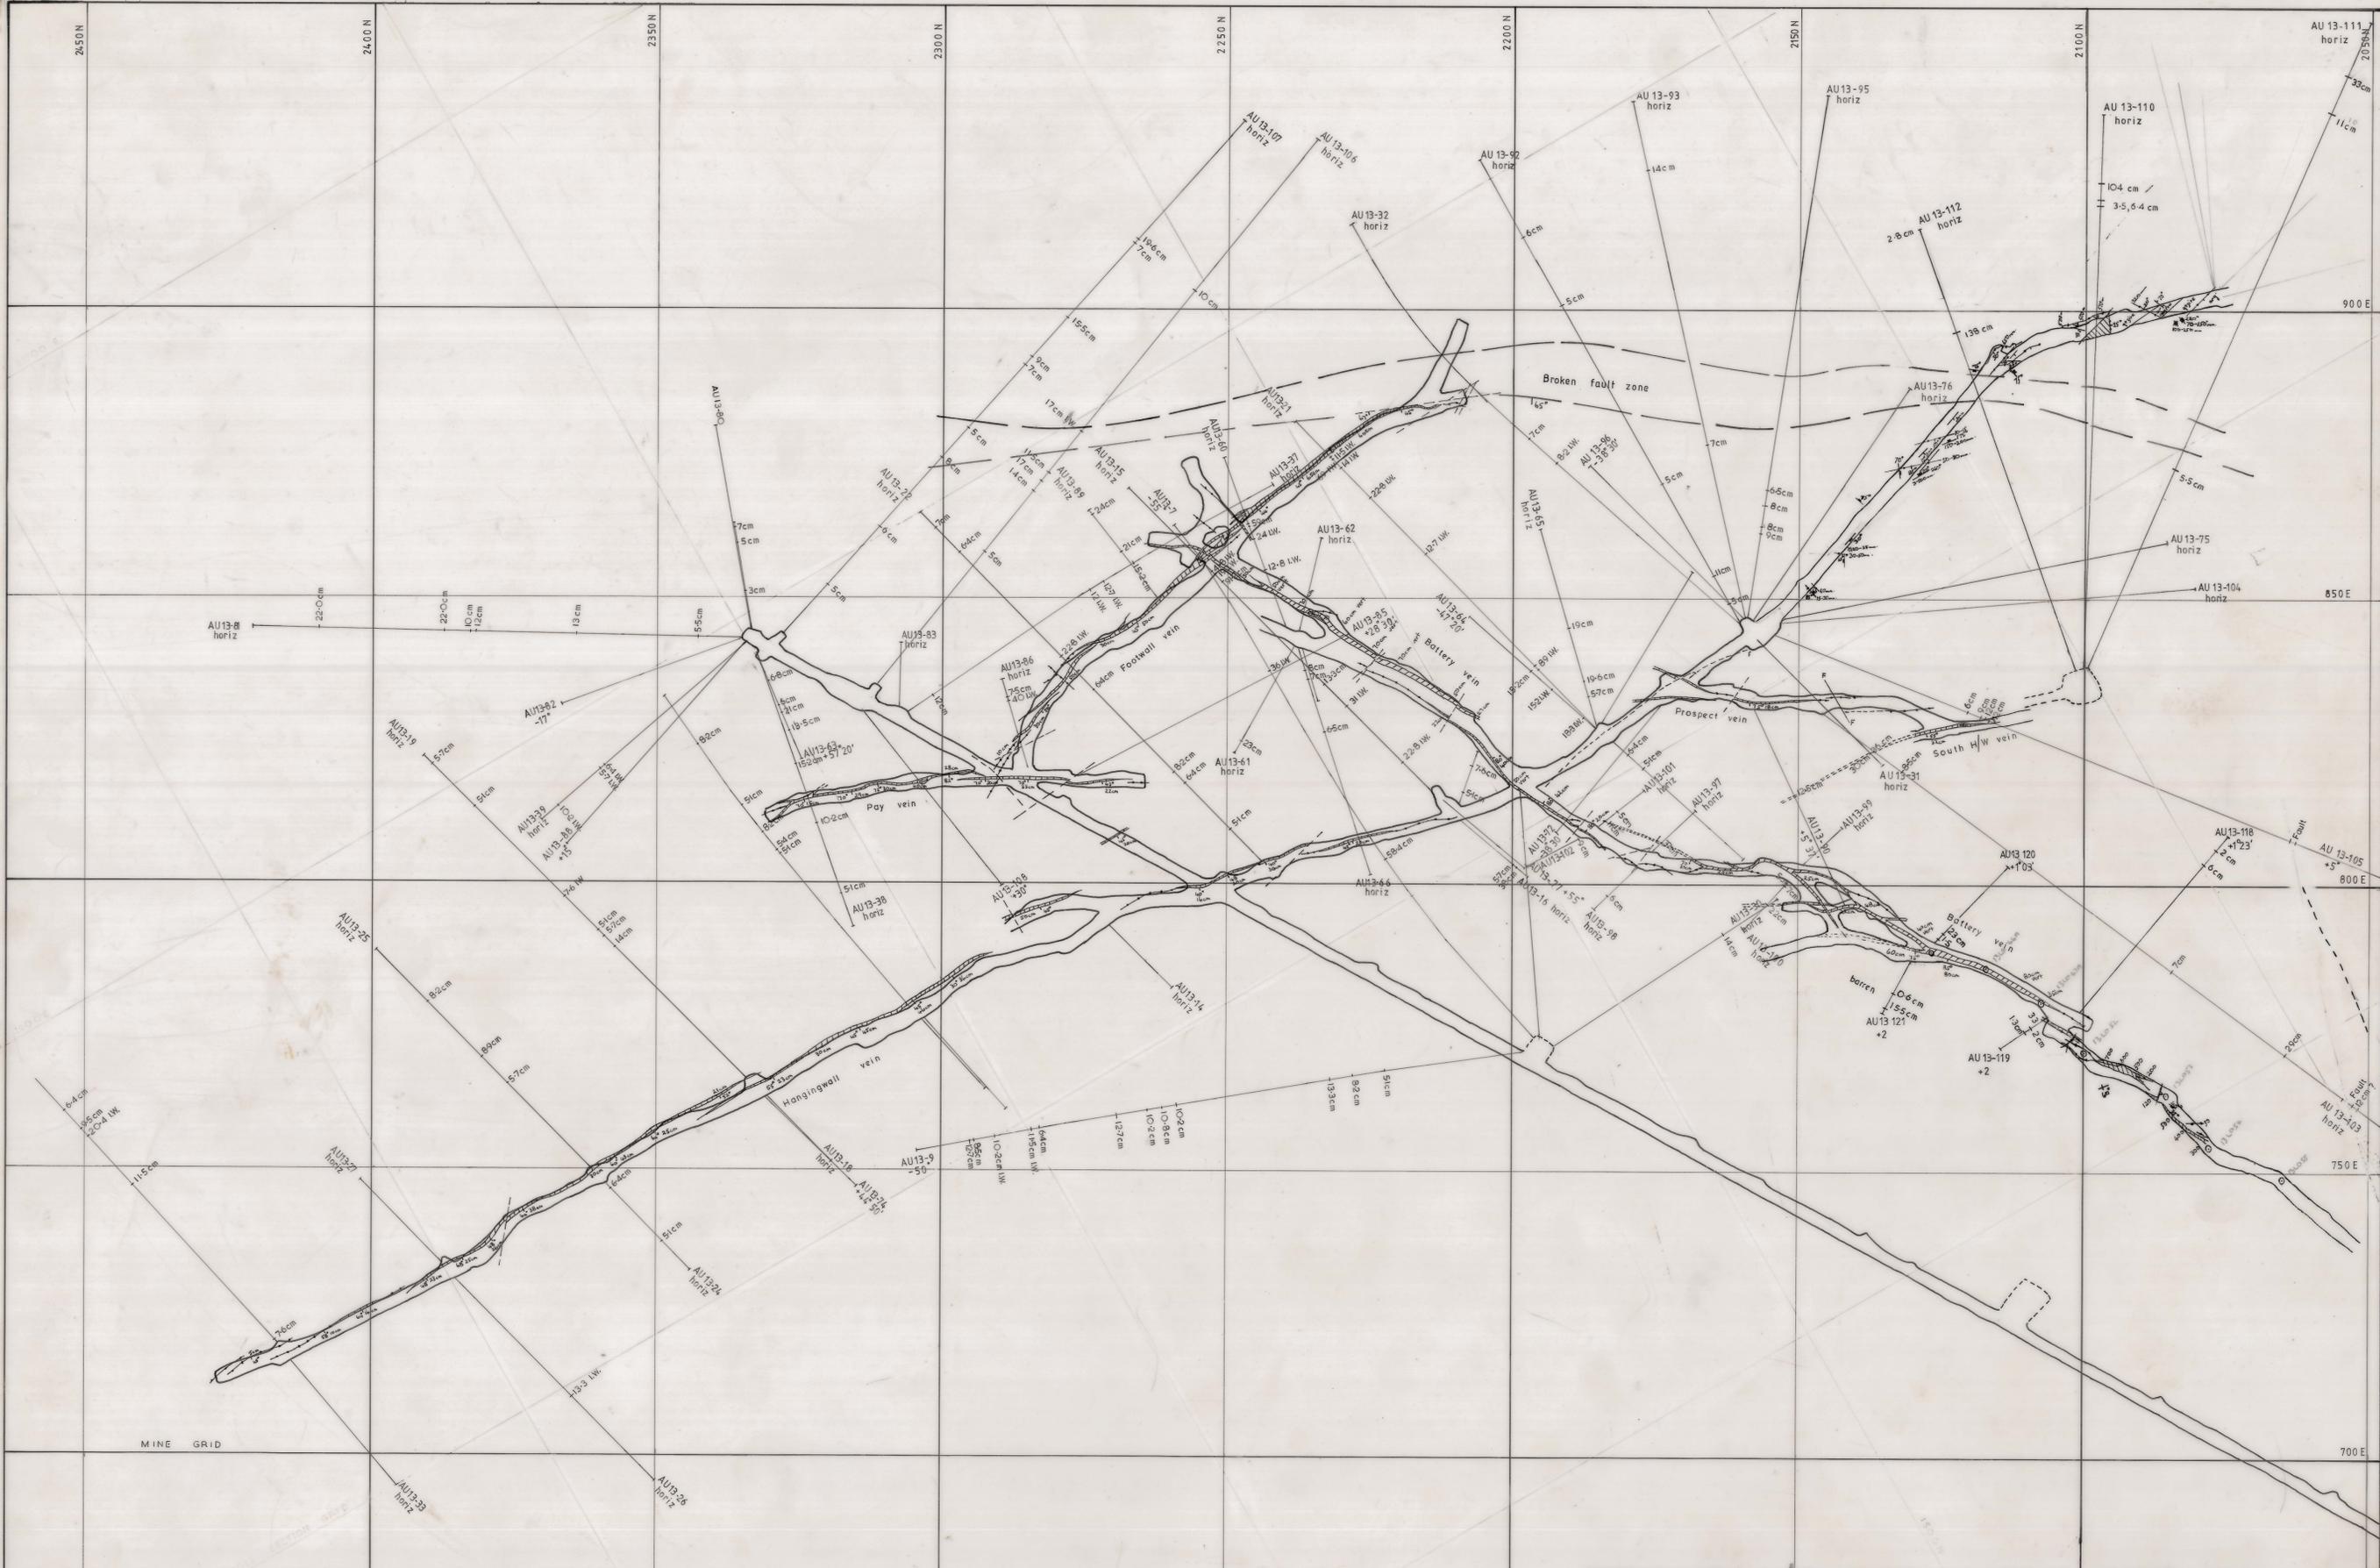


484

ABERF_484

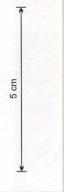

Approved	Date	Sign	Revisions			Date	ROSSARDEN MINES LTD.	
U/G Mgr			No	Remarks	Date	Name	Drawn	DRG No.
Mine Capt.							Traced	
Engineering							Refer	
Geology	30/1/80	E. K.W.						SCALE 1:500

LUTWYCHE
13 LEVEL
GEOLOGY