
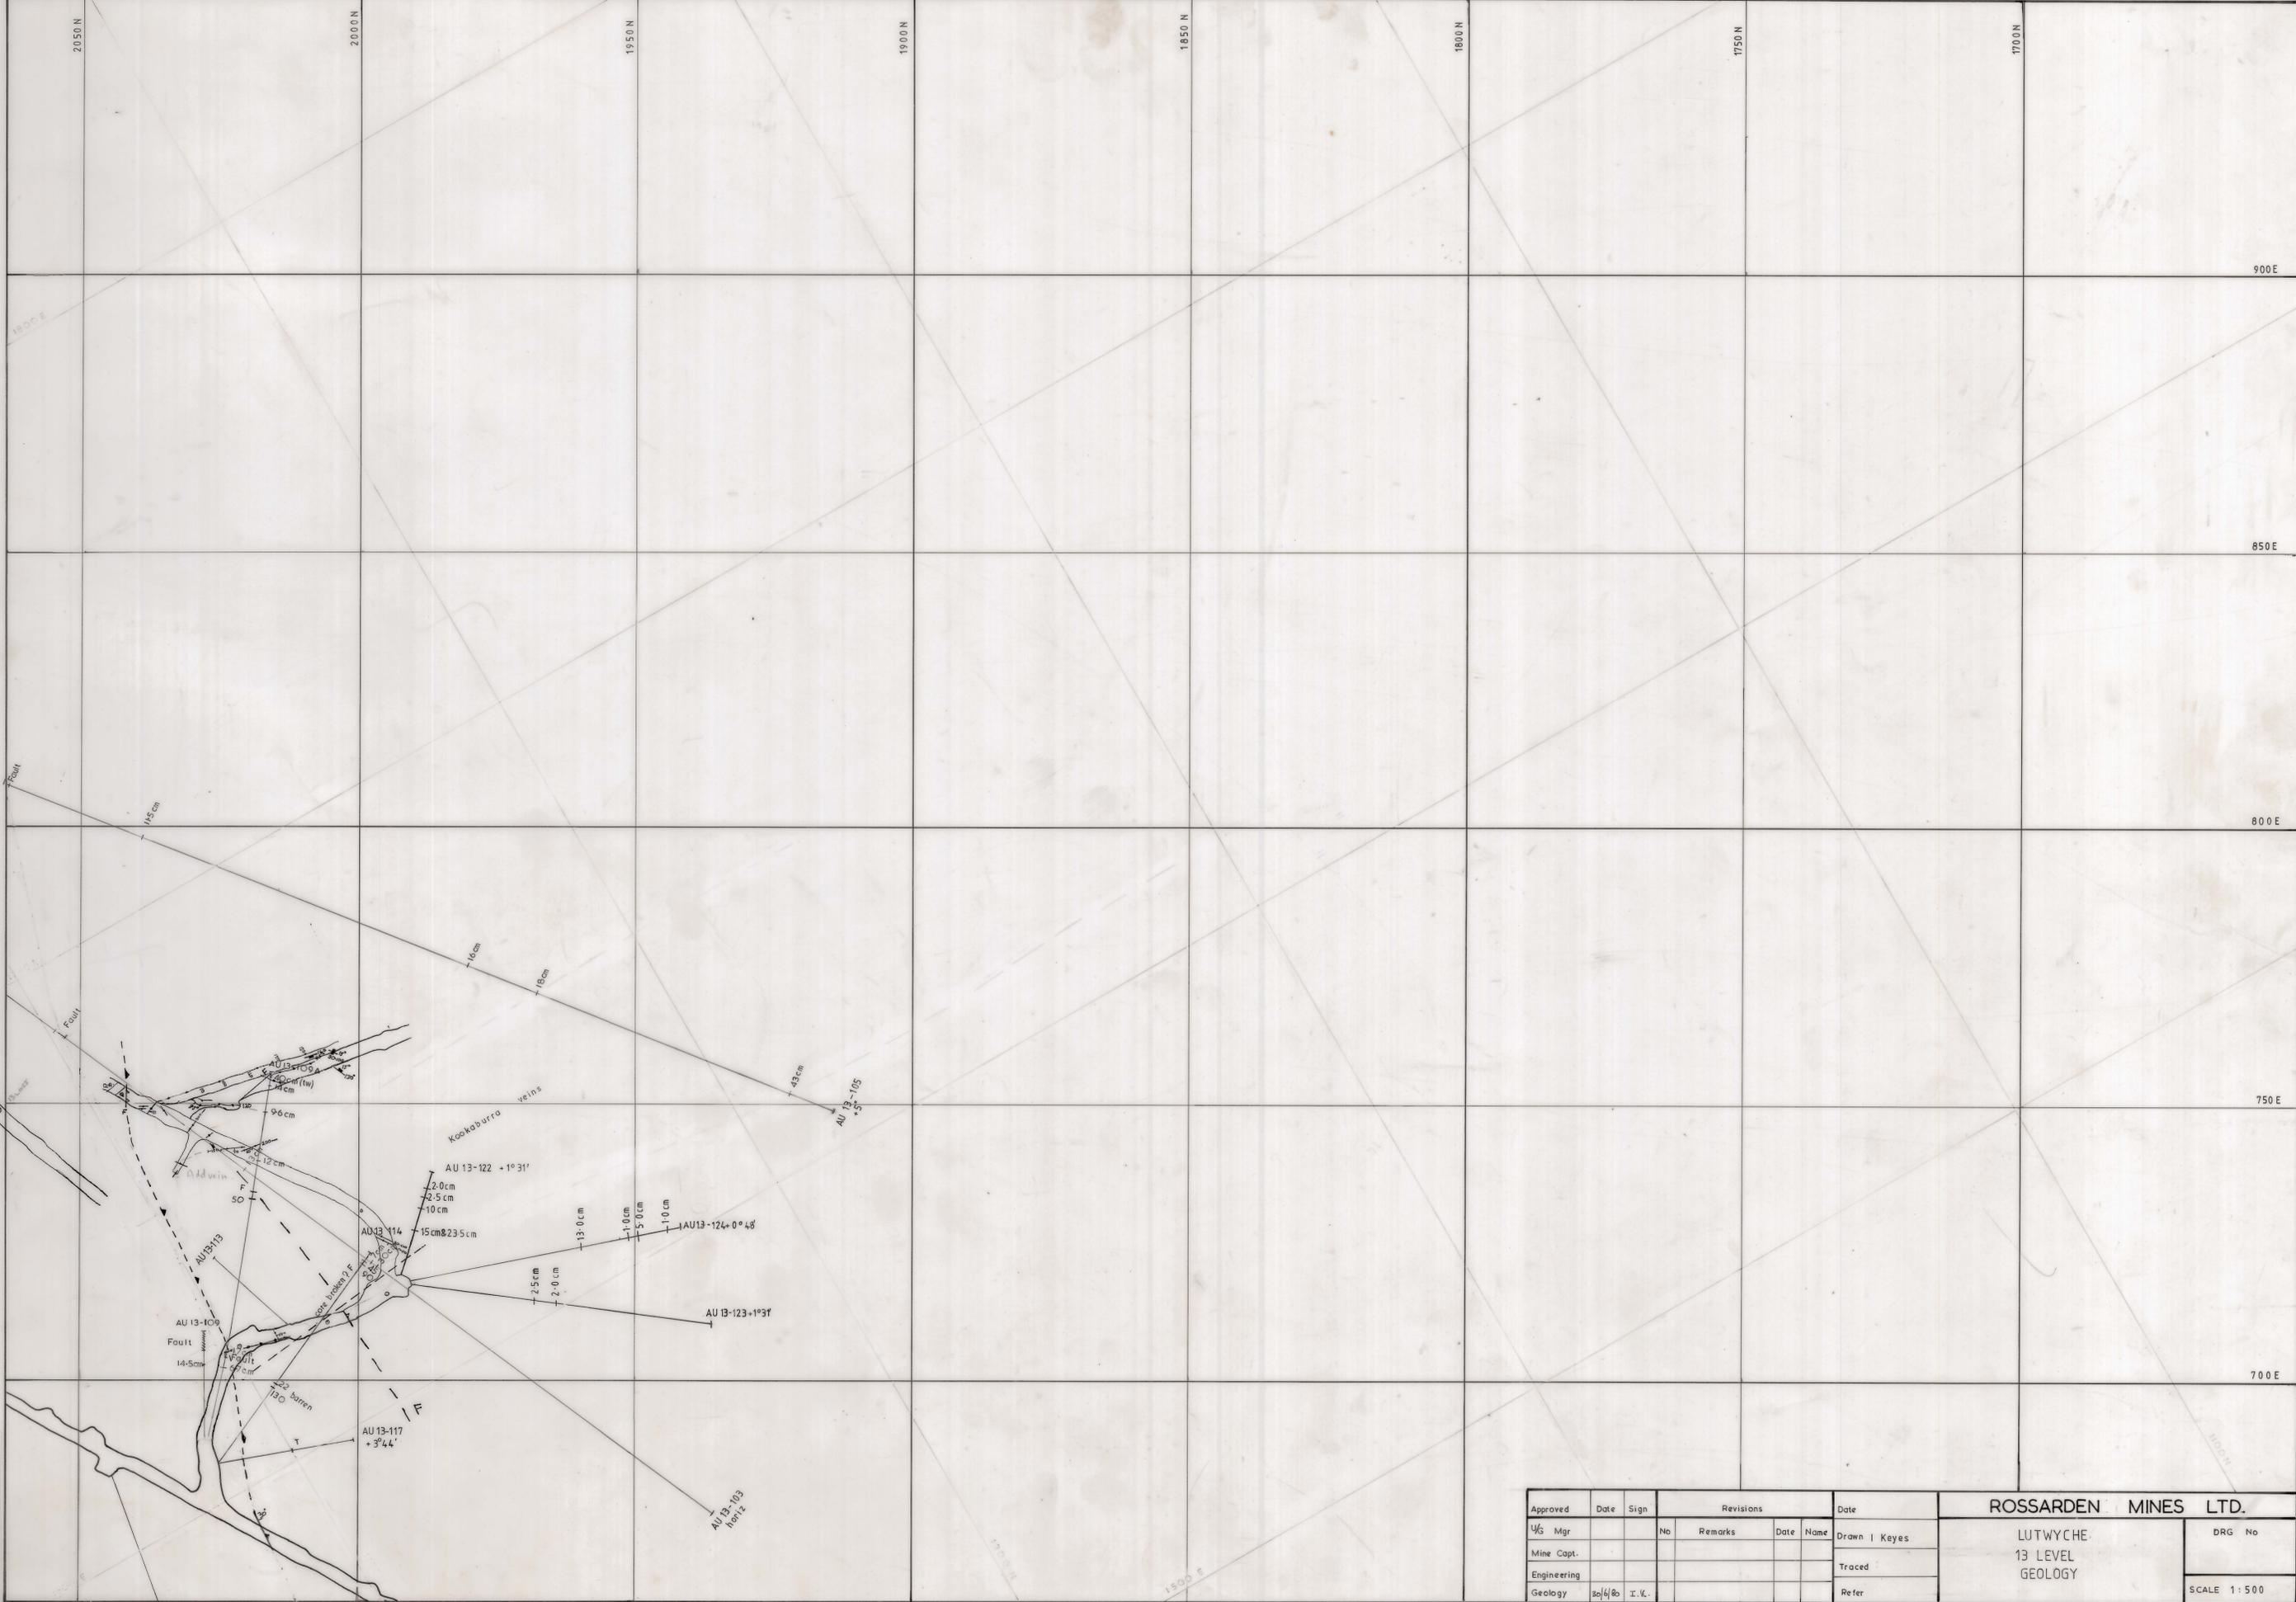


485

ABERF_485

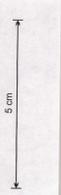

Approved	Date	Sign	Revisions			Date	ROSSARDEN MINES LTD.	
U/S Mgr			No	Remarks	Date	Name	Drawn Keyes	DRG No
Mine Capt.							Traced	
Engineering							Refer	
Geology	20/4/80	J.V.						SCALE 1:500

LUTWYCHE
13 LEVEL
GEOLOGY