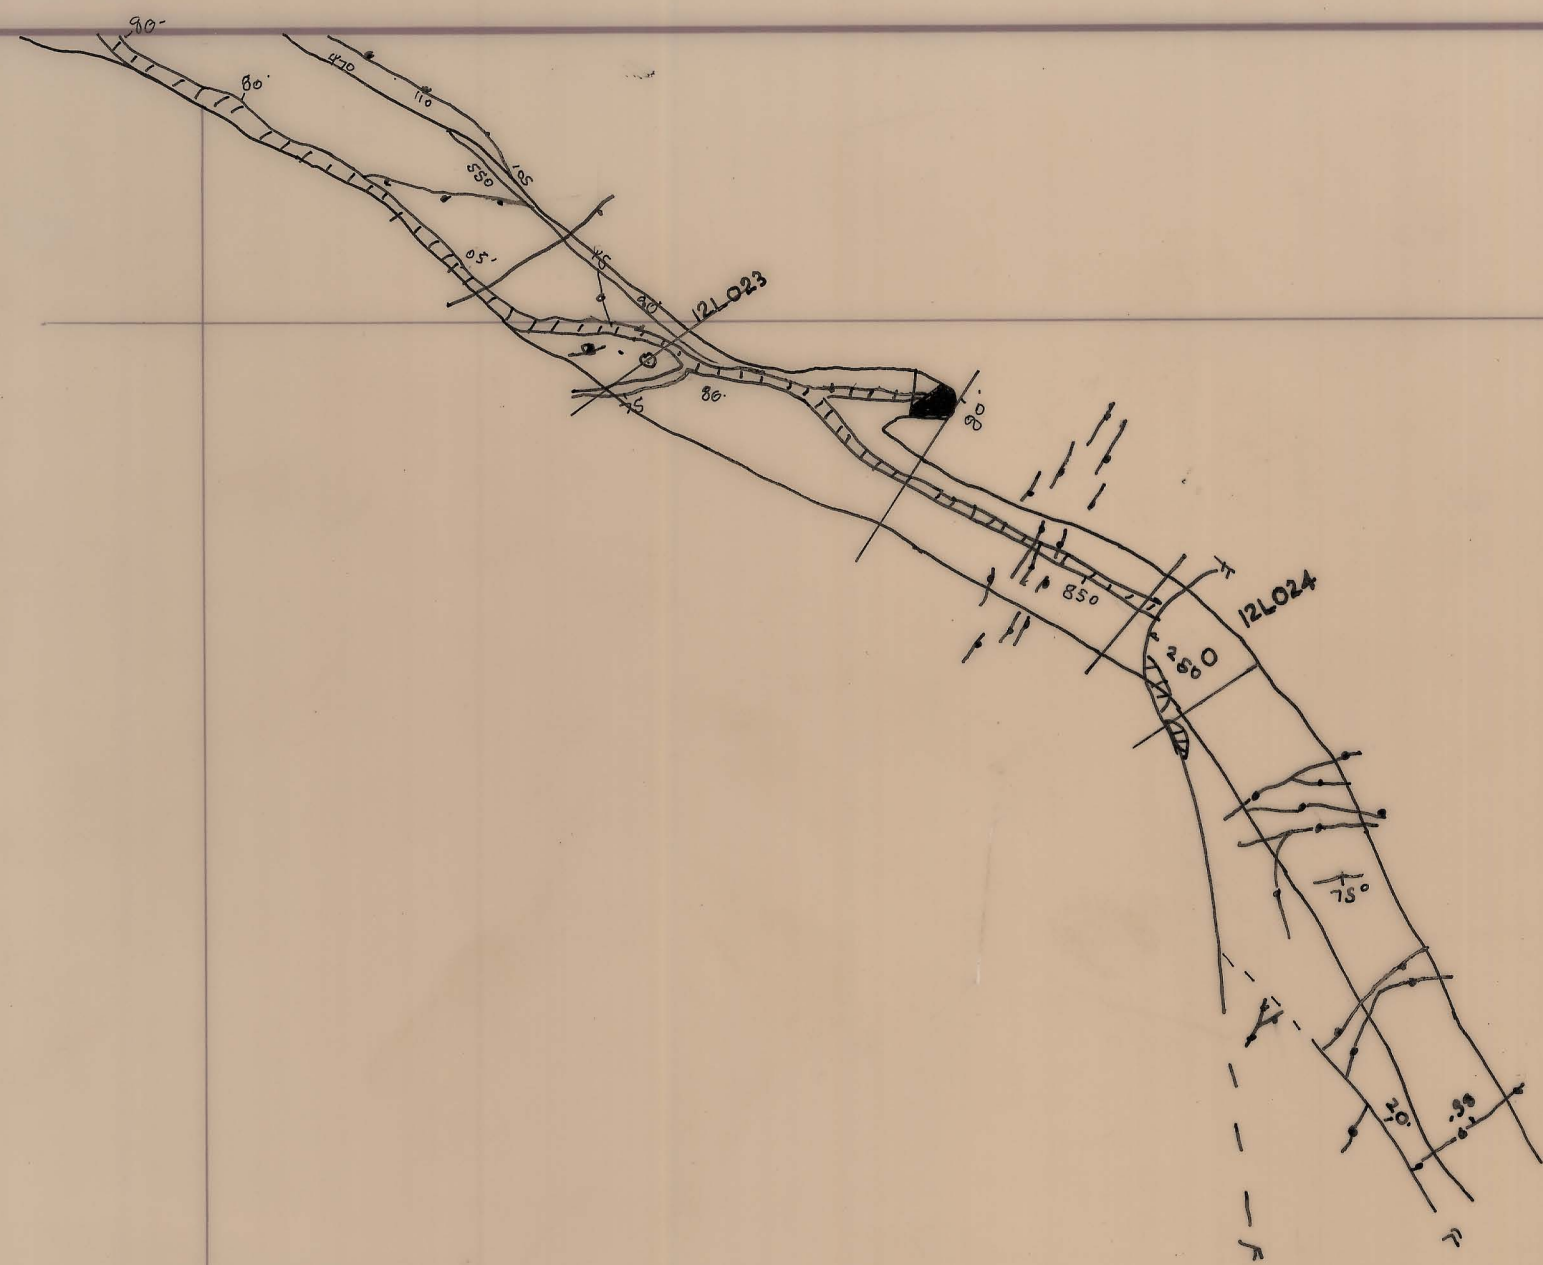


ABERF_489

489

ROSSARDEN MINES LTD.

GEOLOGY PLAN
12 LEVEL

Drawn
Scale 1:200
Date