

2300N

2250 N

2200N


2150 N

1000 E

1000 E

950 E

950 E

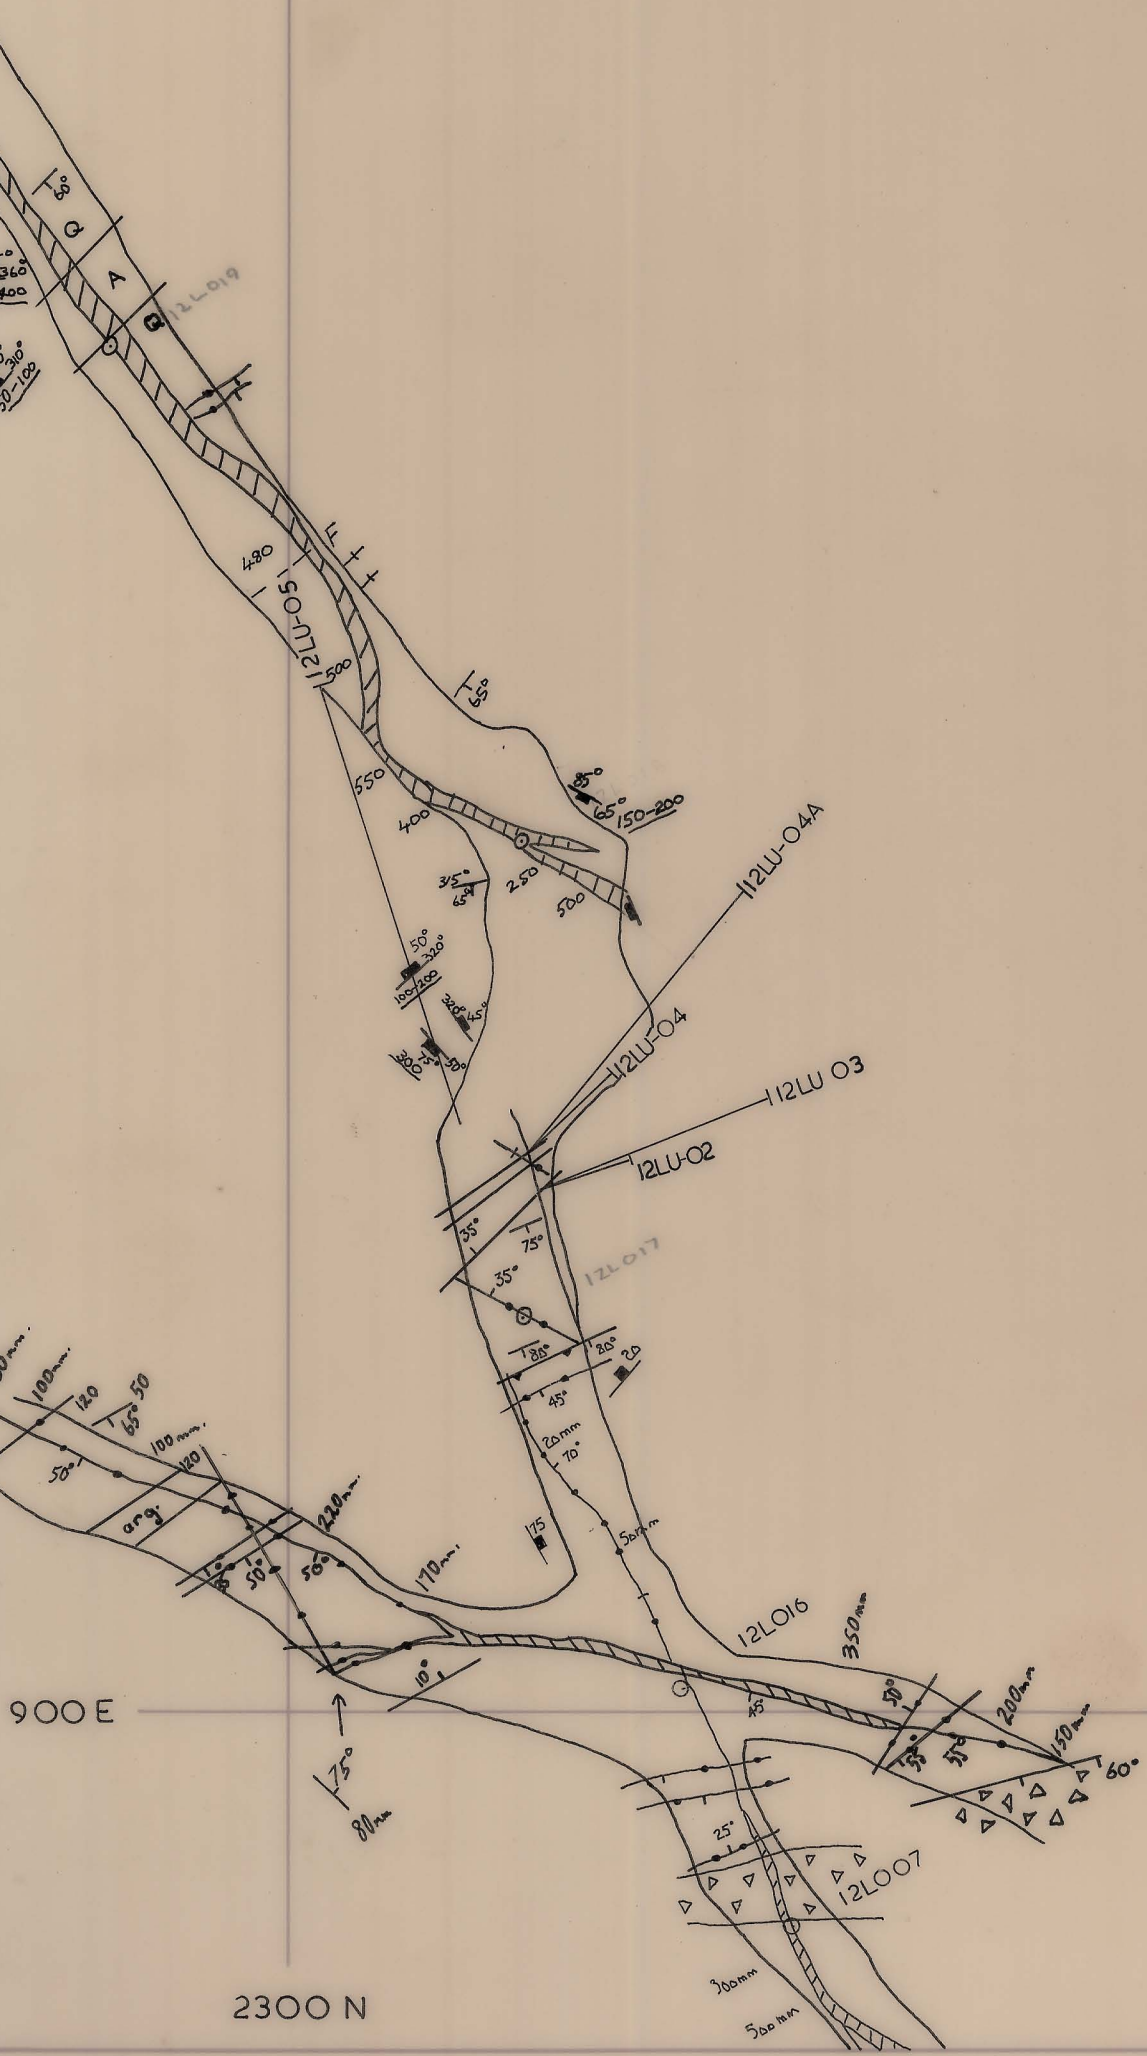

2300 N

2250 N


2200 N

2150N

ROSSARDEN MINES LTD.

GEOLOGY PLAN
12 LEVEL LUTWYCHE

Date: August 1981
Scale: 1:200
Drawn:

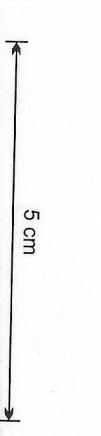

ABERF_490

490