

2450

2400

2350

2300

1000

1000

950


950

900

2400

2400

2350

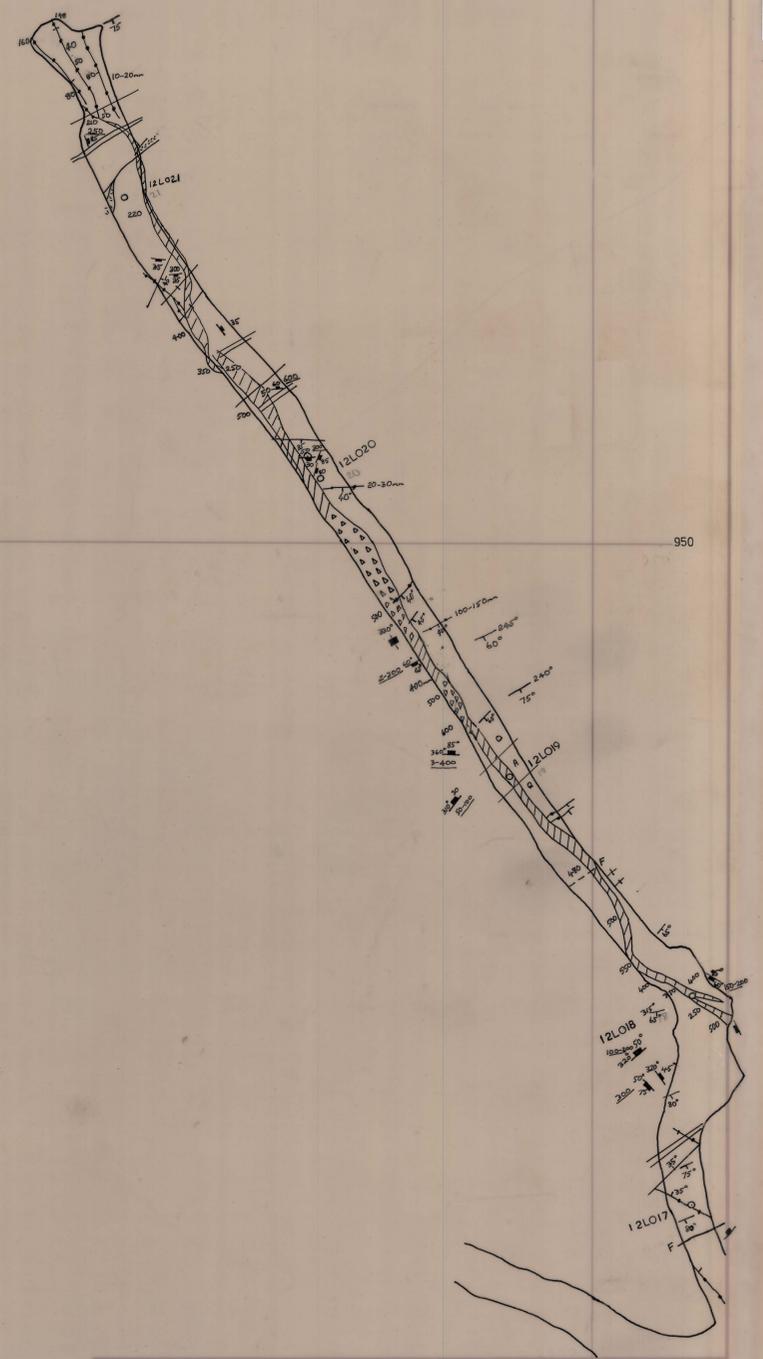

ABERF_491

491

ROSSARDEN MINES LTD.

GEOLOGY PLAN
12 LEVEL

Drawn	
Scale	1:200
Date	