


518

ABERF_518

5 cm

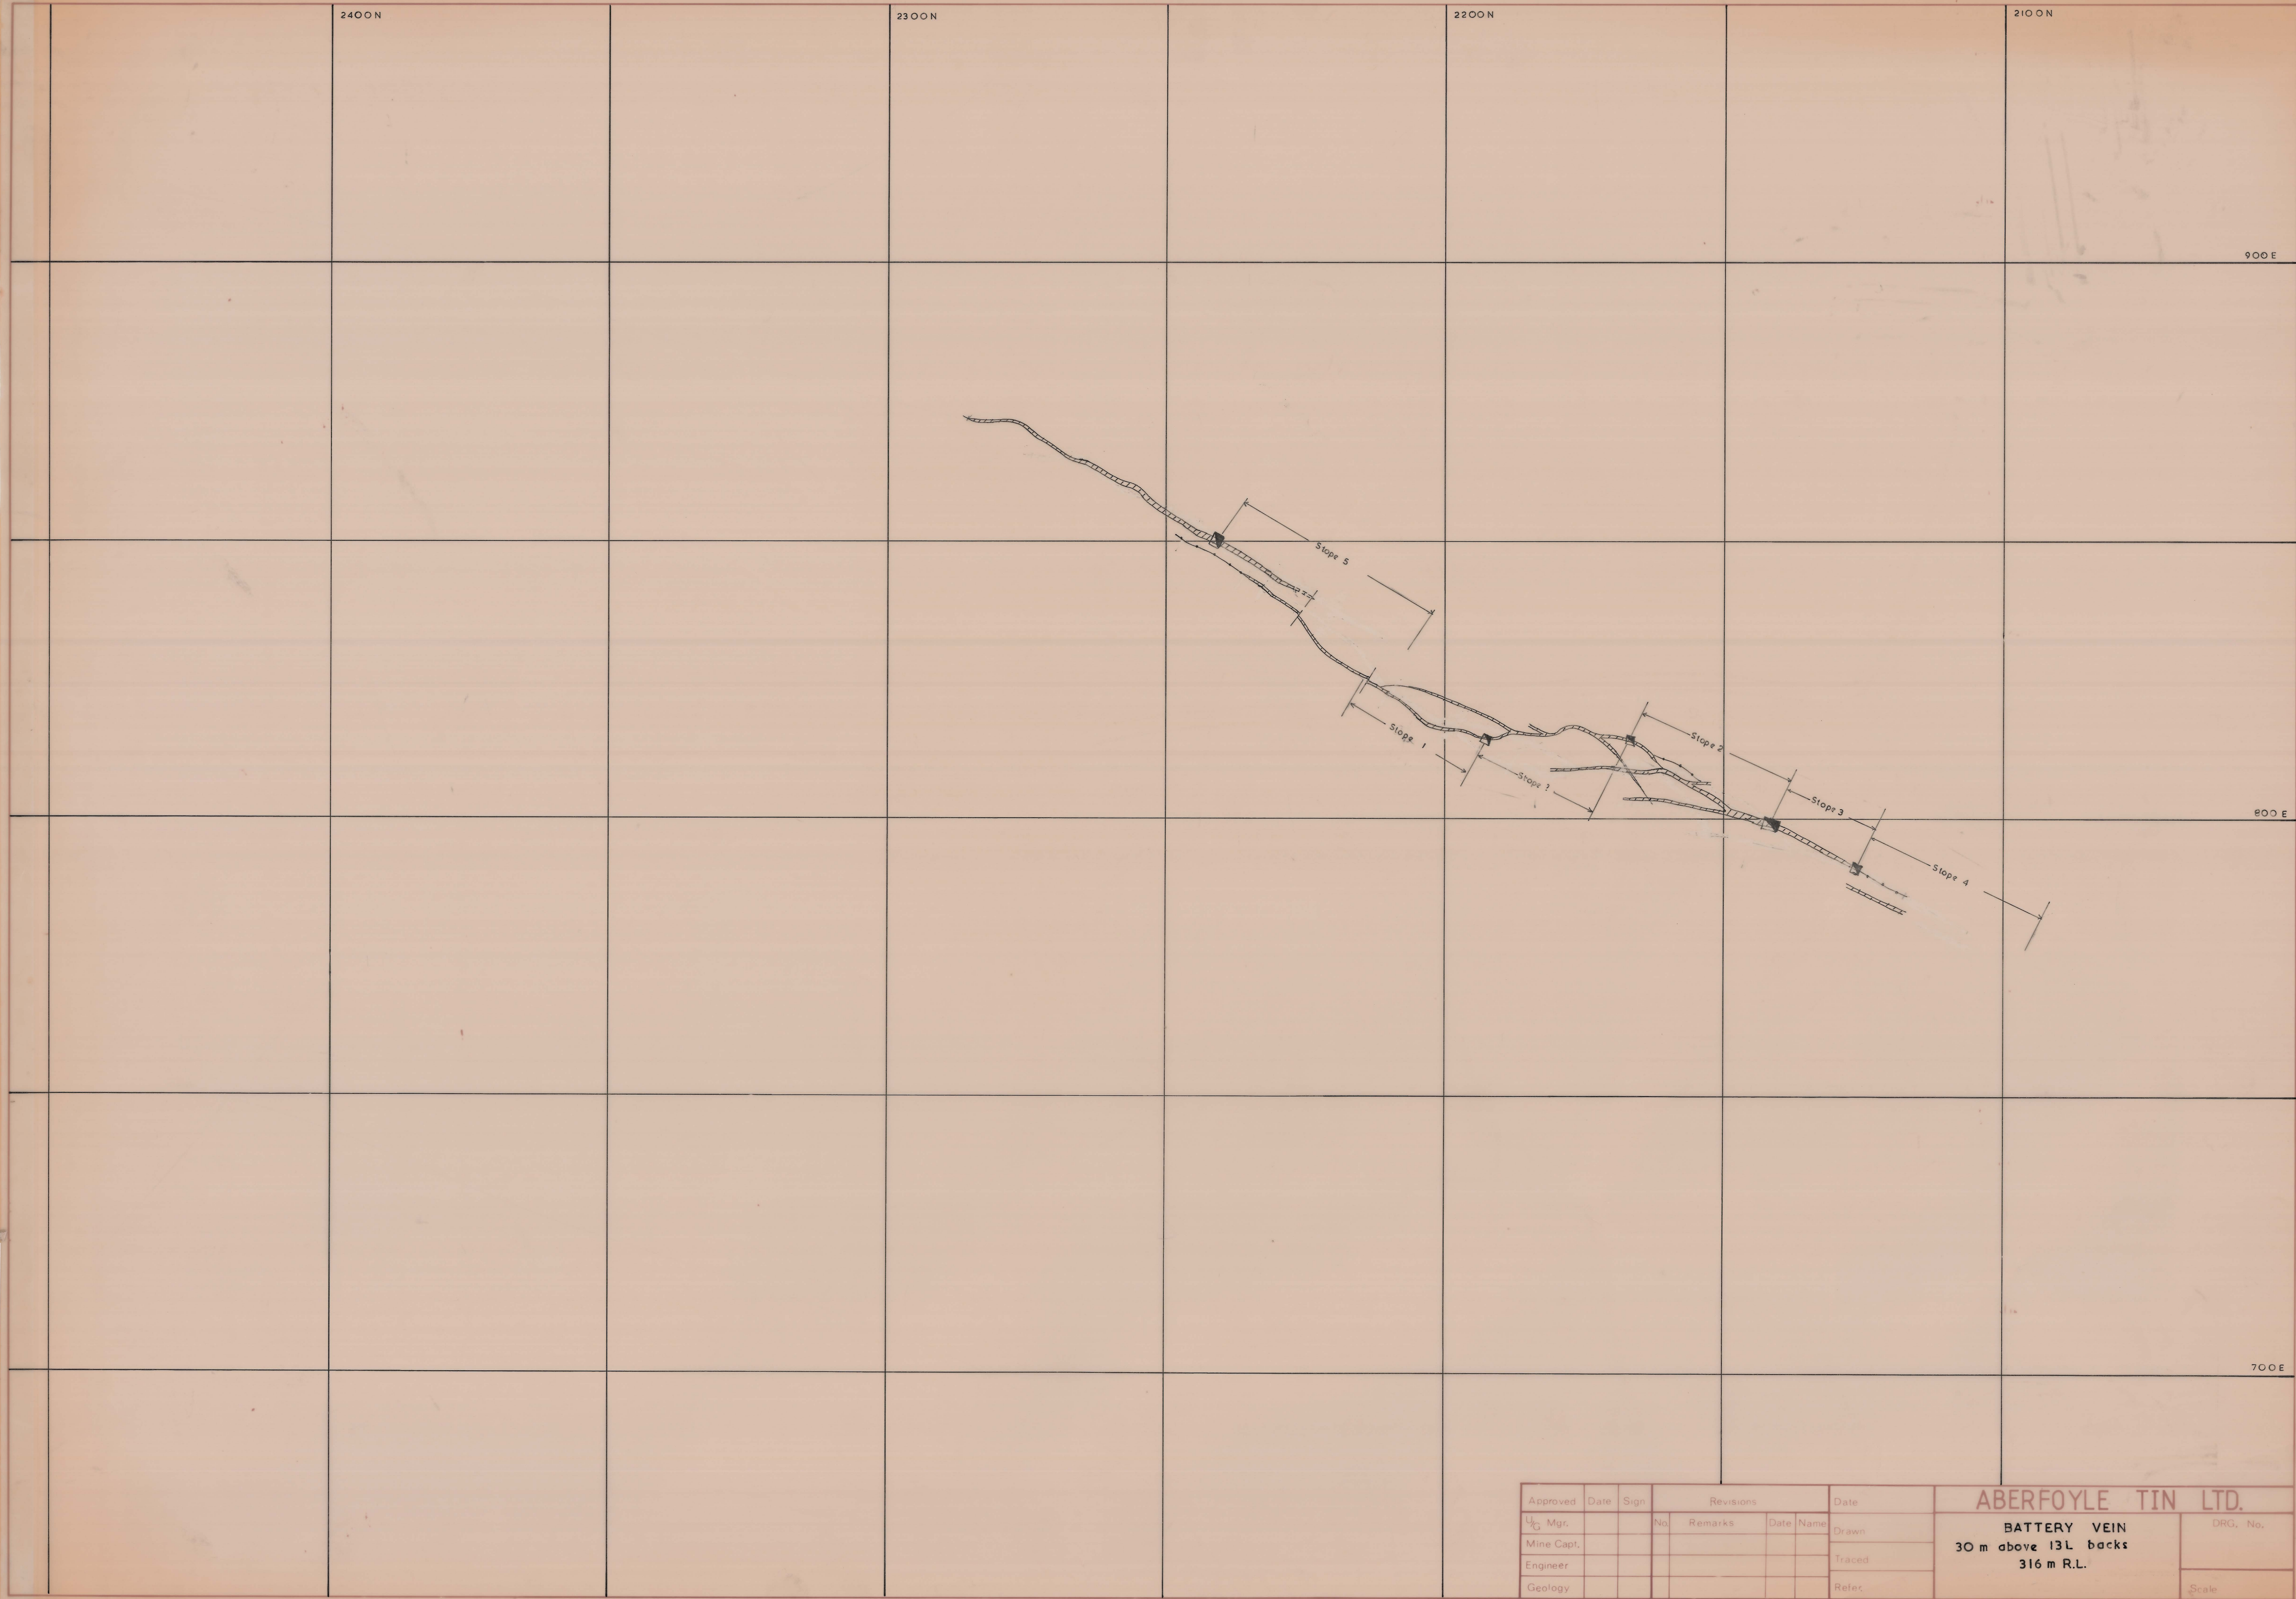

Approved	Date	Sign	Revisions			Date
U/G Mgr.			No.	Remarks	Date	Name
Mine Capt.						
Engineer						
Geology						

ABERFOYLE TIN LTD.		DRG. No.
BATTERY VEIN		
30 m above 13L backs		
316 m R.L.		
Scale		