


527

ABERF_527

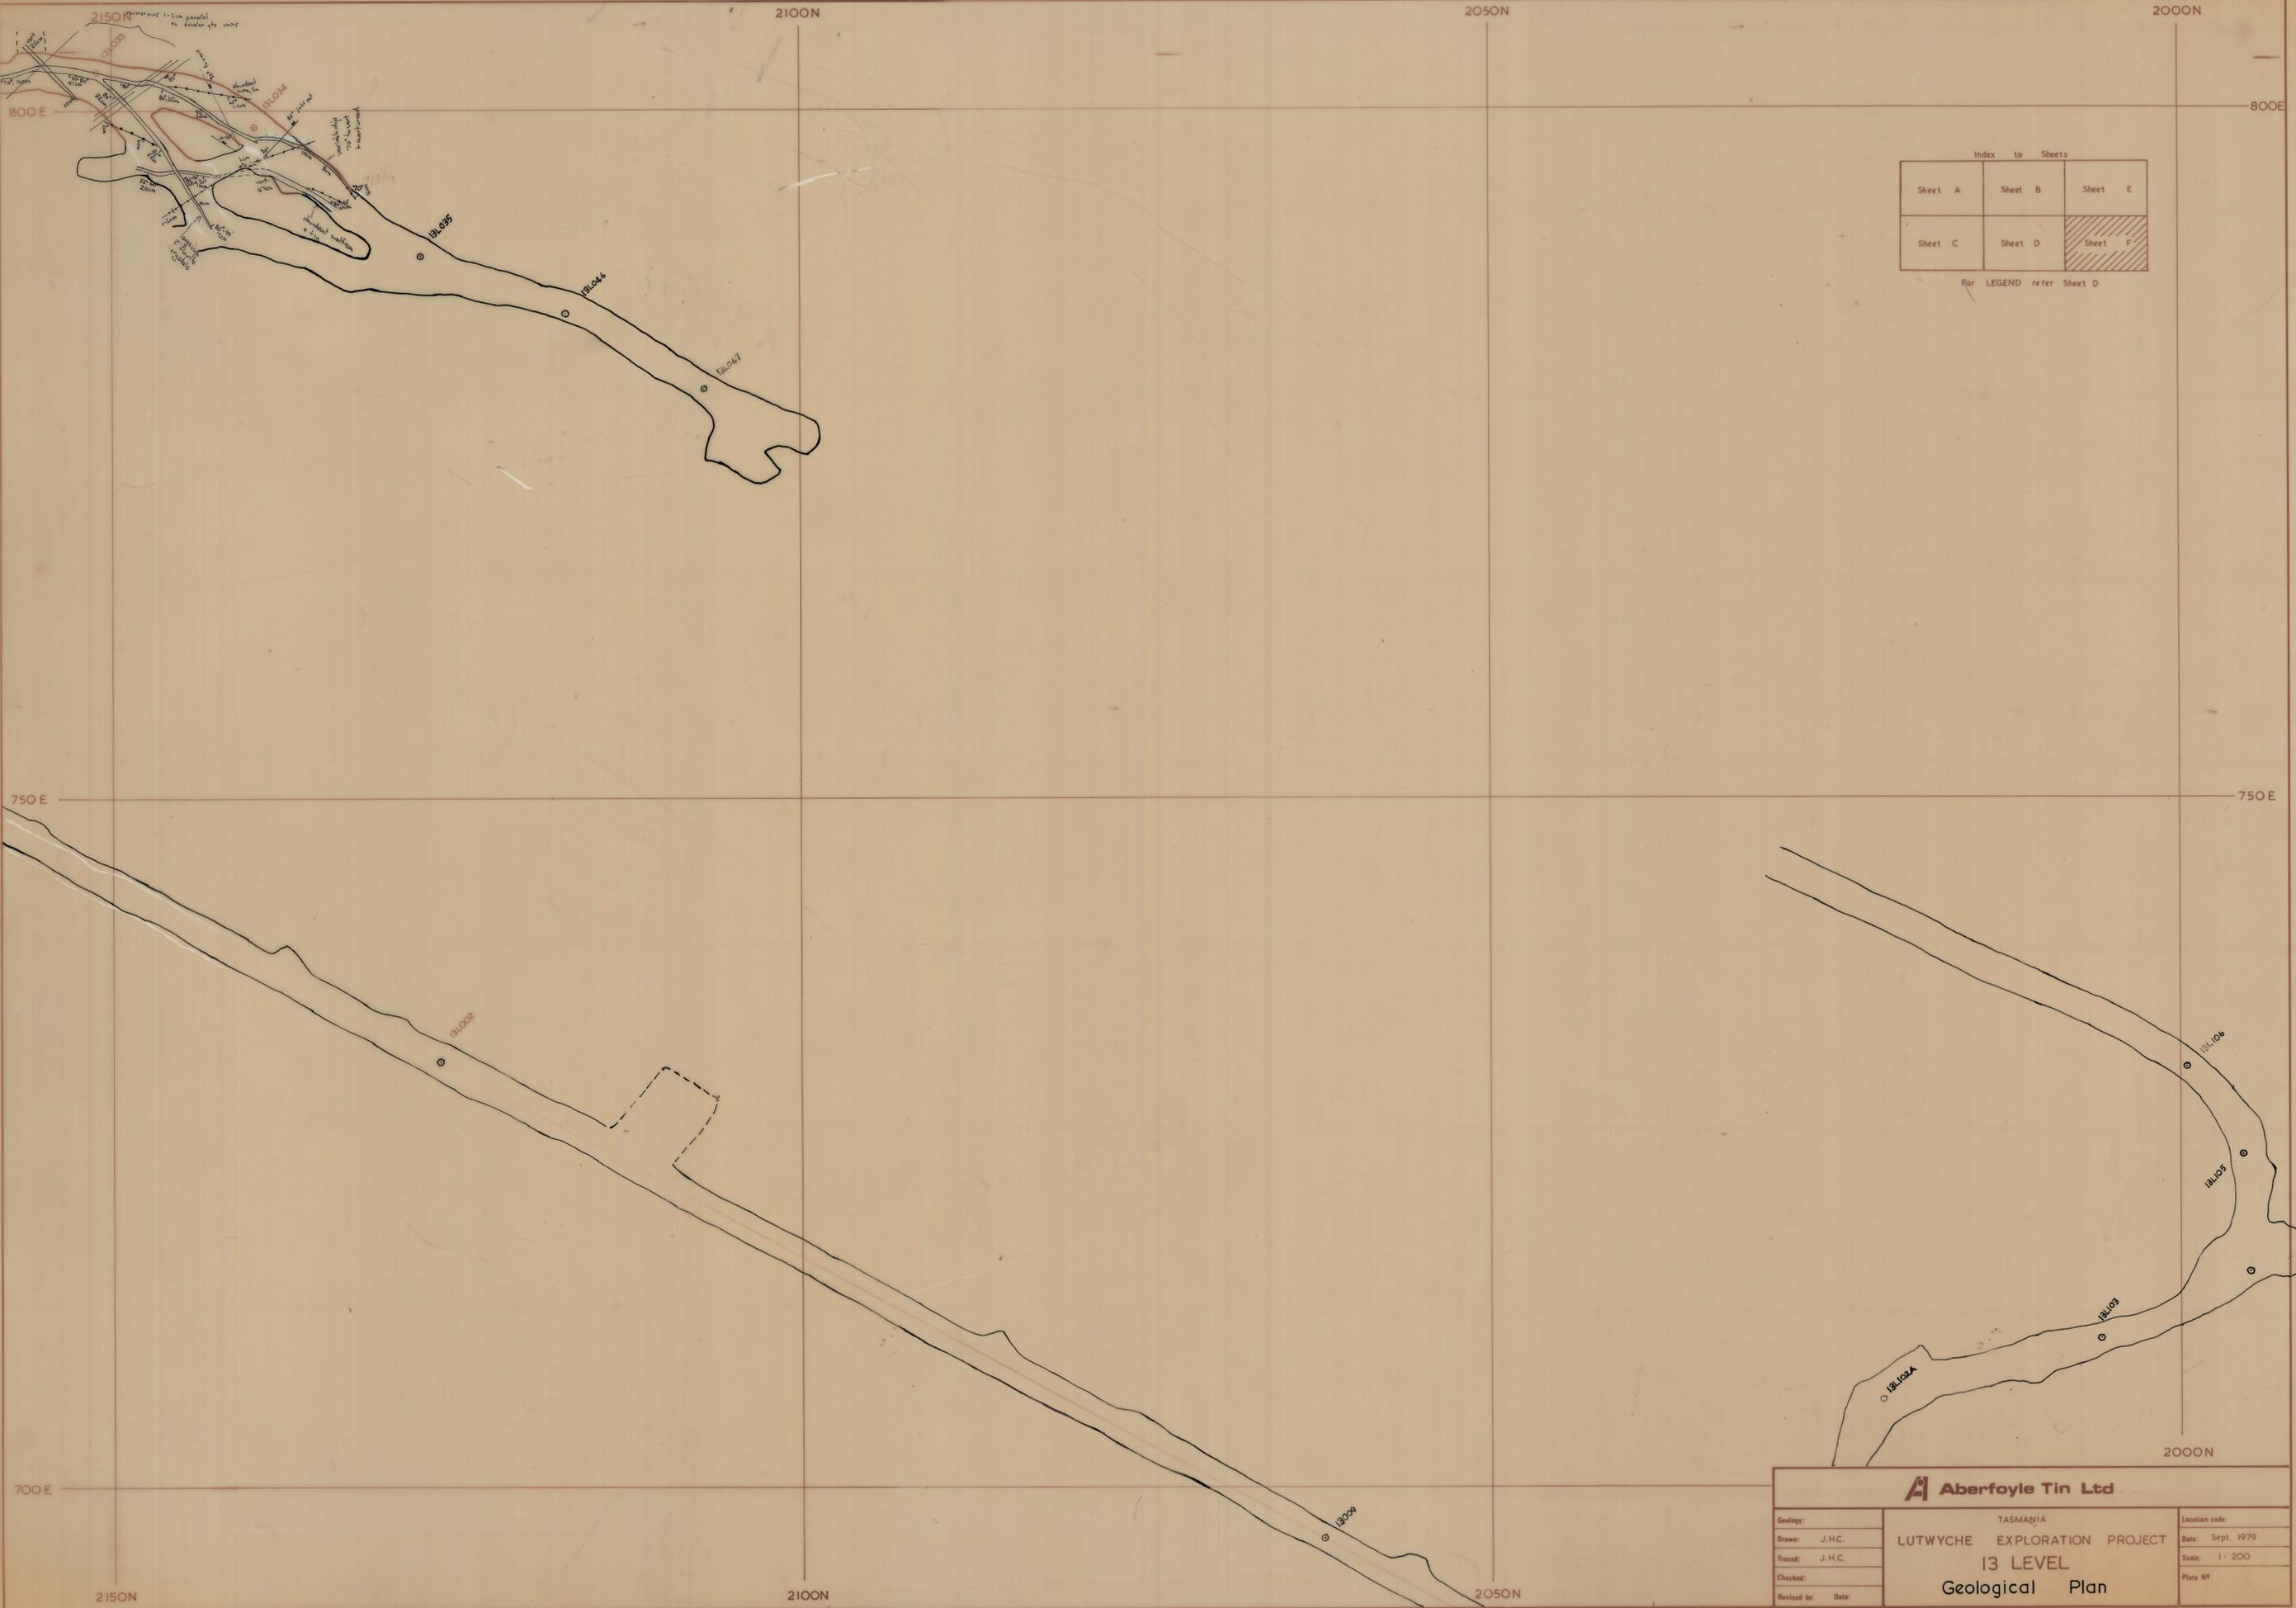

Index to Sheets

| | | |
|---------|---------|---------|
| Sheet A | Sheet B | Sheet E |
| Sheet C | Sheet D | Sheet F |

For LEGEND refer Sheet D

Aberfoyle Tin Ltd

TASMANIA
LUTWYCHE EXPLORATION PROJECT
13 LEVEL
Geological Plan

| | | | |
|-------------|--------|----------------|------------|
| Geology: | | Location code: | |
| Drawn: | J.H.C. | Date: | Sept. 1979 |
| Traced: | J.H.C. | Scale: | 1:200 |
| Checked: | | Plate No: | |
| Revised by: | Date: | | |