


ABERF-S 88

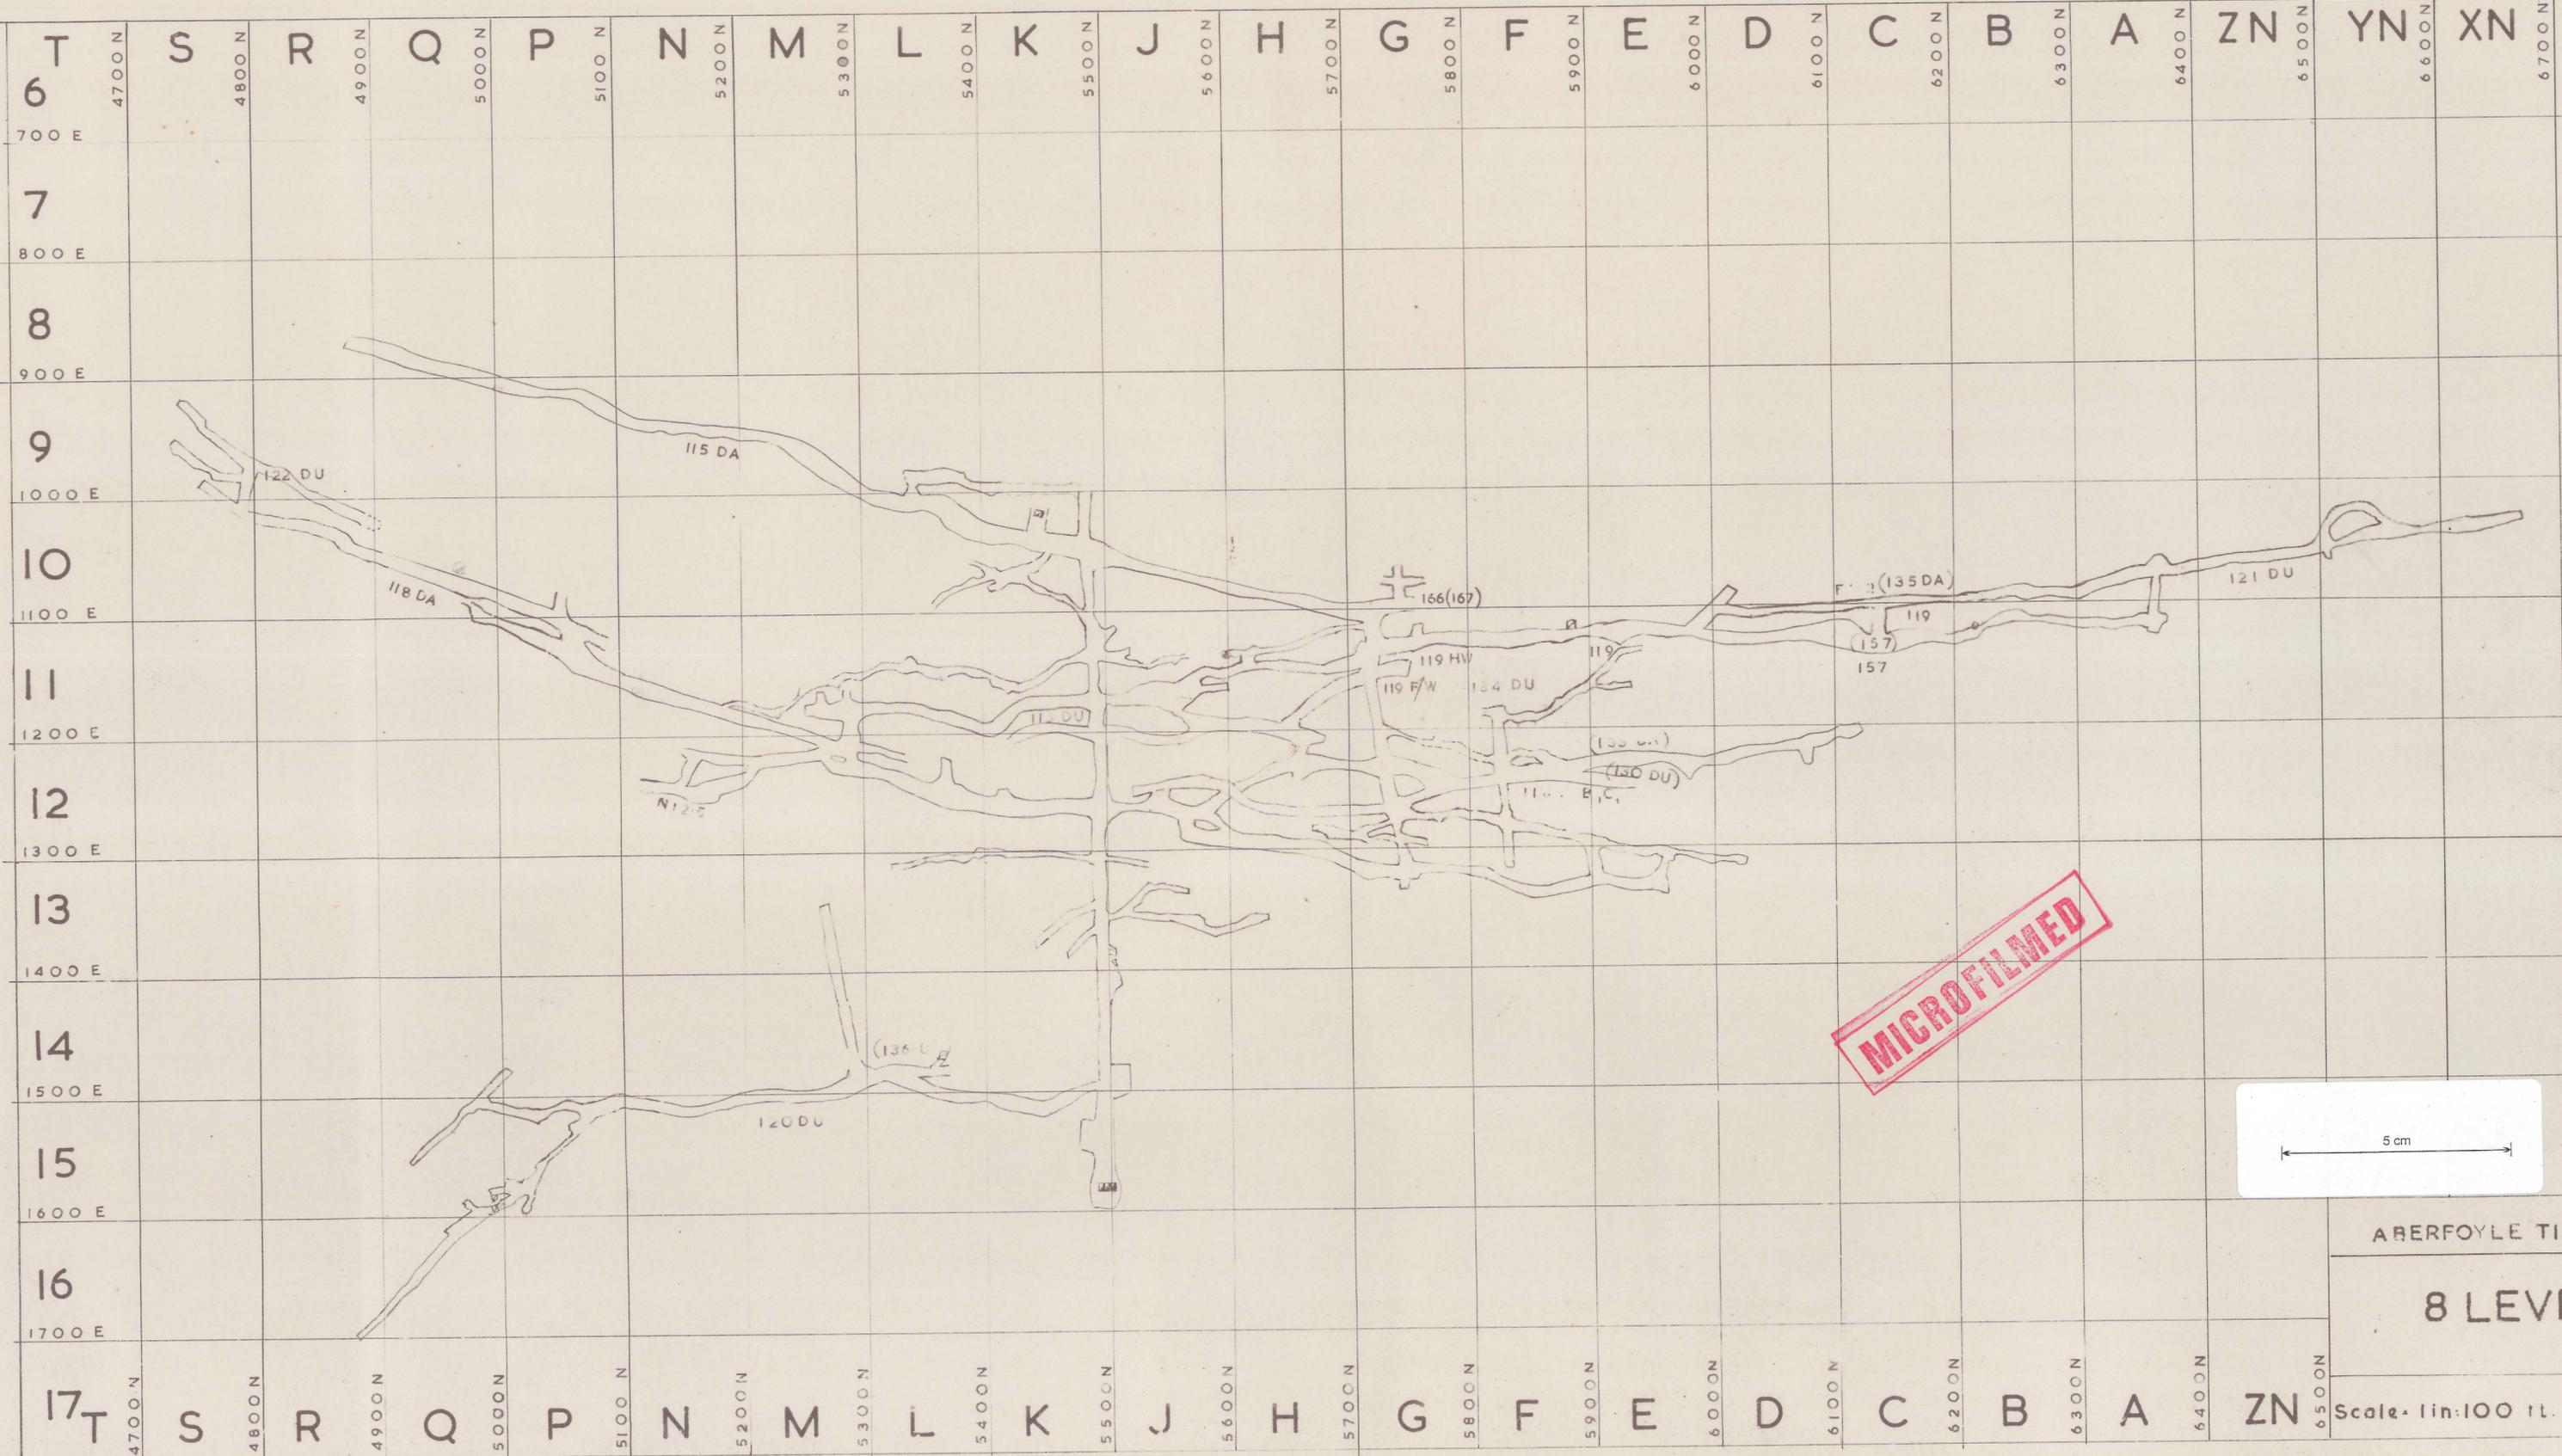

ABERFOYLE TIN N.L.

8 LEVEL

Scale - 1 in: 100 ft.

76091