


ABERF - 590

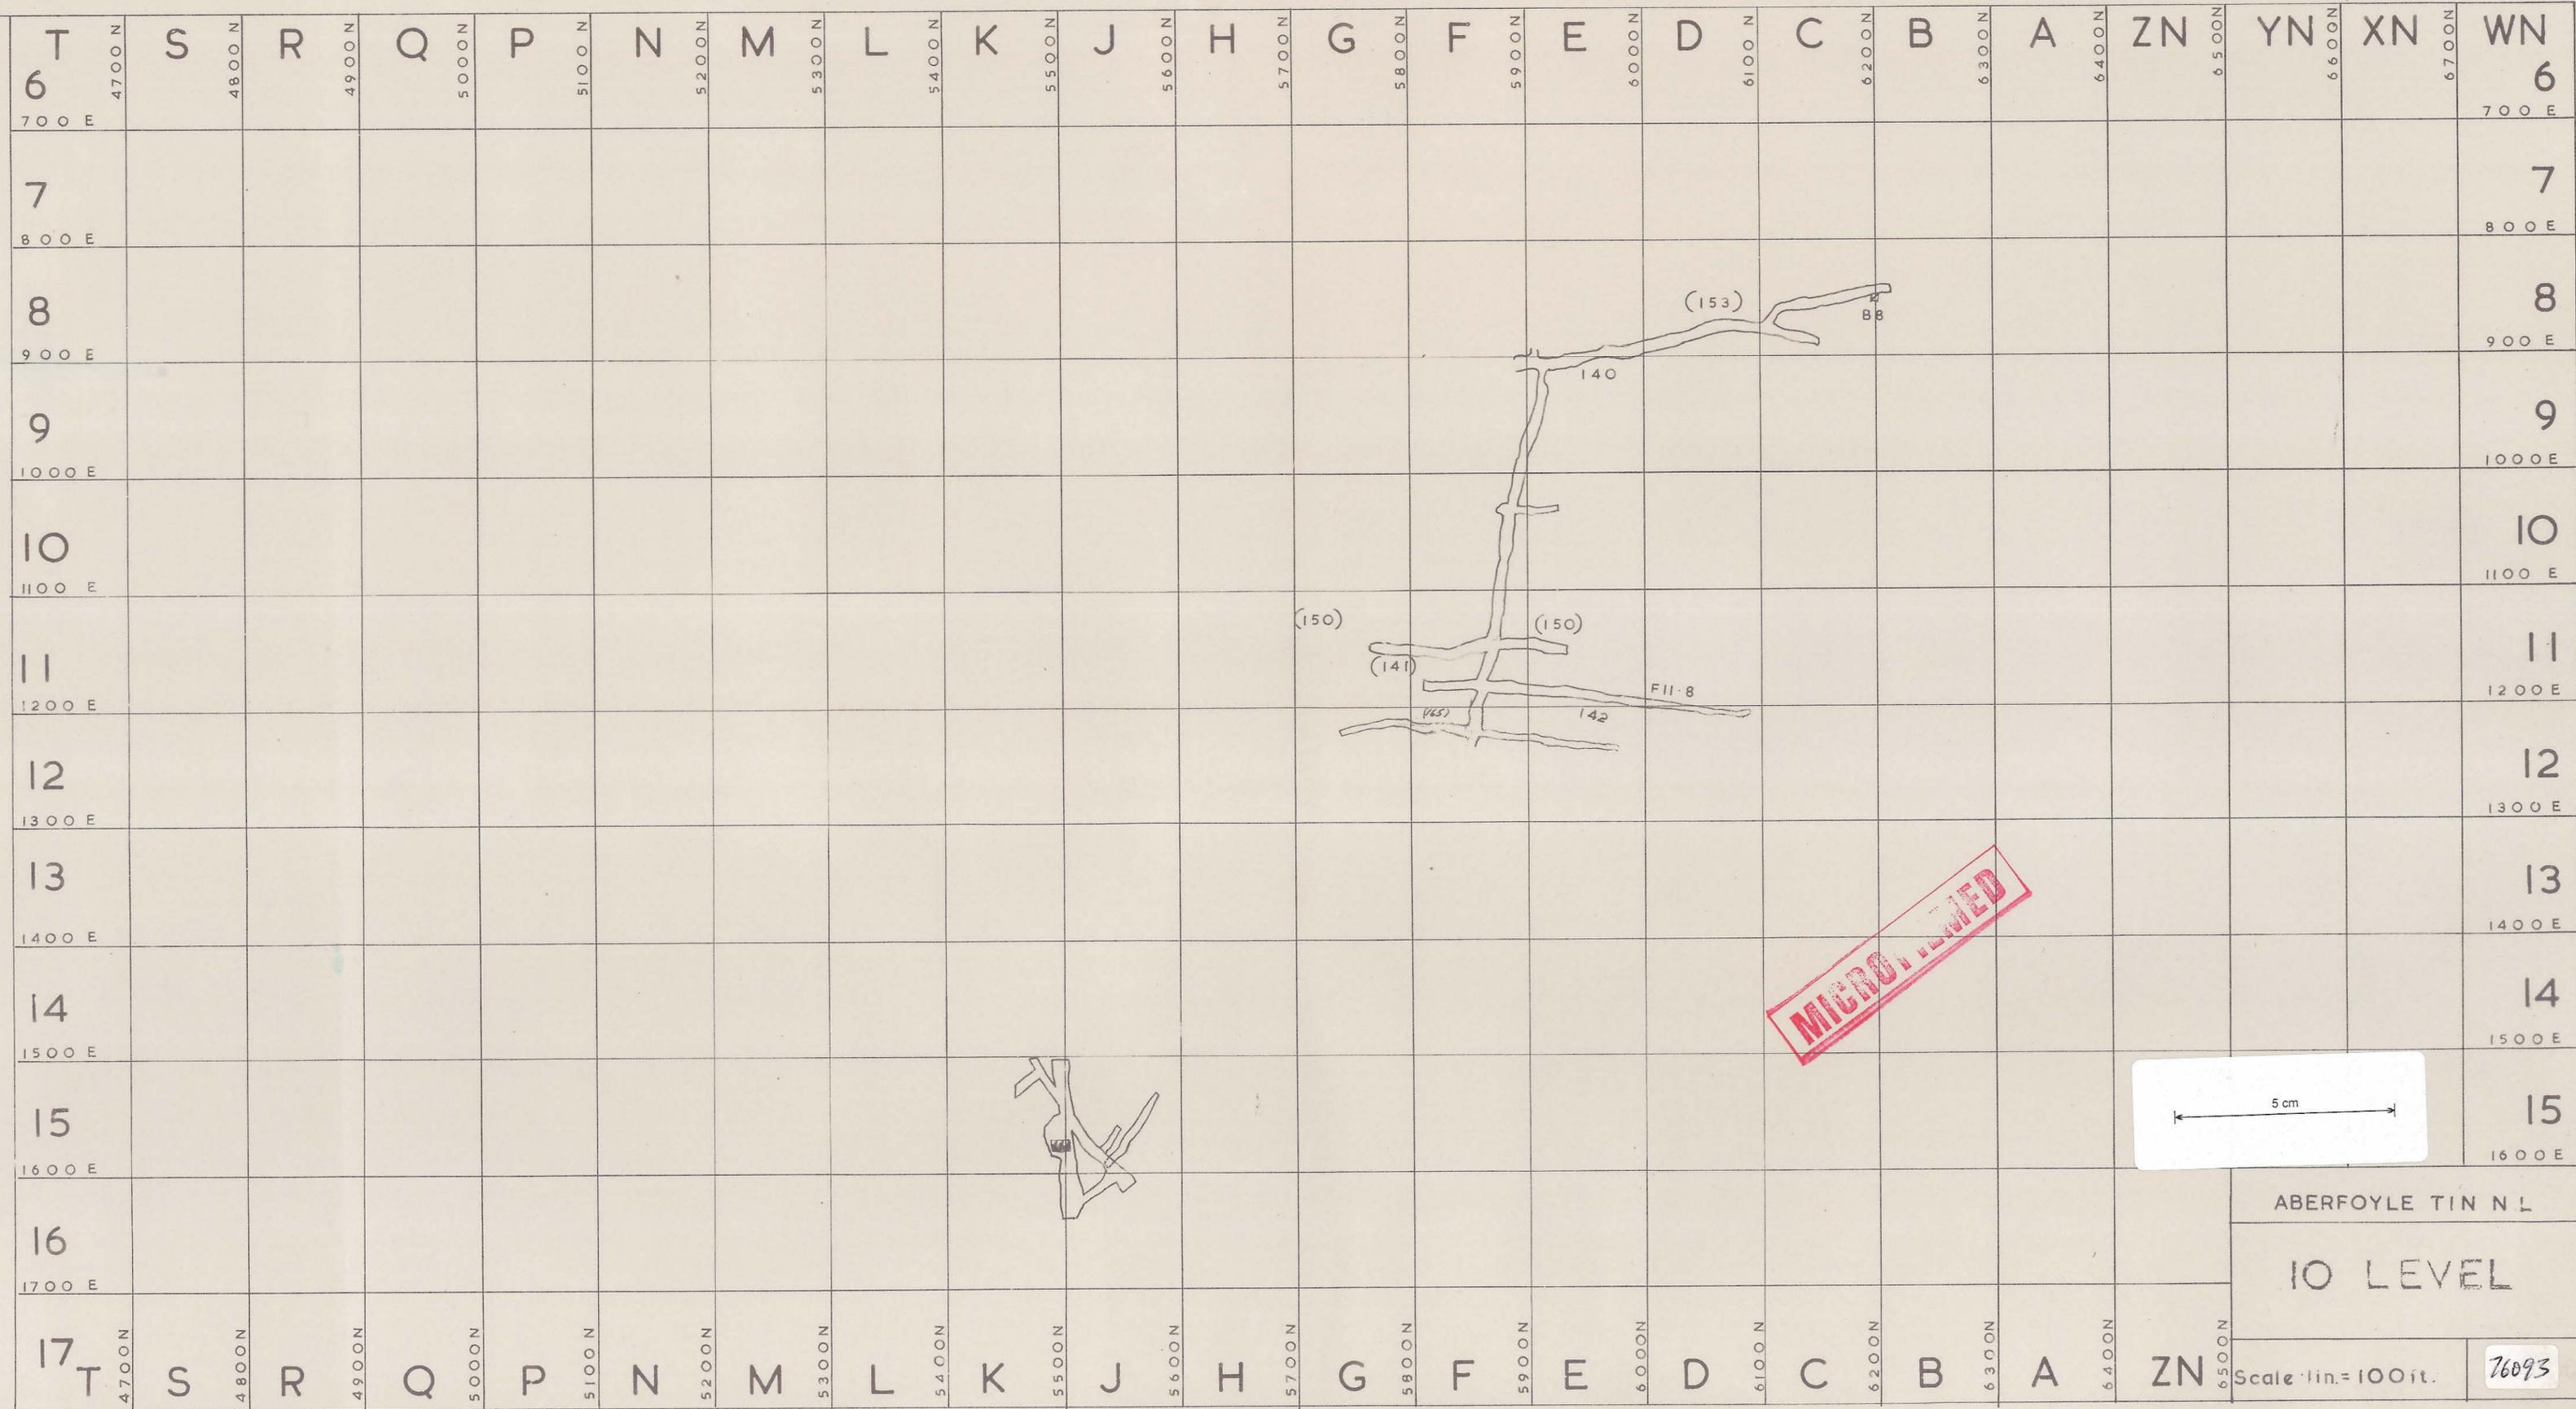

ABERFOYLE TIN N L

10 LEVEL

Scale 1 in. = 100 ft.

76093