



ABERF - 592

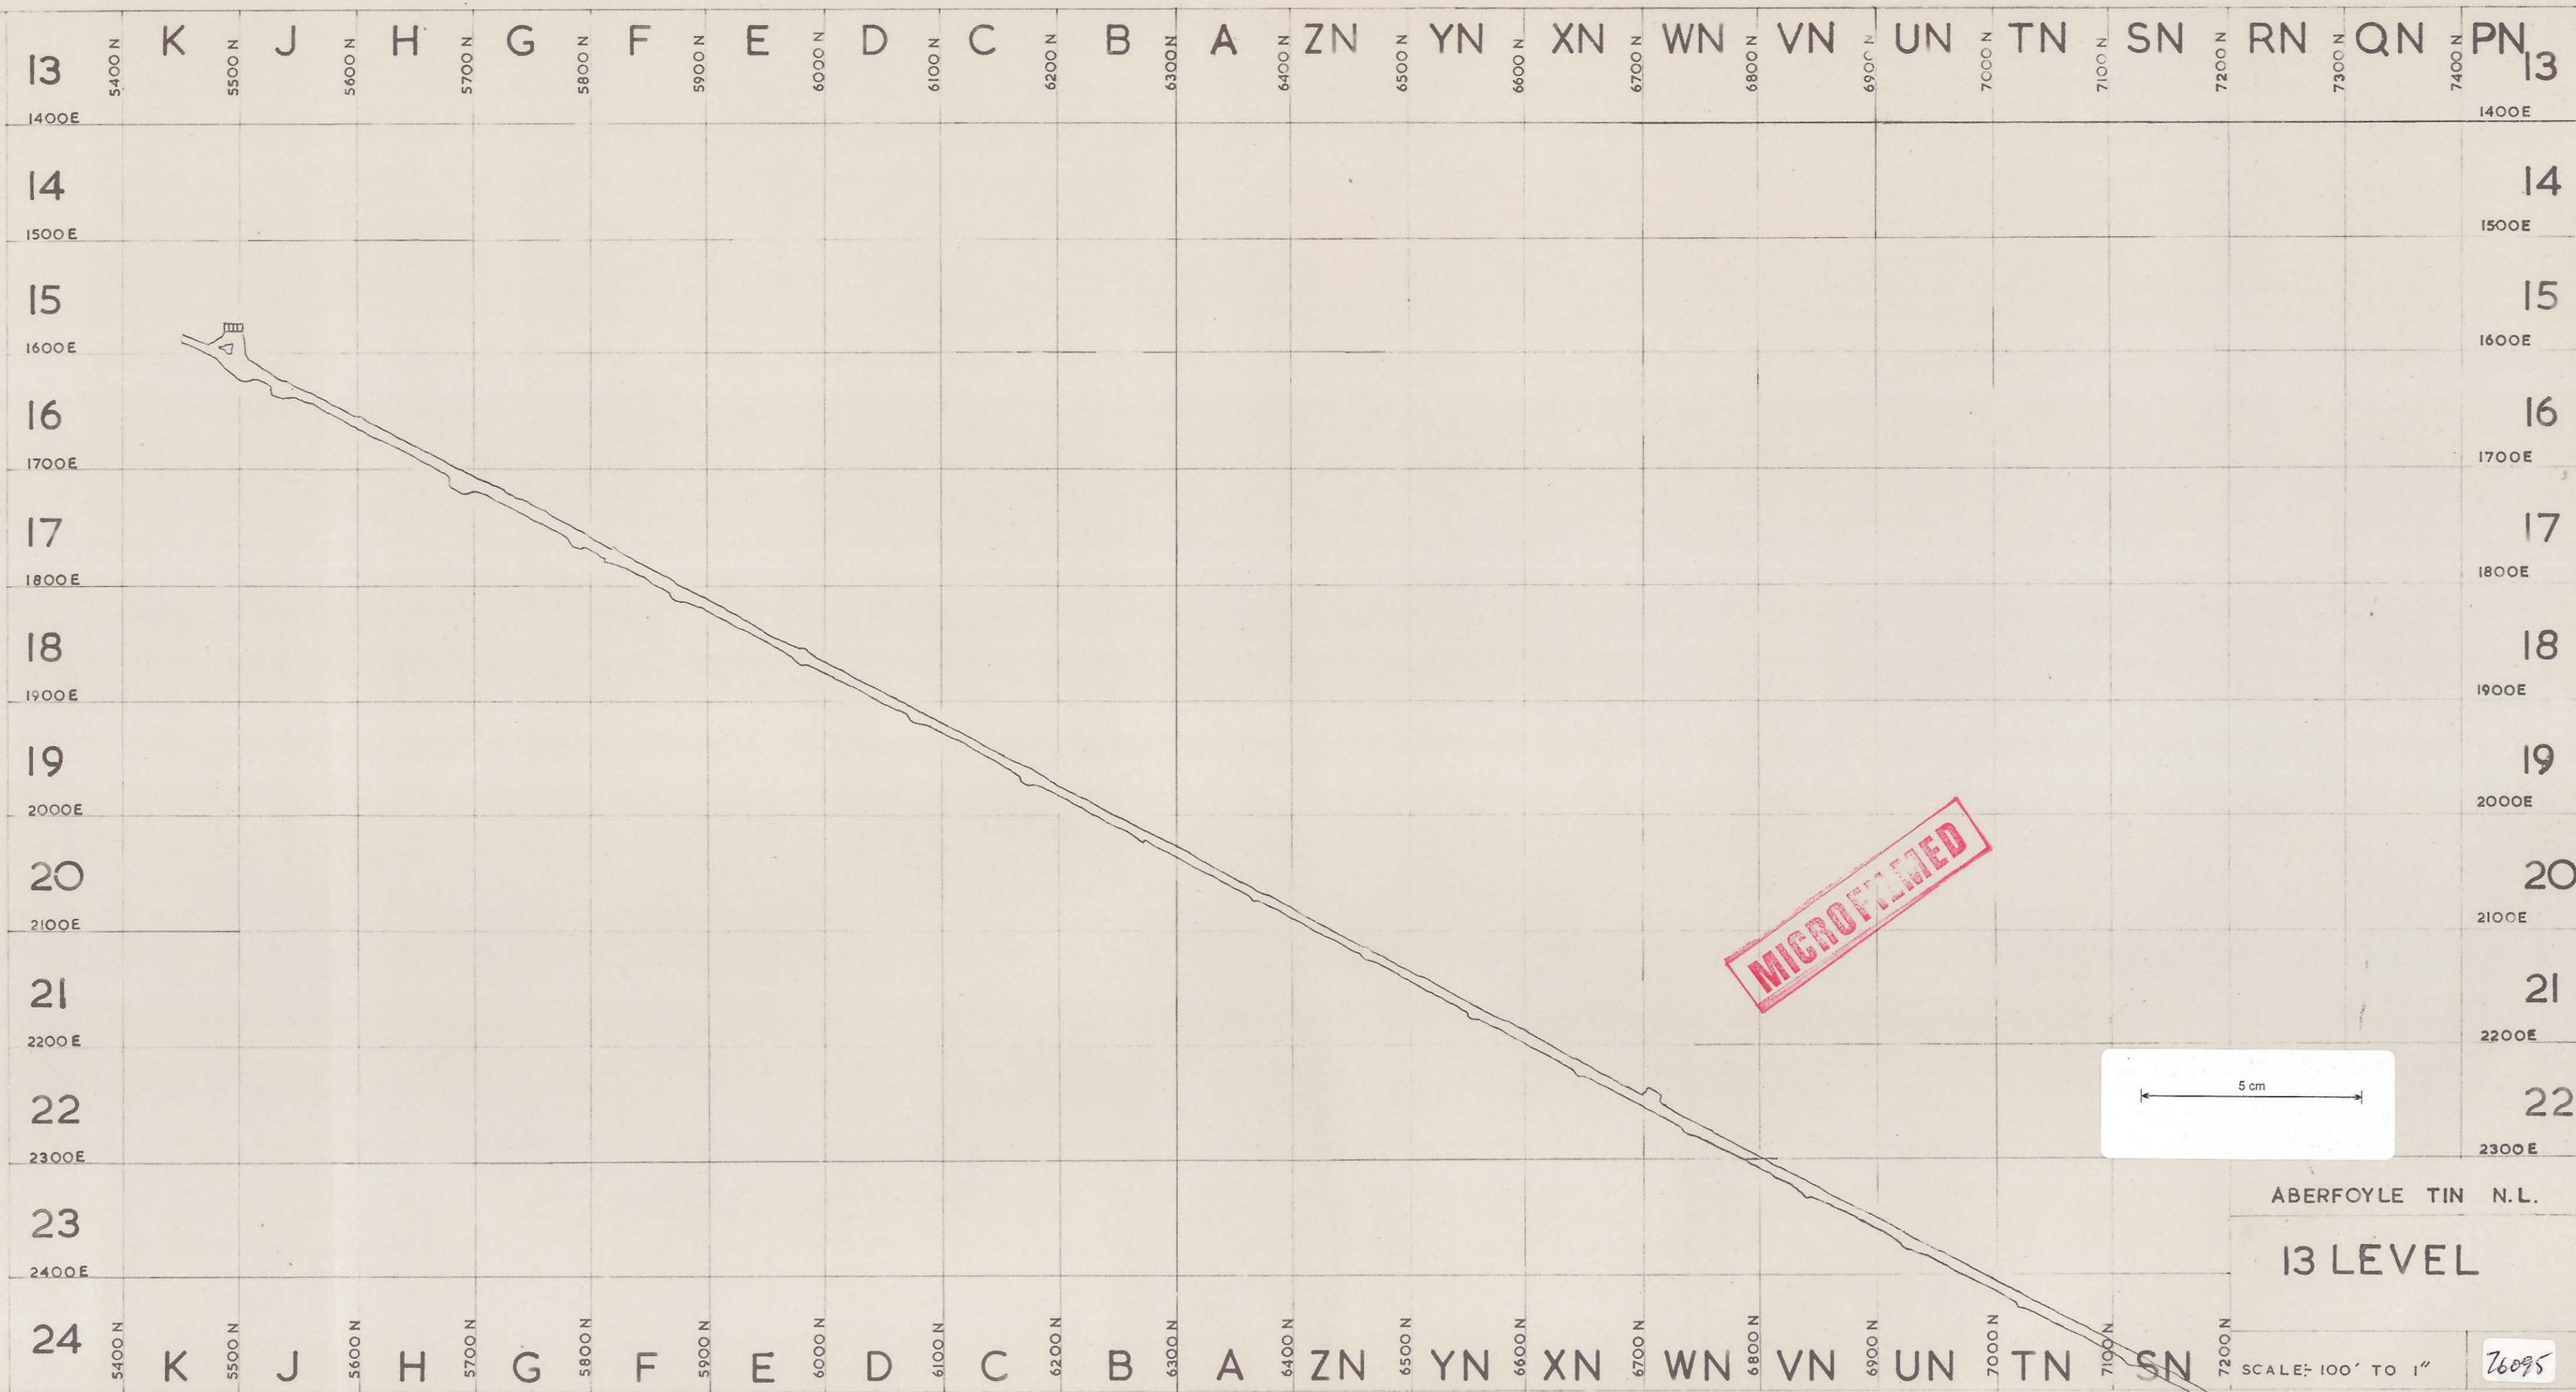

MICROFILMED

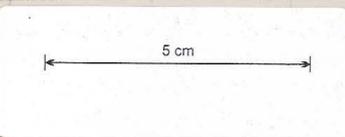

ABERFOYLE TIN N.L.
13 LEVEL

SCALE: 100' TO 1"

76095