


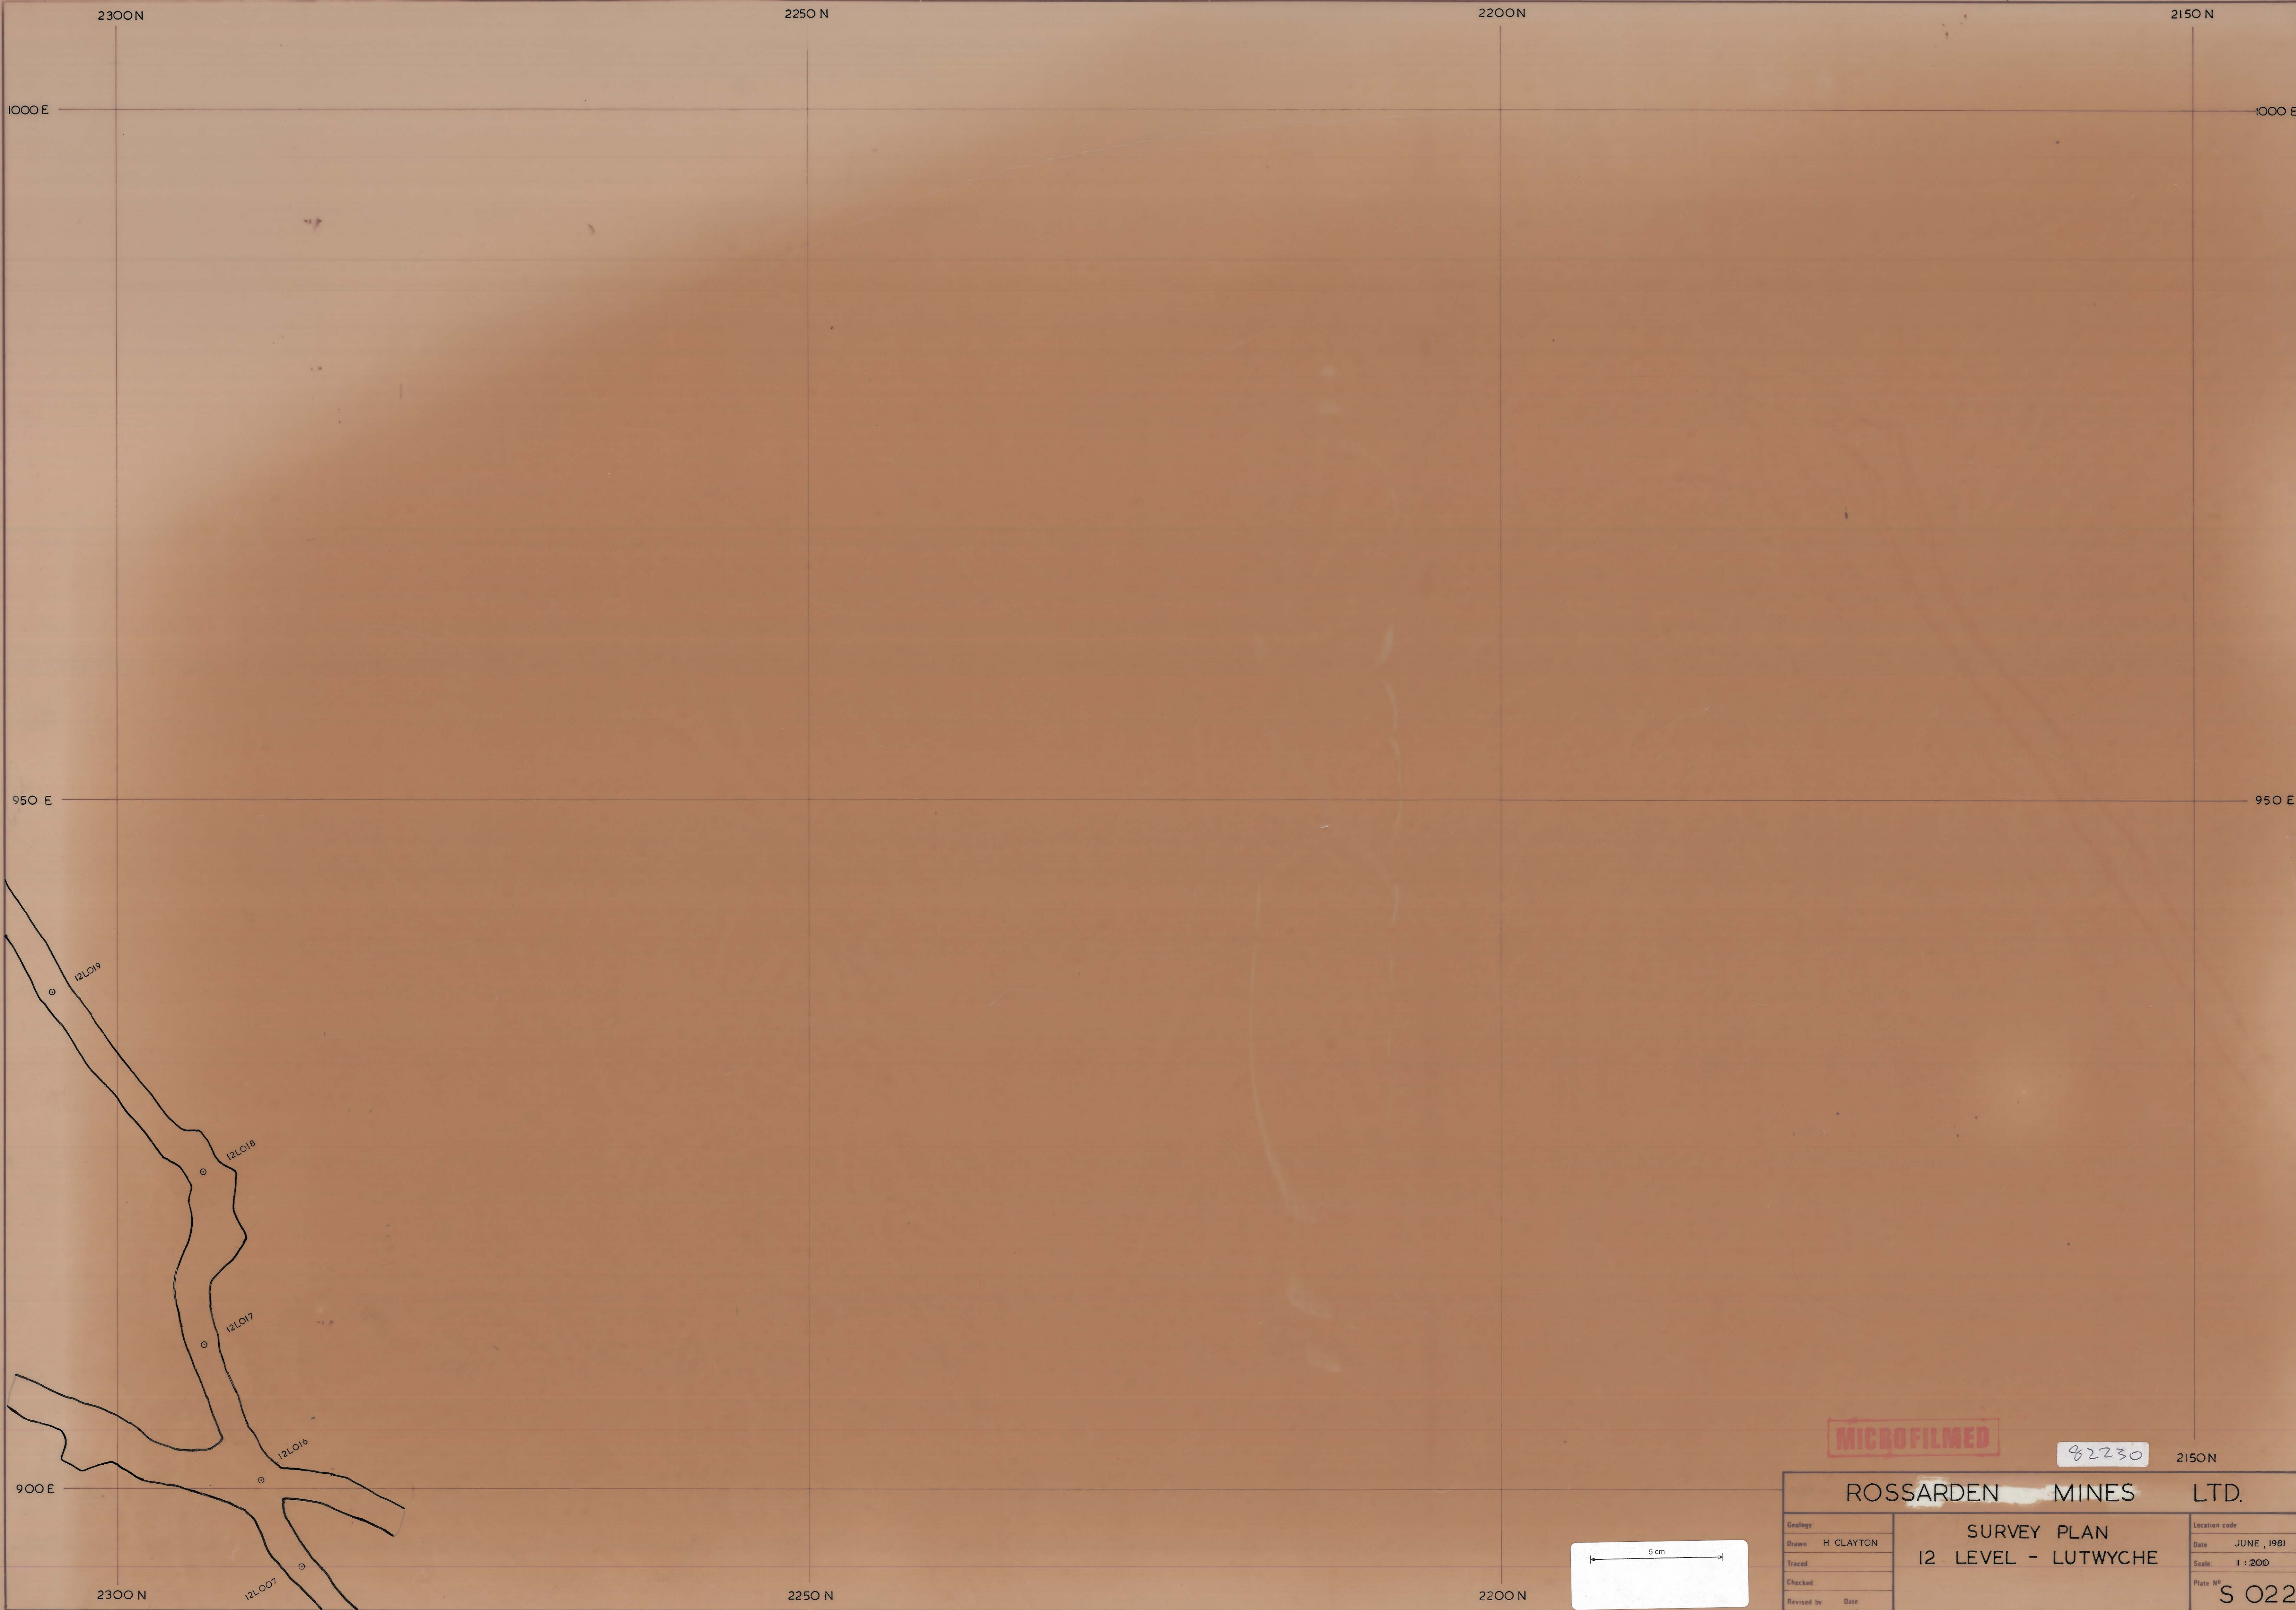

ABER-607

MICROFILMED

82230

ROSSARDEN MINES LTD.

Geology
Drawn H CLAYTON
Traced
Checked
Revised by Date

SURVEY PLAN
12 LEVEL - LUTWYCHE

Location code
Date JUNE, 1981
Scale 1 : 200
Plate No S 022