


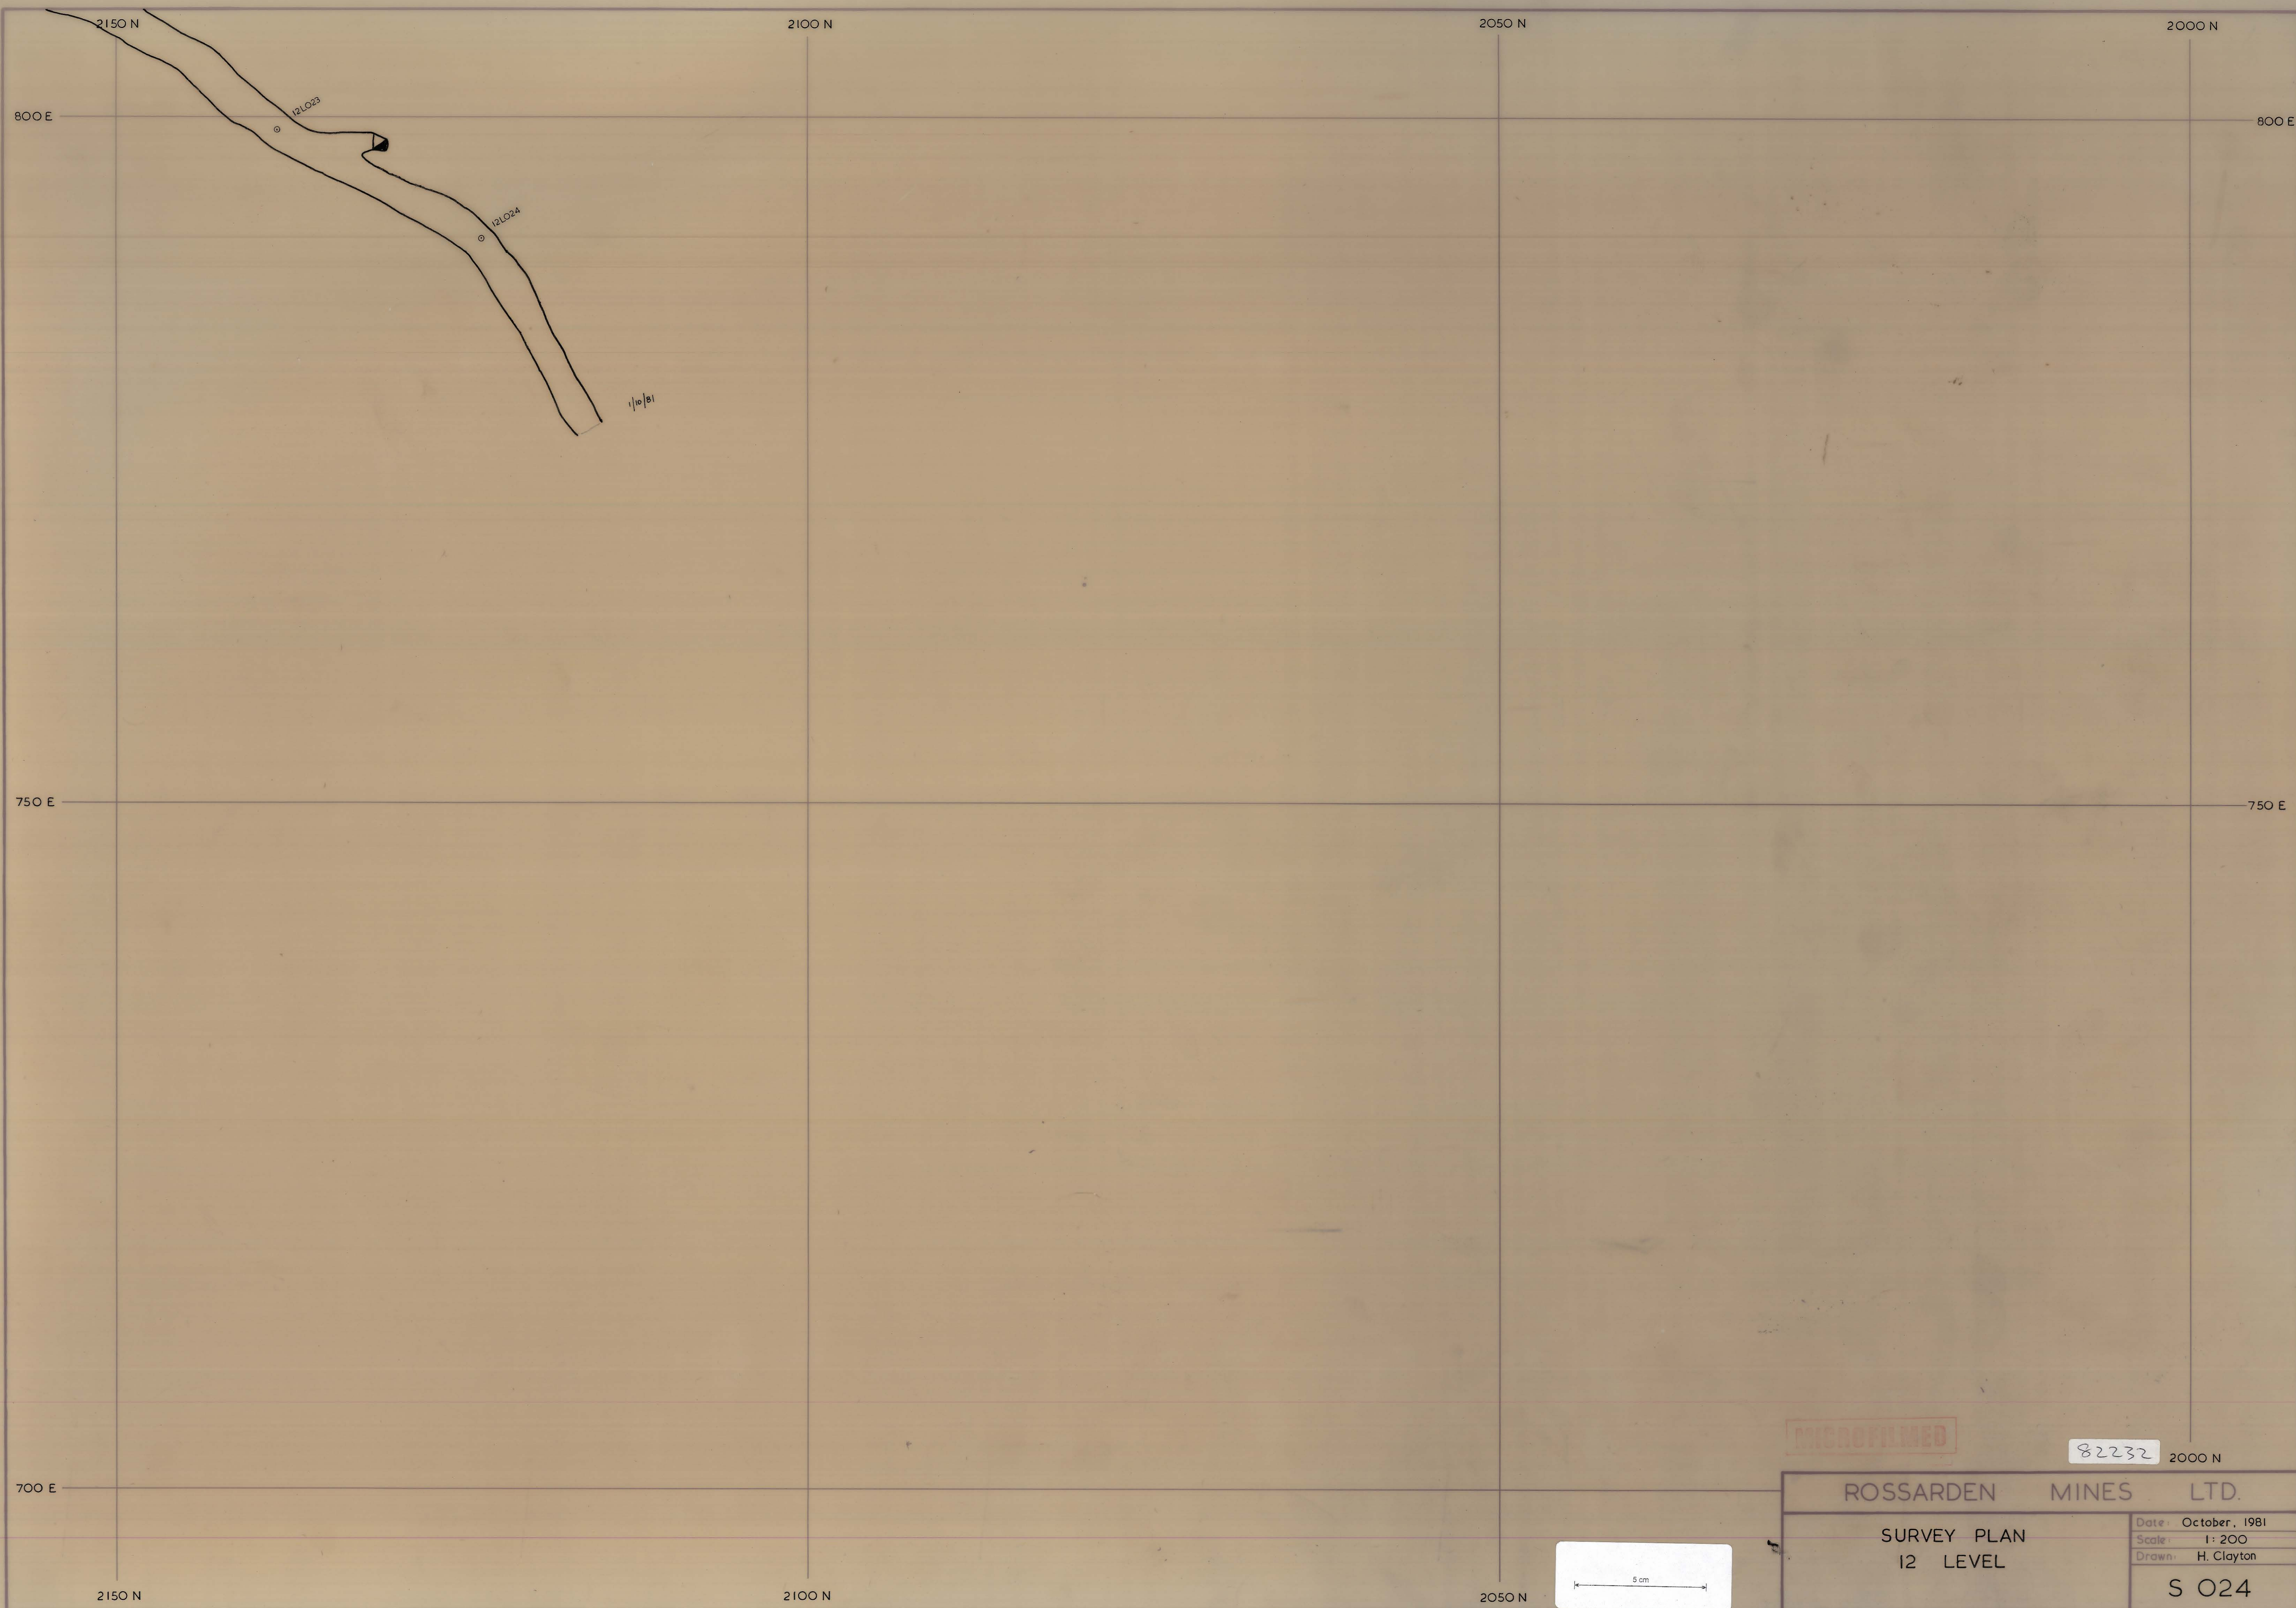

ABERN-609