


ABERF-623

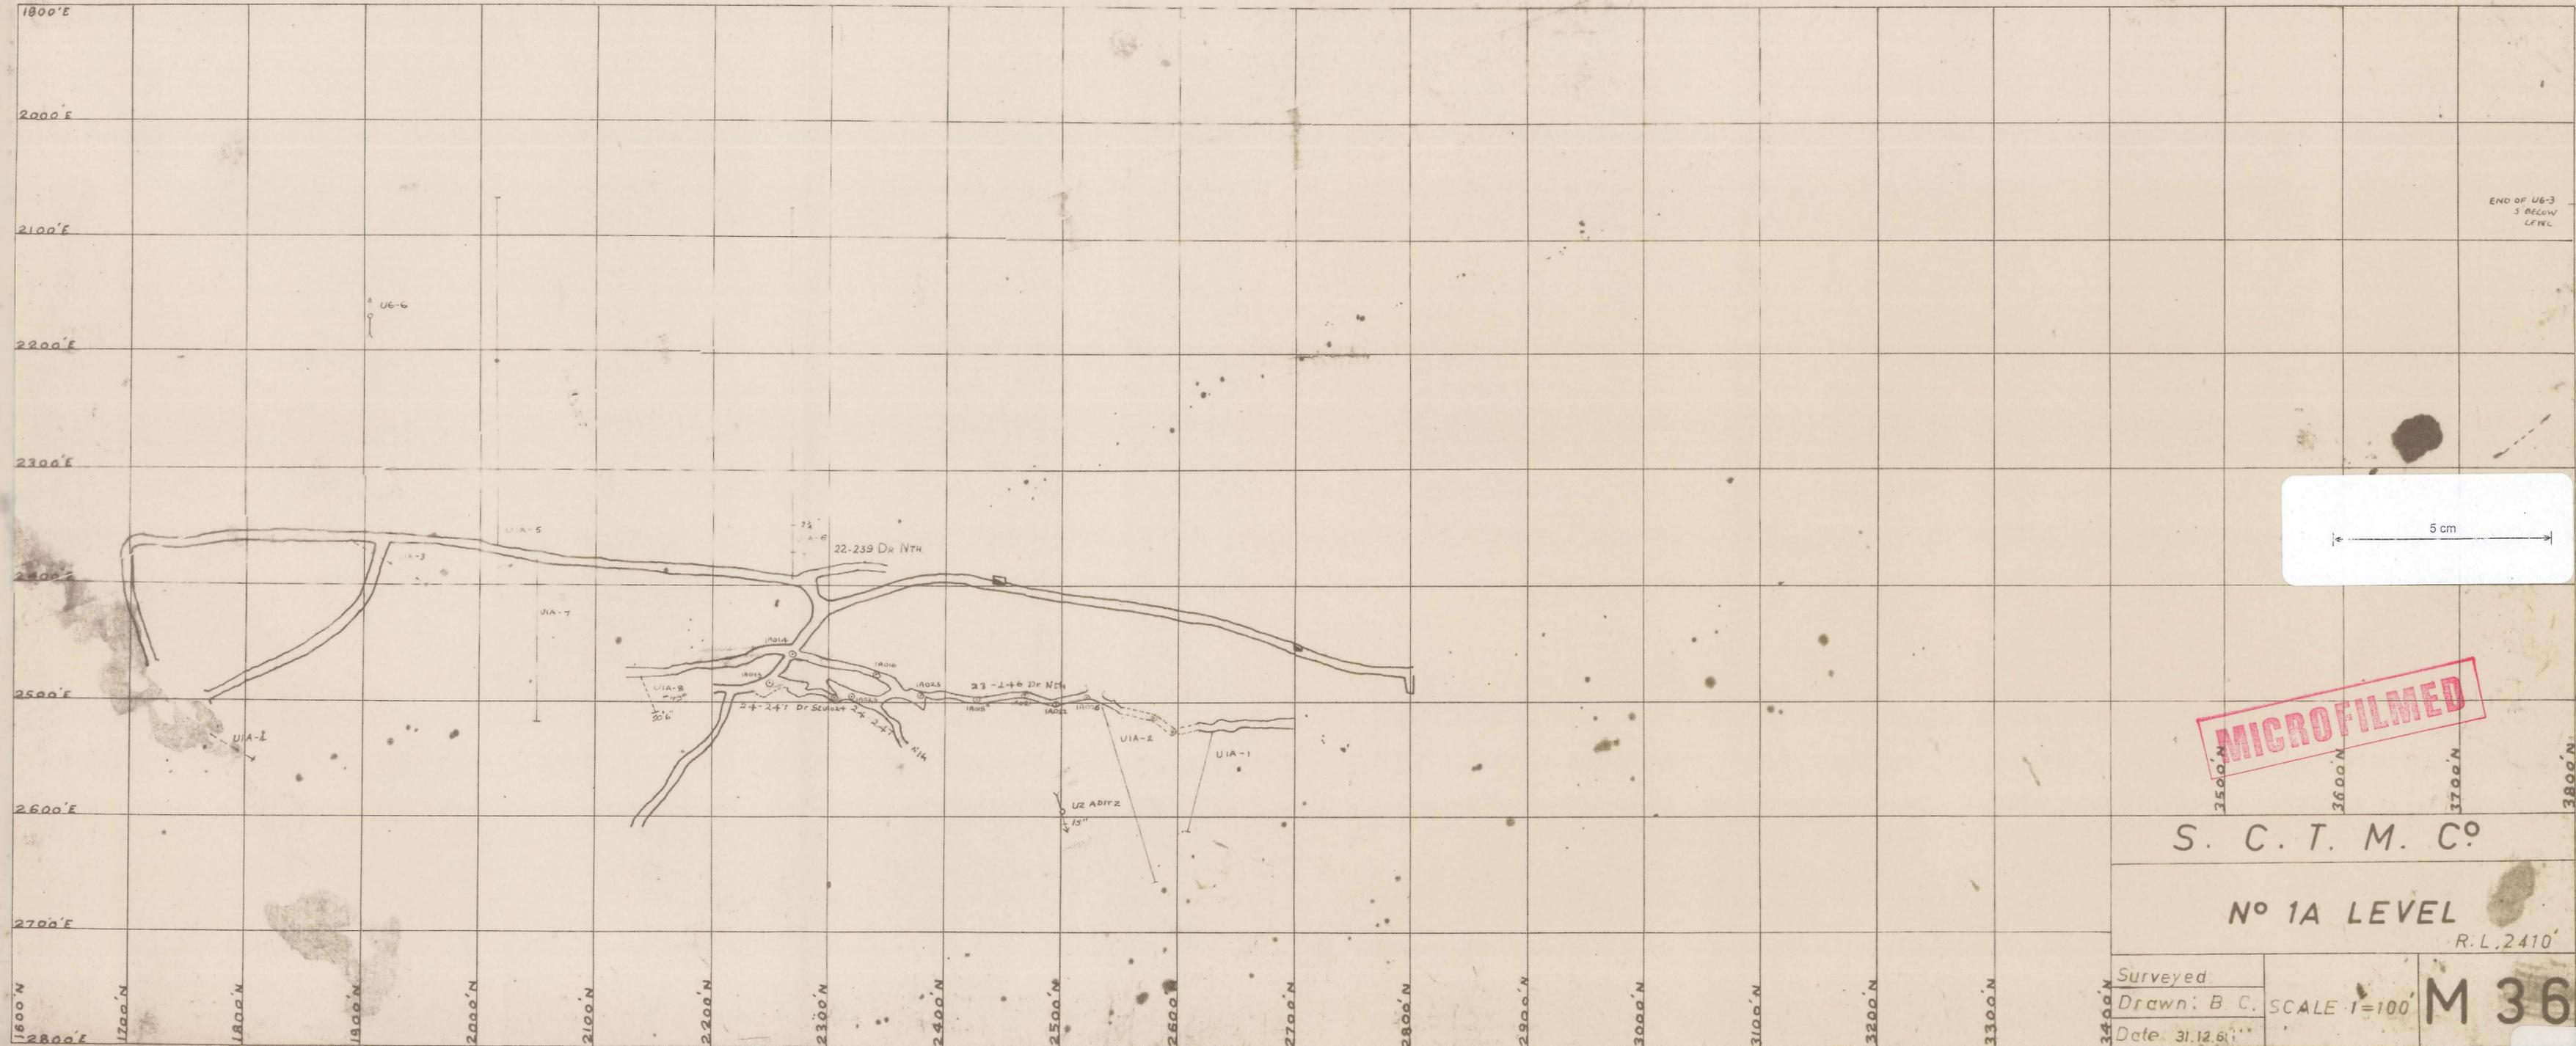

MICROFILMED

S. C. T. M. CO.

No 1A LEVEL

R.L. 2410'

Surveyed	SCALE 1=100'	M 36
Drawn: B. C.		
Date: 31.12.51		

XX008