


ABERF - 627

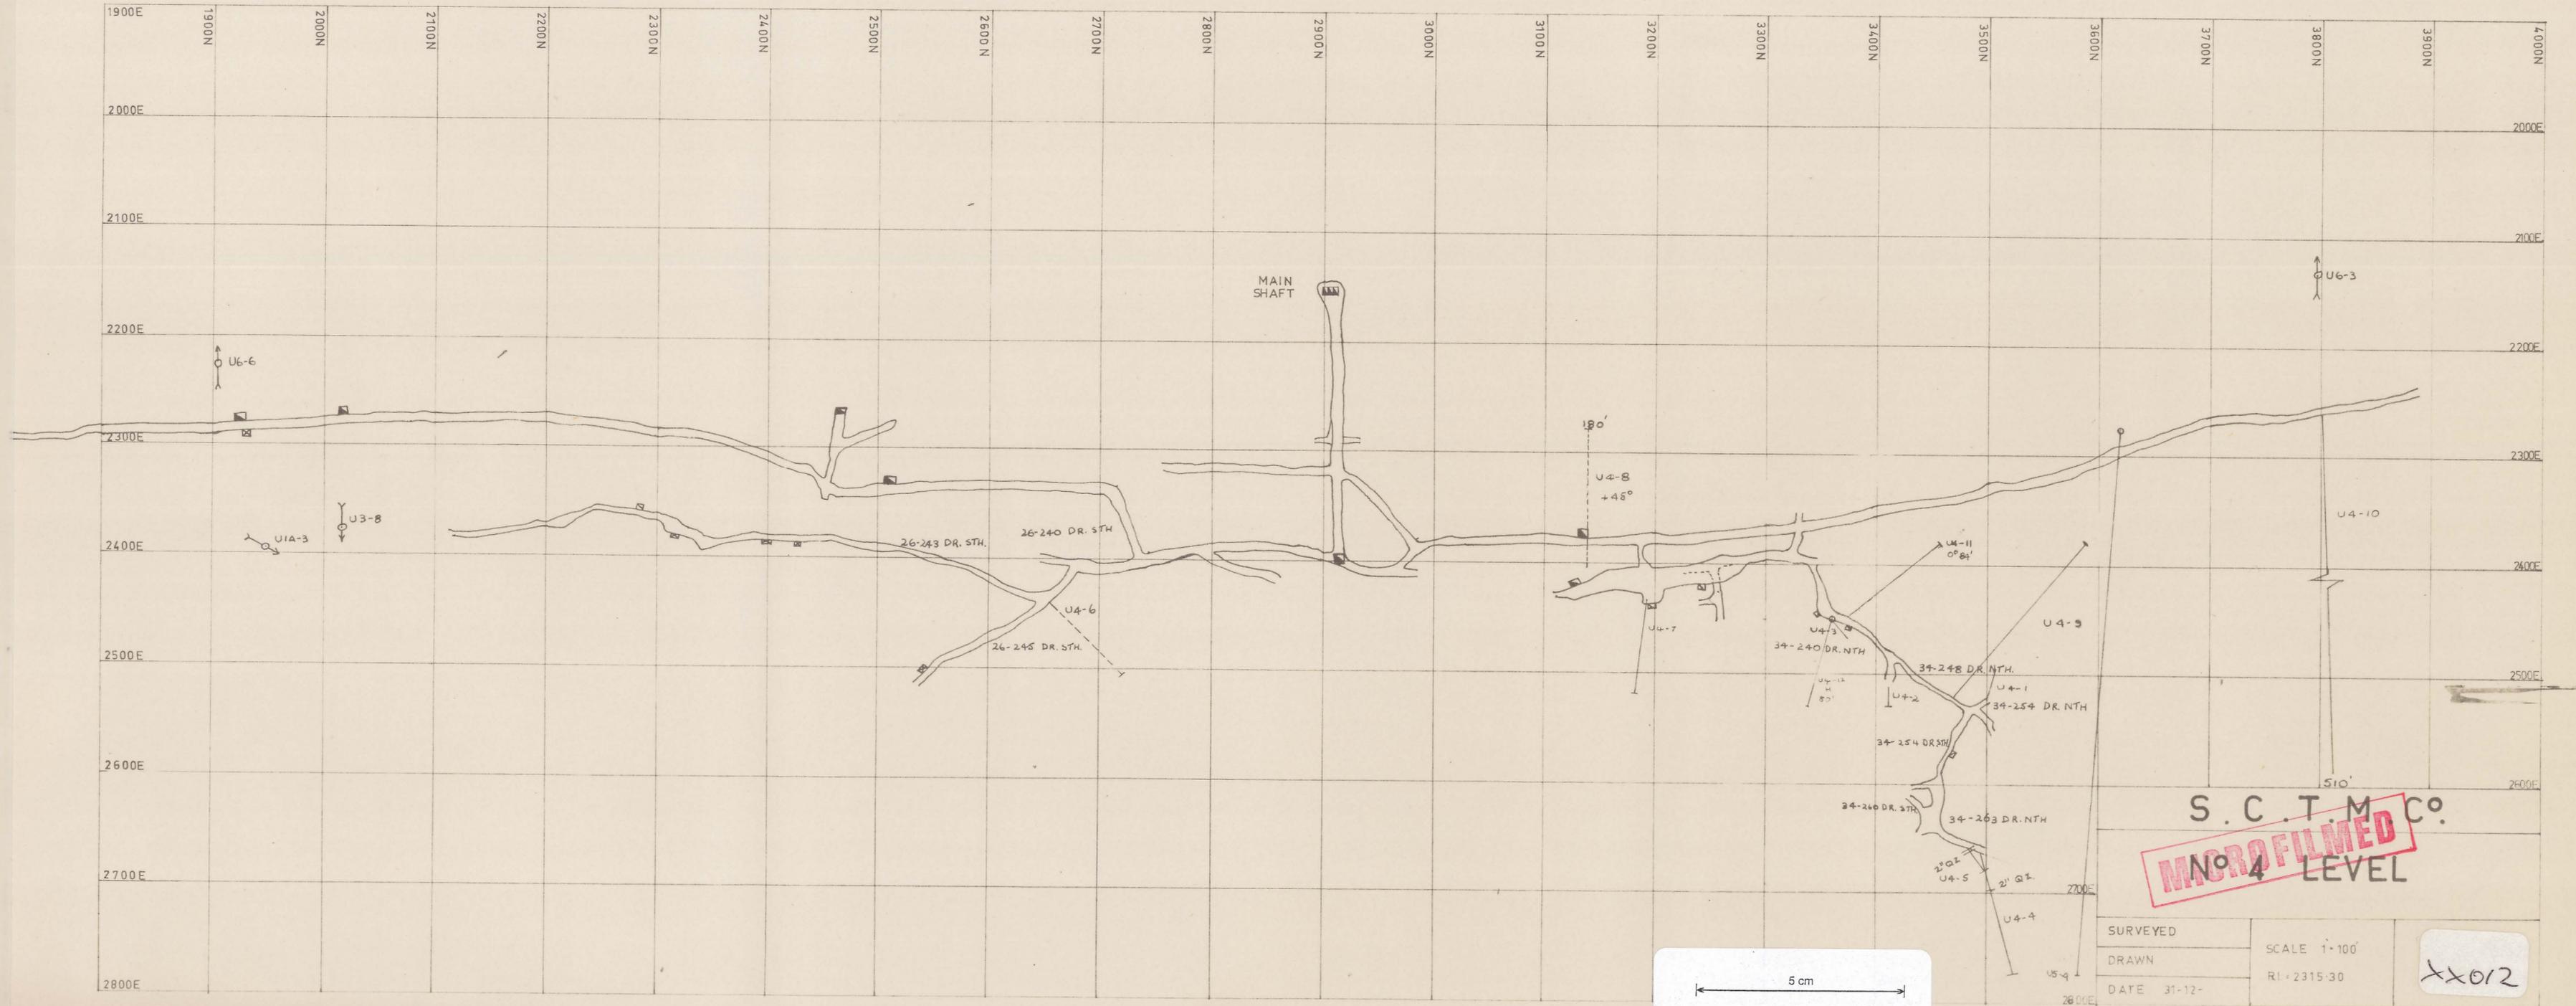

S.C.T.M. CO.  
**NO 4 LEVEL**

SURVEYED	SCALE 1"=100'
DRAWN	RI-2315-30
DATE 31-12-	

XX012