


ABERF-628

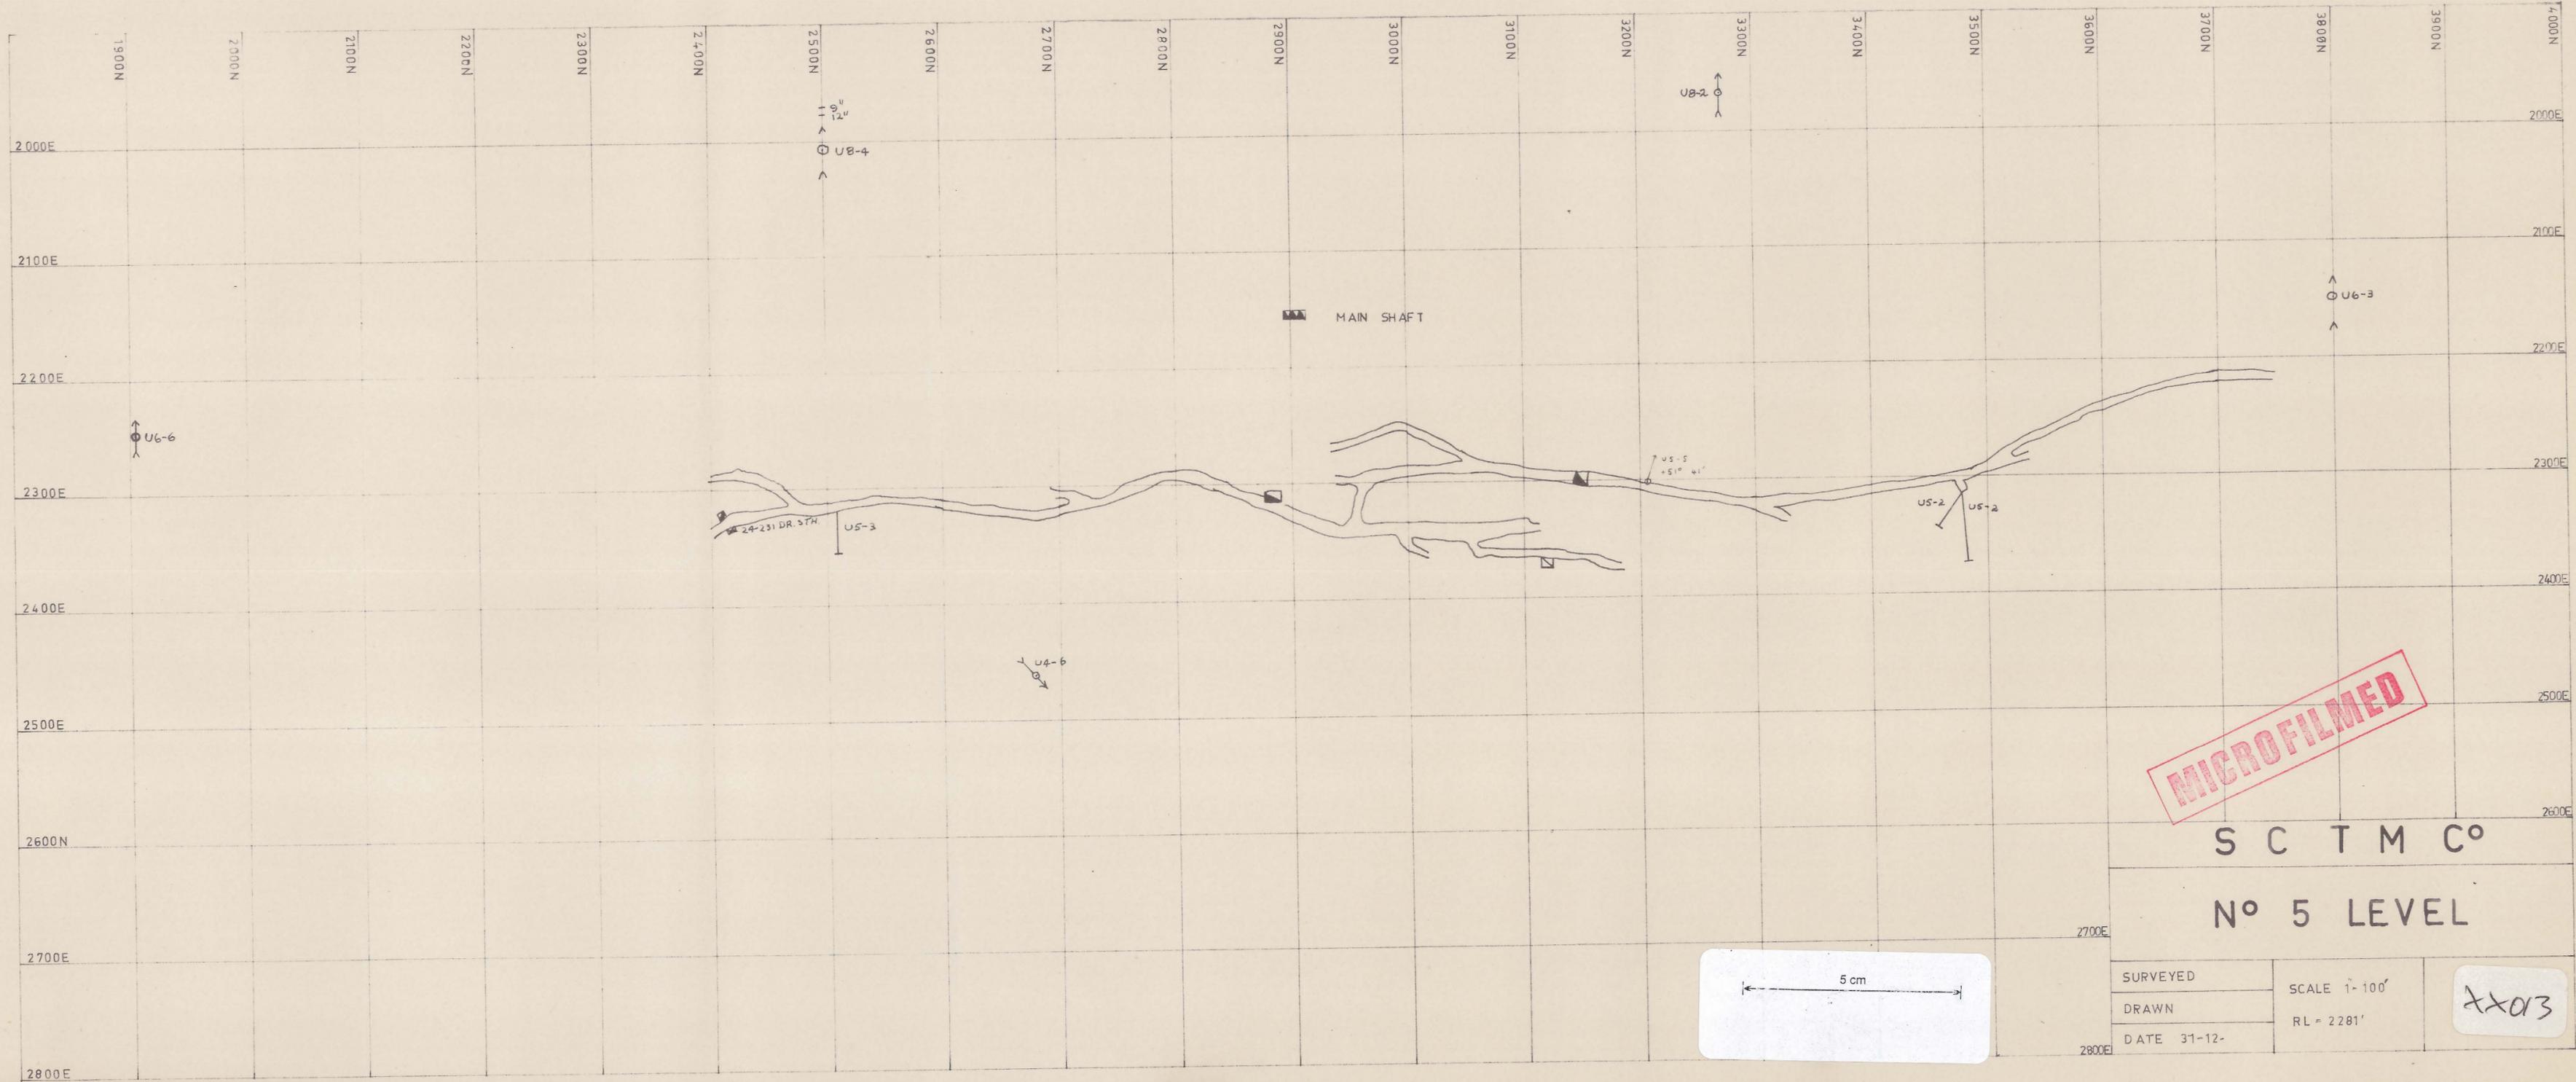

MICROFILMED

S C T M C^o
N^o 5 LEVEL

5 cm

SURVEYED	SCALE 1"=100'	XX013
DRAWN	RL = 2281'	
DATE 31-12-		