



ABERF - 630

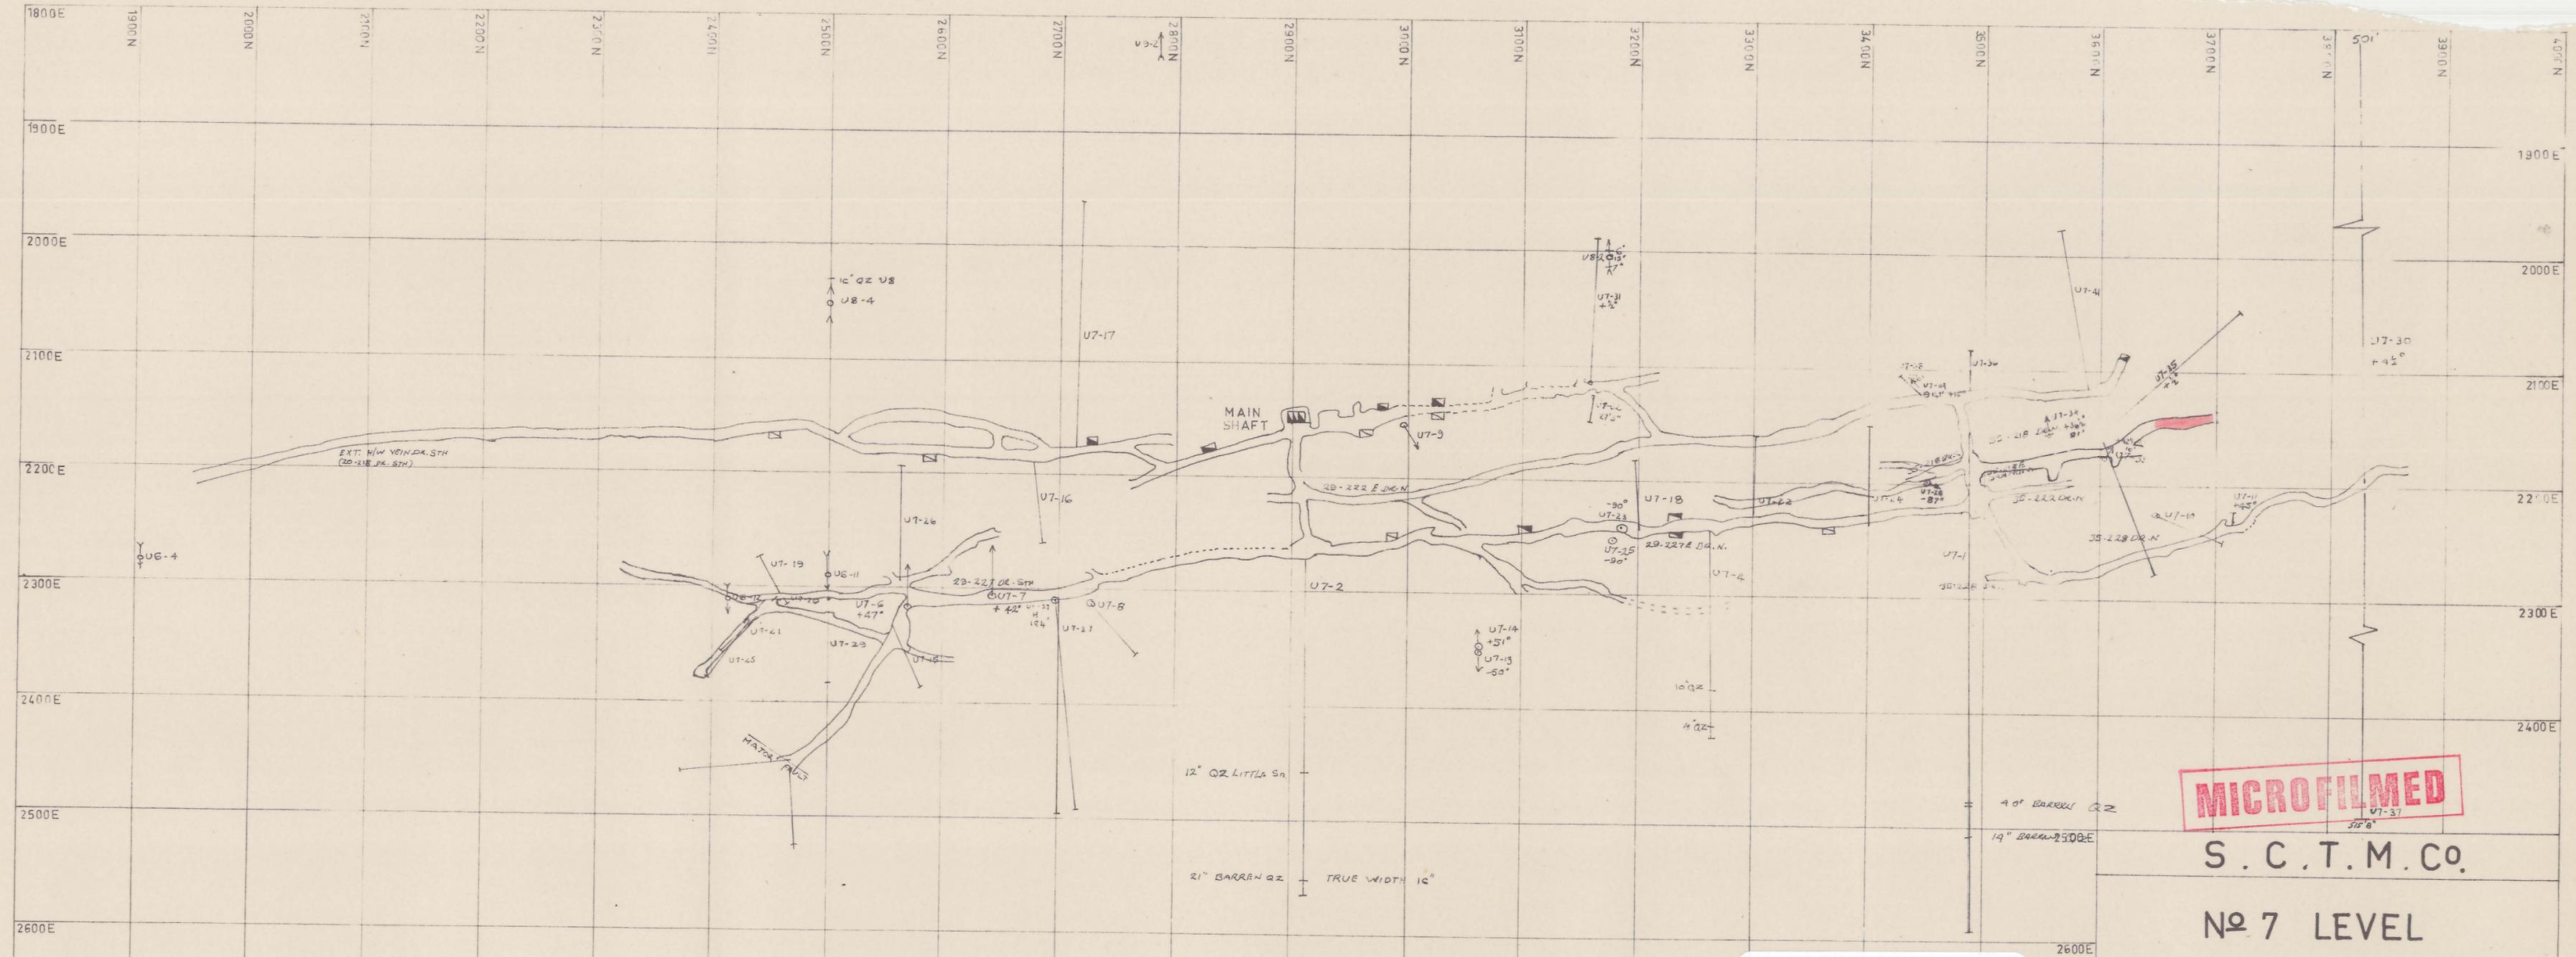

MICROFILMED

S. C. T. M. CO.

No 7 LEVEL

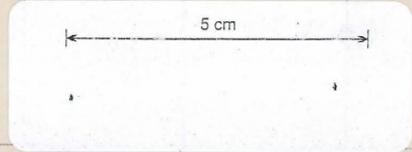

SURVEYED	SCALE 1"=100'
DRAWN	RL = 2216-69
DATE 31-12-	

20
1105