


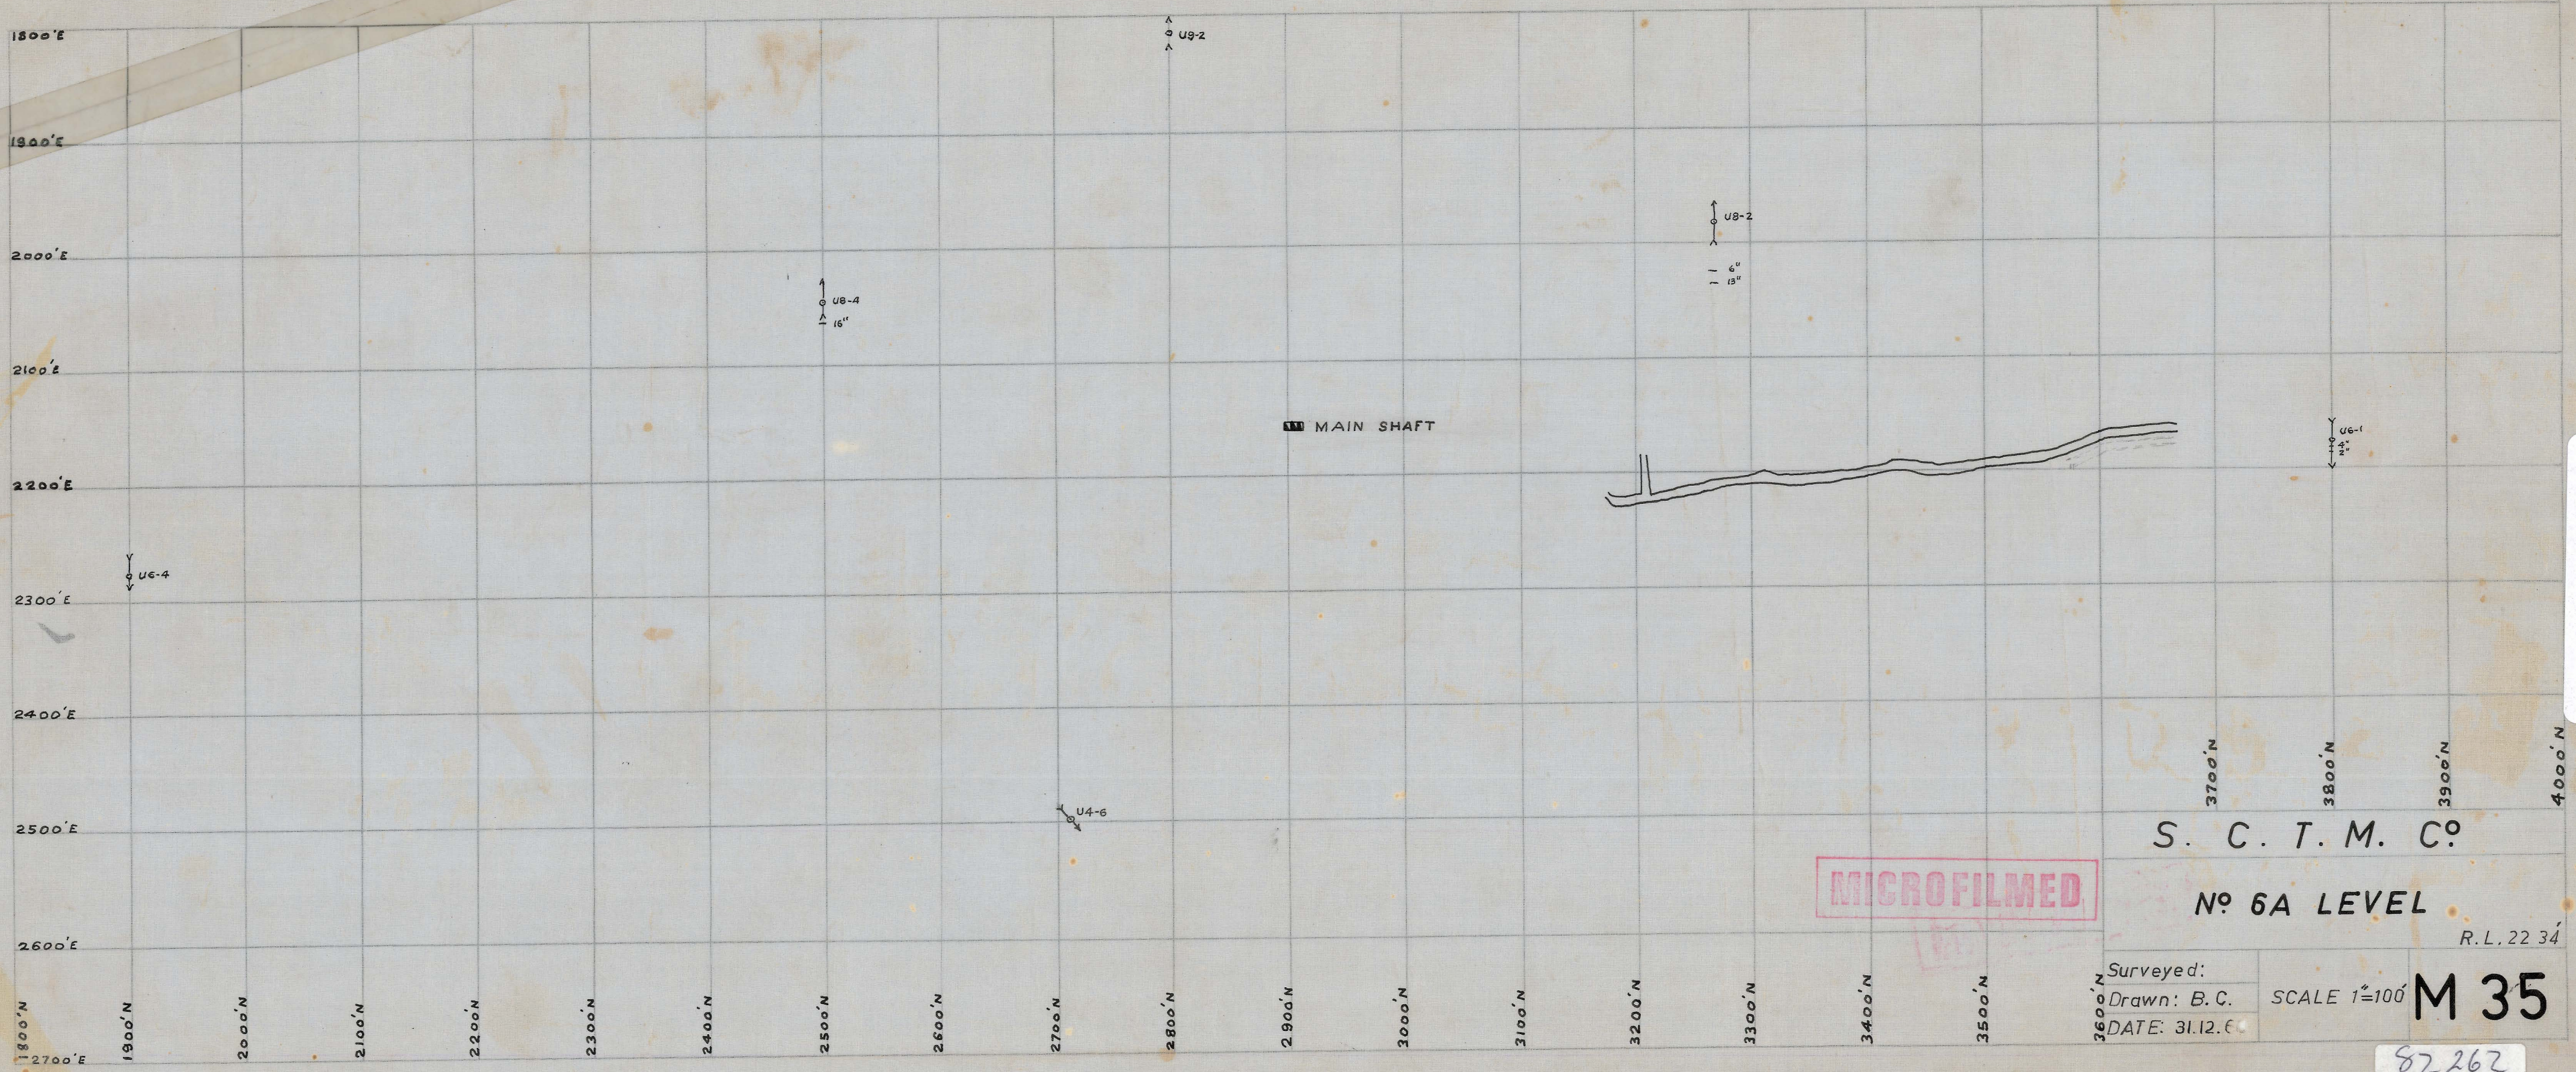

MICROFILMED

S. C. T. M. CO.
No 6A LEVEL

Surveyed:
Drawn: B. C.
DATE: 31.12.60

SCALE 1"=100'

M 35

82262

5 cm

ABRAF-634